

From:
To: [Planning](#)
Subject: RE: Valley View, Golden Grove, Whitby, - NYM/2019/0398/FL
Date: 25 June 2019 14:27:43
Attachments:

NYMNP

25/06/2019

Importance: High

Please find attached additional information requested for above application:

- Location plan with red around outbuilding
- Tree survey

Thanks.


Kind Regards,

Gareth Reed
Director

www.reedstudio.co.uk

NYMNPA
25/06/2019

AMENDED

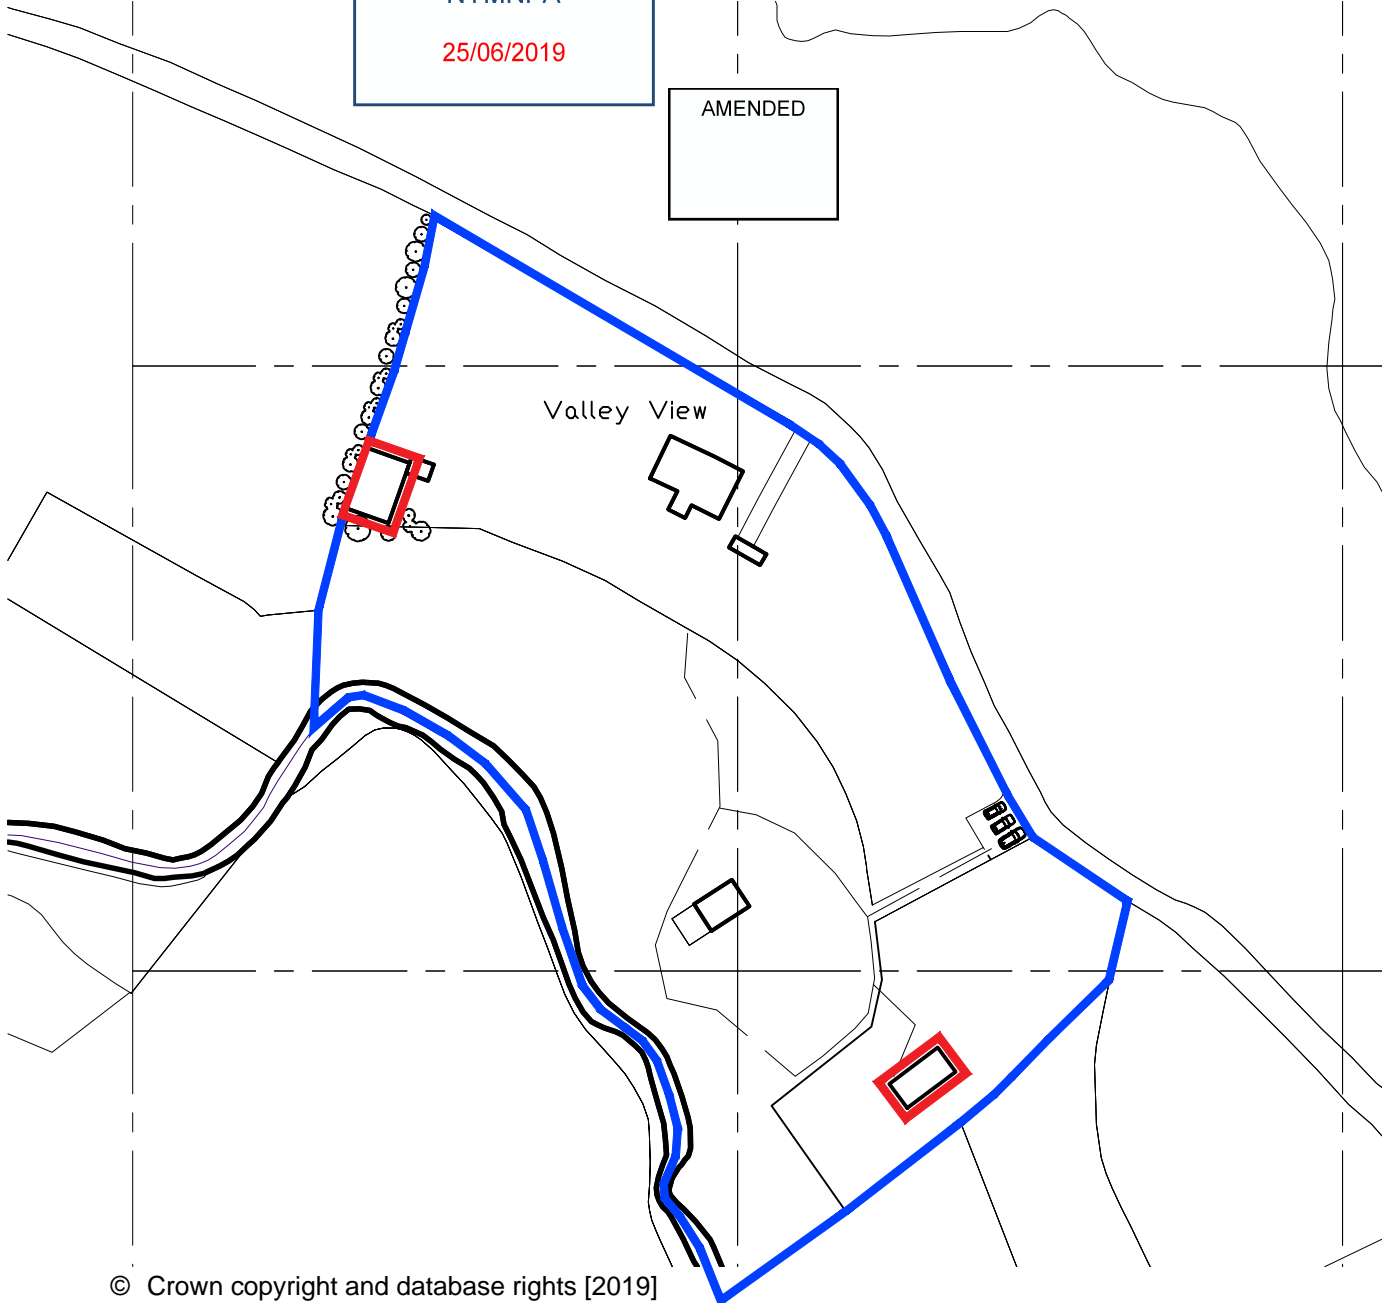

© Crown copyright and database rights [2019]
Ordnance Survey 0100031673

rev	date	description	drawn	checked
TP3	260619	Red line added to out building	GR	ER
TP2	110619	Red line boundary adjusted	GR	ER
TP1	310519	Town Planning Submission	GR	ER

dwg no.

job no. 01065

001

Valley View, Golden grove

Site Location Plan

Drawing Scale 1:1250 @ A4

Reed Studio | Keelham Cottage | Keelham Lane | OL14 8RX
©2019 do not scale from drawing report discrepancies immediately

**Reed
Studio**



Tree No.	Tree Species
T1, T3, T18, T35	Elm
T2, T30, T32, T34	Blackthorn
T4, T5, T6, T7, T9	Ash
T10, T11, T12, T13, T14	
T17, T19, T21, T27, T28	
T29, T31, T33	
T15, T16, T20, T22	Hawthorn
T23, T25, T26	Oak
T8	
T24	
T24	Hazel

