
From: Victoria Hill
Sent: 04 December 2019 11:35
To: Rob Smith
Cc: William Woods; Angela Samuels
Subject: Ladycross 96A Non-Material Amendment

Good morning Rob,

Please find attached the Section 96A Non-Material Amendment for Ladycross. If you have any questions or queries, please do not hesitate to contact us.

Kind regards,

Victoria Hill
Environmental Management Officer

Sirius Minerals Plc

A: Resolution House | Lake View | Scarborough | YO11 3ZB

www.siriusminerals.com

 siriusminerals.com    

 poly4.com  

Documents Transmittal

North Yorkshire Polyhalite Project



To: NYM - National Park Authority

NYMNPA,
The Old Vicarage,
Bondgate,
Helmsley,
York,
YO62 5BP

From: Sirius Minerals

Attention:

Created By: Hill, Victoria

Description:

Transmittal No: SMP-NPA-TR-0031

Date Issued: 04-Dec-2019

Document ID	Title	Revision	Format	Action Type
40-SMP-LC-8600-LP-31-00001	LADYCROSS 96A NON-MATERIAL AMENDMENT	1	EL	Issued for Information

Acknowledged:

Date: _____ Sign: _____

NYMNPA
05/12/2019


Format: A0 - Paper; A1 - Paper; A2 - Paper; A3 - Paper; A4 - Paper; A4 + CD - Paper CD-ROM; CD - CD-ROM; DOC - Document; DVD - DVD-ROM; EL - Electronical format; PDF - PDF; V - Video;



- Platform/Car Park
- Drainage ponds
- Noise bund
- Haul road
- Site access
- Earthworks mound
- Extent of application area
- Site fence
- Existing public footpath
- Proposed footpath diversion
- Site clearance
- No development area

NYMNP
05/12/2019

AMENDED

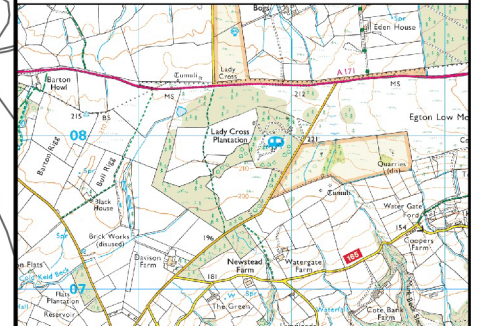

1	03/12/19	DR	RS	WW
Revision Description: Updated details in relation to footpath diversion				
0	22/11/19	DR	RS	WW
Revision Description:				
REV	DATE	BY	CHKD	APPD



Drawing Title: **Ladycross (96a) Non Material Amendment**

SCALE @ A3: 1:5,000

DRG No: 40-SMP-LC-8600-LP-31-00001

REV 1



No development to take place within this area

Point where the diverted footpath route meets the existing public footpath

Earthworks Mound

Existing Caravan Park

Proposed temporary footpath diversion (details to be agreed with the local authority). Route of diverted path to run immediately outside the site fence.

Drainage Pond

No development to take place within this area

Haul Road

Temporary Car Park & Welfare

Temporary Platform

Temporary Laydown Area


Drainage Pond

Point where the diverted footpath route meets the existing public footpath

Temporary stockpile area for material generated during night time periods

Shaft position

Existing public footpath is to be temporarily diverted around the site during construction works

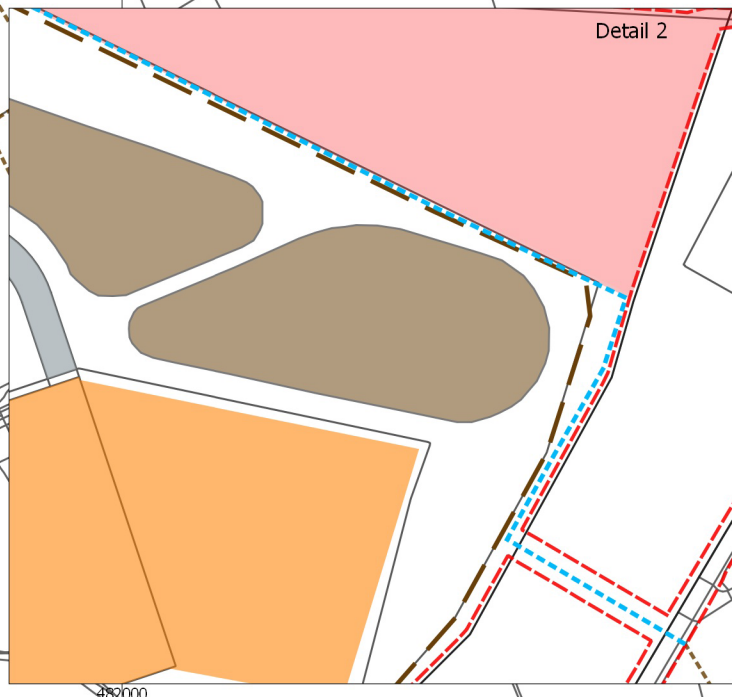

- 1. Reviewed - Accepted - Work May Proceed
- 2. Reviewed - Accepted As Noted, Work May Proceed, Revise & Resubmit
- 3. Reviewed - Work May Not Proceed, Revise & Resubmit
- 4. For information only
- 5. On Hold - Pending Project Restart & Ramp Up

By: Staniland, Robert
On: 04 Dec 2019 12:24

