
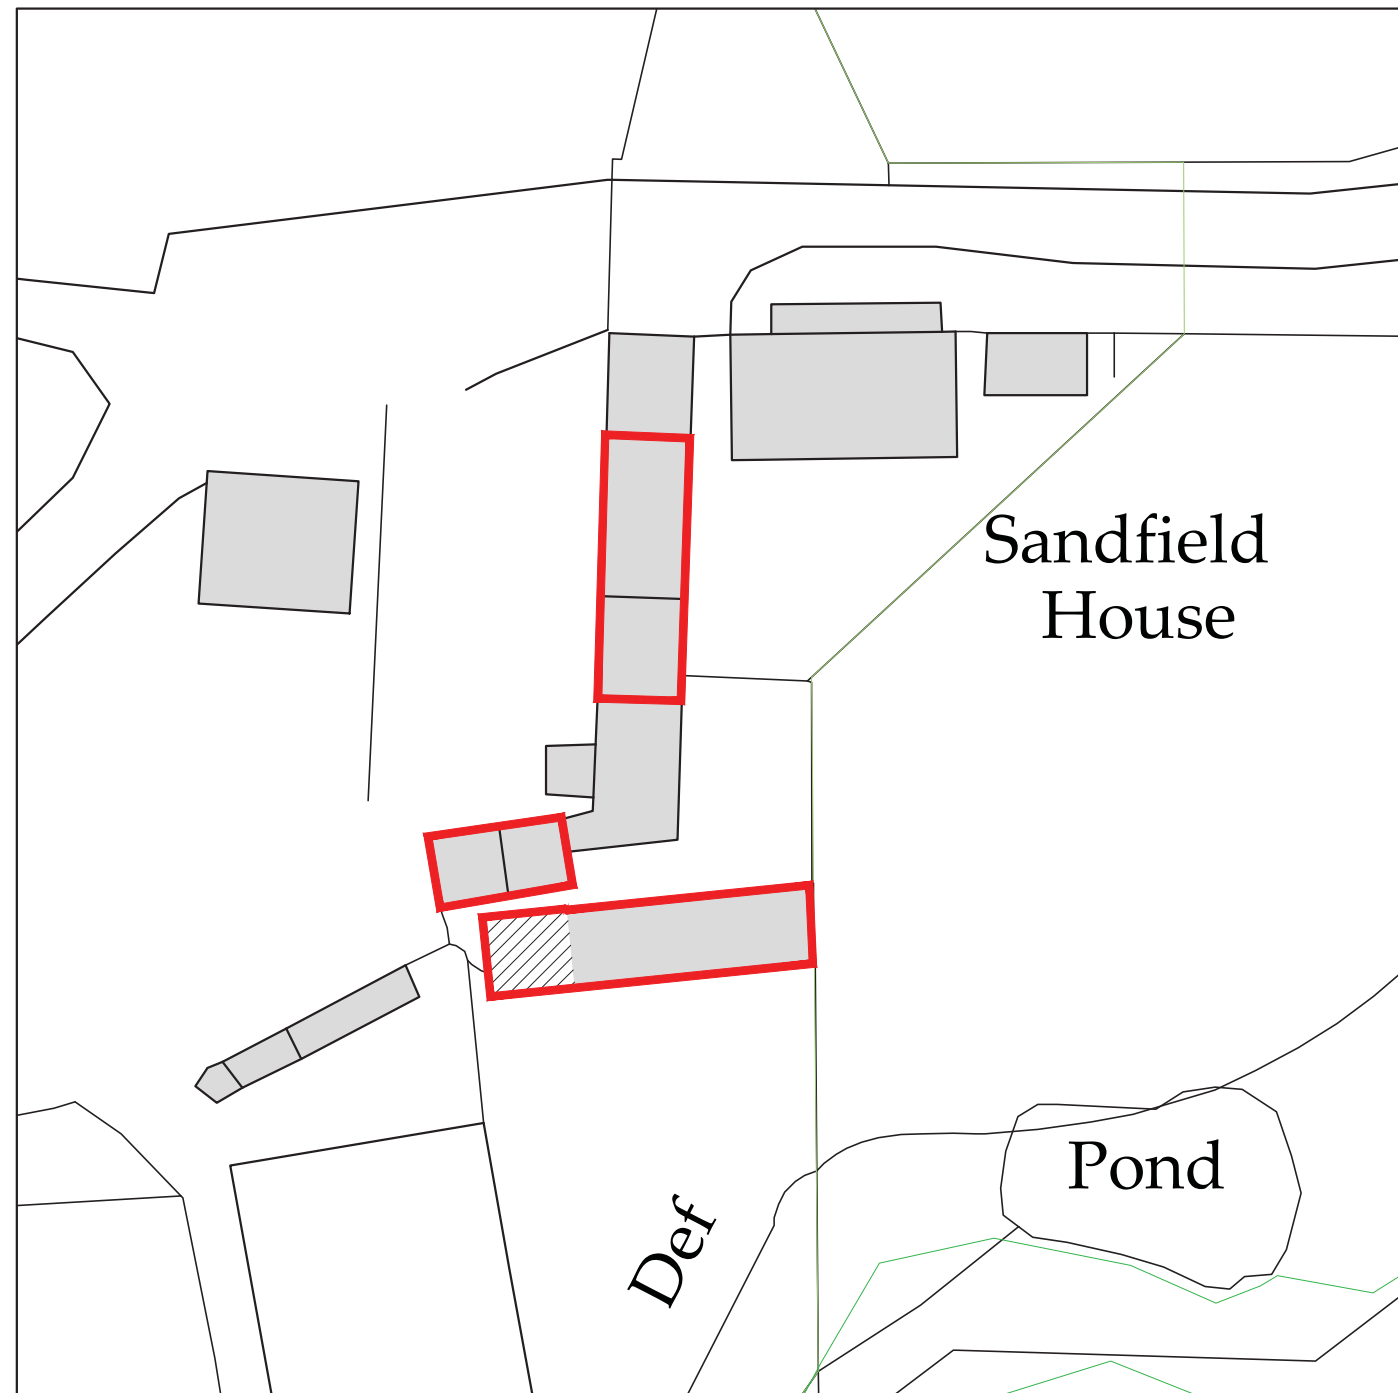


---

**From:** Neil Duffield  
**Sent:** 20 January 2021 11:14  
**To:** Megan O'Mara  
**Subject:** RE: NYM/2020/0782/FL and 2020/0781

Hi Megan,  
Well spotted.  
Location and Block now correct  
Kind regards  
Neil

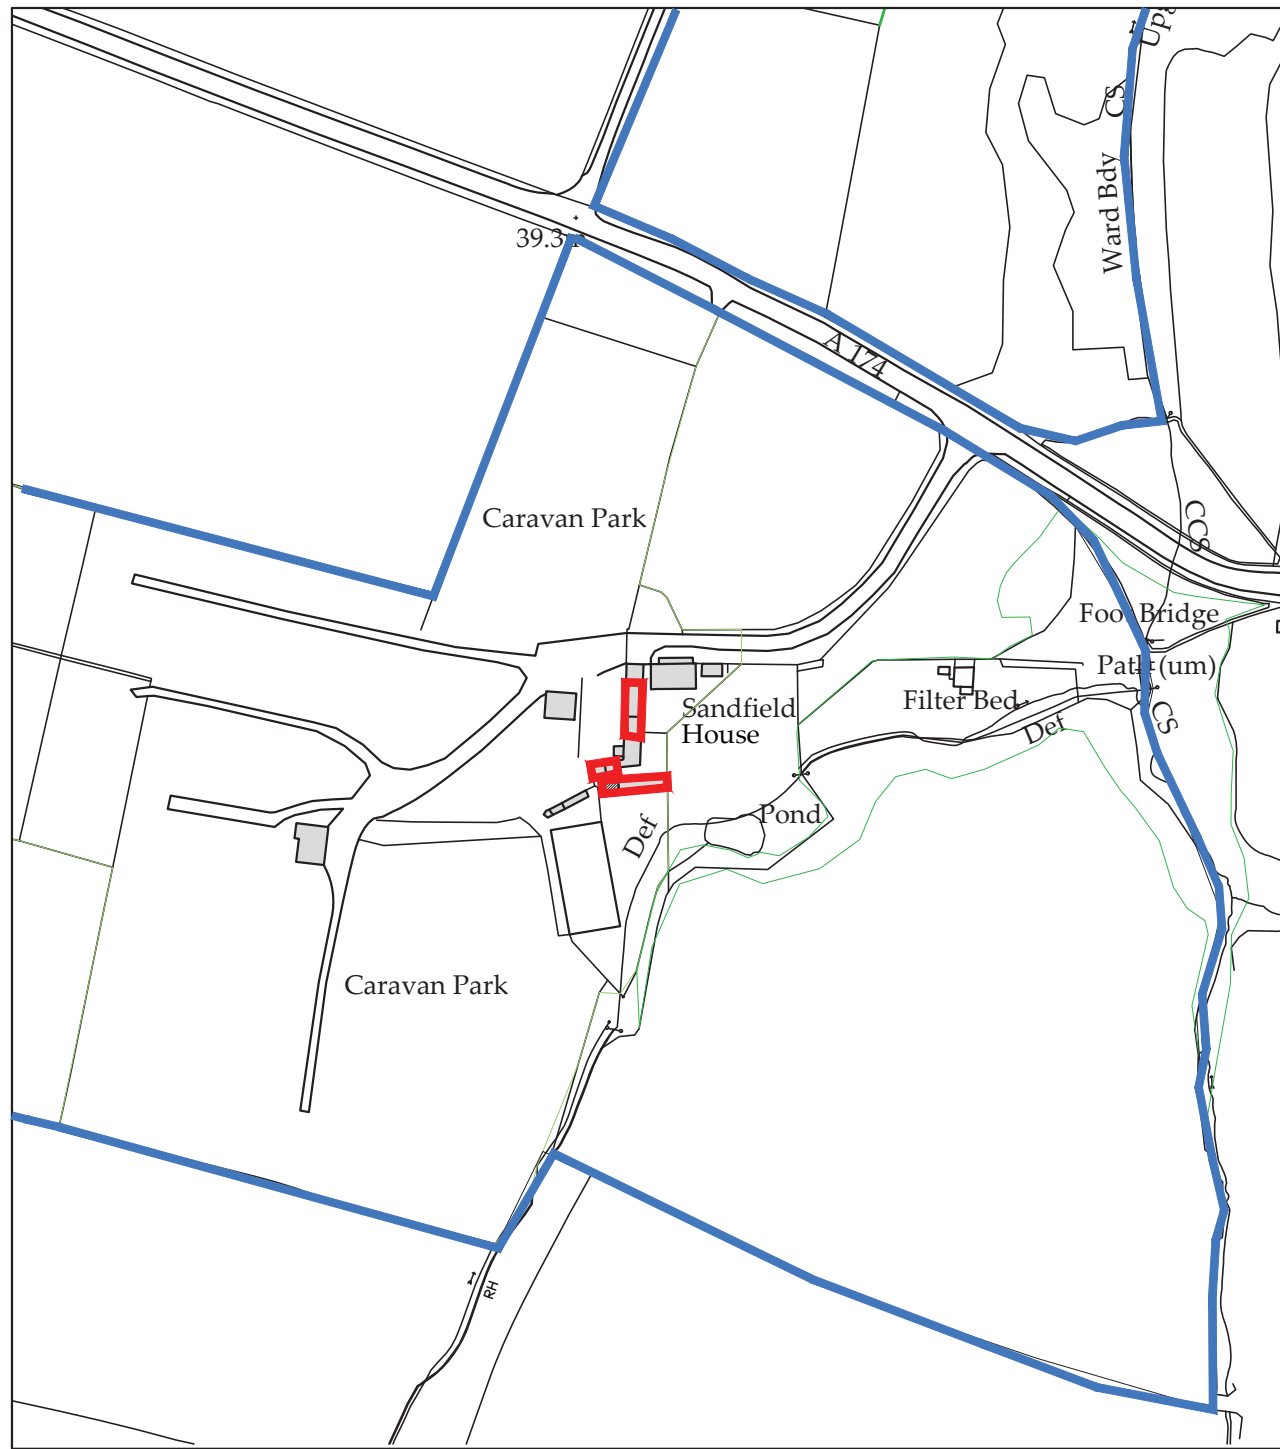

Location Plan  
Scale 1:2500

NYMNPA  
20/01/2021

AMENDED

Block Plan  
Scale 1:500

Ordnance Survey Licence No. 100002562

**b h d partnership**

Airy Hill Manor, Whitby, North Yorkshire, UK, YO21 1QB.

●DO NOT SCALE from this drawing. Only figured dimensions are to be taken from this drawing.  
●The Contractor must verify all dimensions on site before commencing any work or shop drawings.  
The Contractor must report any discrepancies before commencing work. If this drawing exceeds the quantities taken in any way, the Technician is to be informed before work is initiated.  
Work within The Construction (Design and Management) Regulations 2015 is not to start until a Health & Safety Plan has been produced. This drawing is Copyright and must not be reproduced without consent of BHD Partnership Ltd

REV	DATE	BY	AMENDMENT	CHKD	APVD
B	23/12/21	nid	Red line corrected		
A	28/09/20	nid	Issued for approval		

CLIENT: <b>Sandfield House Farm Caravan Park</b>			
PROJECT: <b>Conversion of store and barns to 2No annexe's &amp; 3No Holiday Cottages</b>			
A3	DRN:	NID	DATE: 28/09/20
SCALE: As shown		ISSUE: Preliminary	

DRAWING TITLE: <b>Location Plan and Block Plan</b>	
DRAWING NR: <b>D11412-08</b>	REV: <b>B</b>