

From: Neil Duffield
Sent: 23 March 2021 14:50
To:
Cc: planning@northyorkmoors.org.uk
Subject: NYM/2021/0063/FL Flushing Meadows Egton E12014-08 Client rev dwgs

Hi Megan,

Please see attached the drawings for the above application amended to remove the external stair access. I hope these are as required and the approval can be granted. Any queries please let me know.


Kind regards
Neil



The information contained in this email is intended only for the person or entity to whom it is addressed and may contain confidential and/or privileged material. If you have received this email in error please note that any review, retransmission, copying, dissemination or other use of, or taking of any action in reliance upon its contents is prohibited. If you are not an intended recipient please delete the material from any computer that may have it and contact BHD Partnership IT Personnel on 01947 829317, thank you for your co-operation.


The contents of an attachment to this email may contain software viruses which could damage your computer system. We cannot accept liability for any damage which you sustain as a result of software viruses, you should carry out your own virus checks before opening any attachment.

BHD Partnership, Airy Hill Manor, Whitby, North Yorkshire, YO21 1QB
Tel: 01947 604871 Fax: 01947 600010 www.bhdpartnership.com

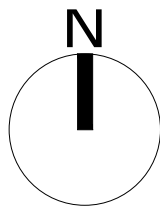


NYMNPA
23/03/2021

AMENDED

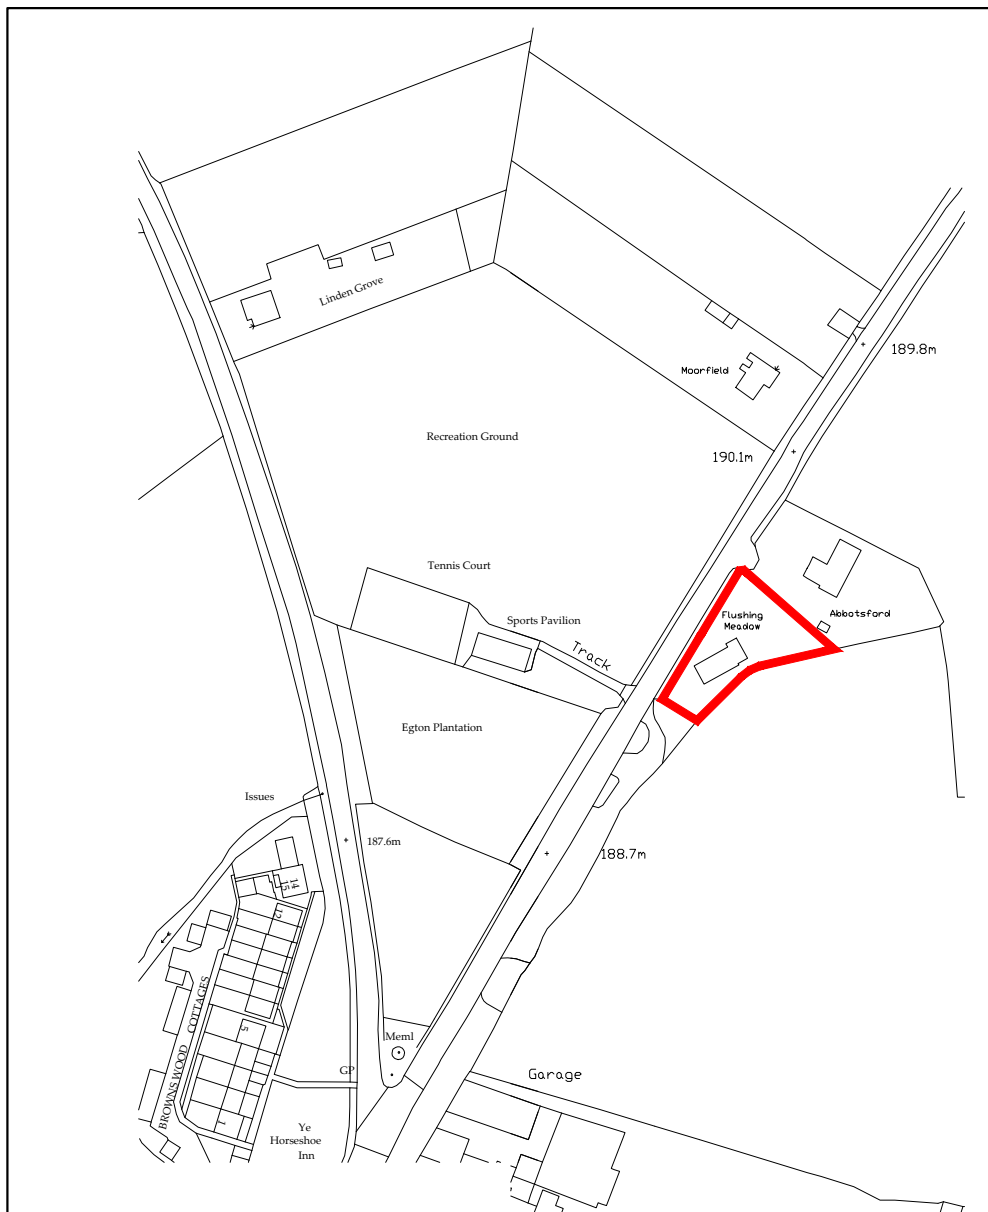

Site Plan
Scale 1:2500

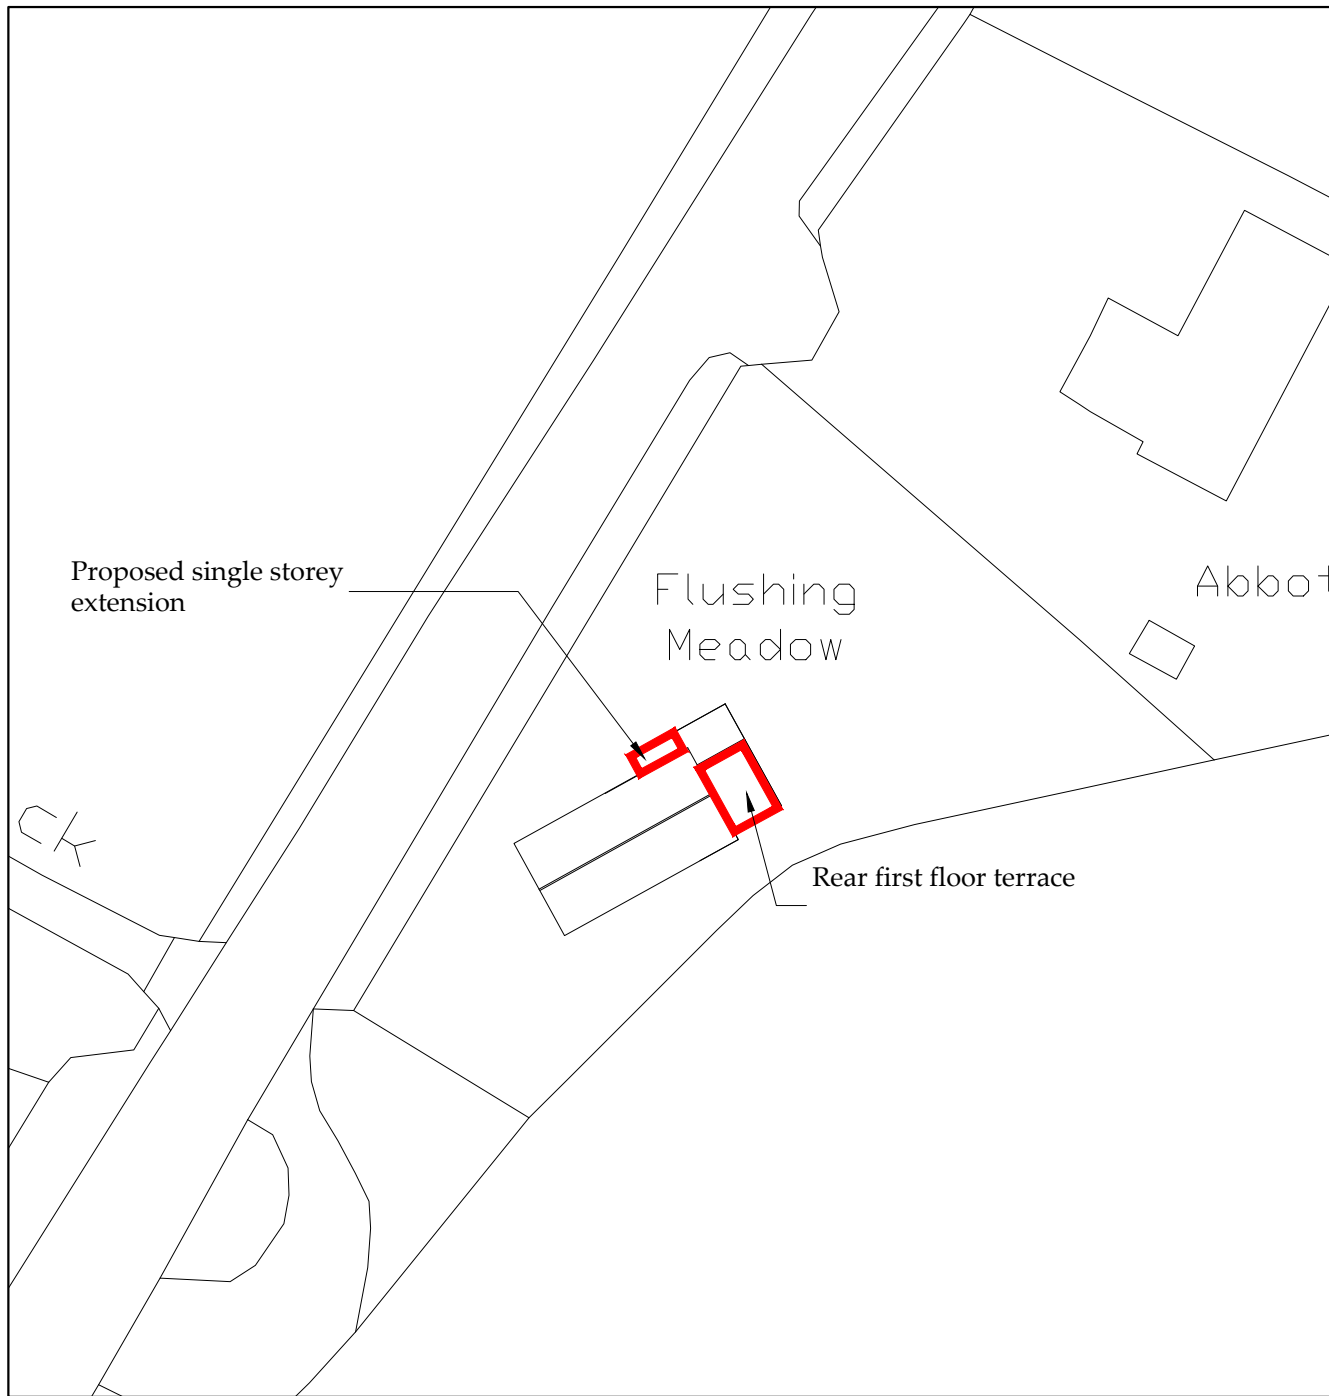

Block Plan
Scale 1:500

Ordnance Survey Licence No. 10002562

b h d partnership


Airy Hill Manor, Whitby, North Yorkshire, UK, YO21 1QB.
Tel: 01947-604871 Fax: 01947-600010
general@bhdpartnership.com www.bhdpartnership.com

●DO NOT SCALE from this drawing. Only figured dimensions are to be taken from this drawing.
●The Contractor must verify all dimensions on site before commencing any work or shop drawings.
●The Contractor must report any discrepancies before commencing work. If this drawing exceeds the quantities taken in any way, the Technician is to be informed before work is initiated.
●Work within The Construction (Design and Management) Regulations 2015 is not to start until a Health & Safety Plan has been produced. This drawing is Copyright and must not be reproduced without consent of BHD Partnership Ltd

REV	DATE	BY	AMENDMENT	CHKD	APVD
B	23/03/21	CE	Red line amended		
A	01/02/21	CE	Issued for approval		


CLIENT: Mr S & Mrs L Shaw		
PROJECT: Flushing Meadows Egton YO21 1UA		
A3	DRN: C Eynon	DATE: 01/02/21
SCALE: As shown	ISSUE: Preliminary	

DRAWING TITLE: Location Plan and Block Plan	
DRAWING NR: D12014-01	REV: B

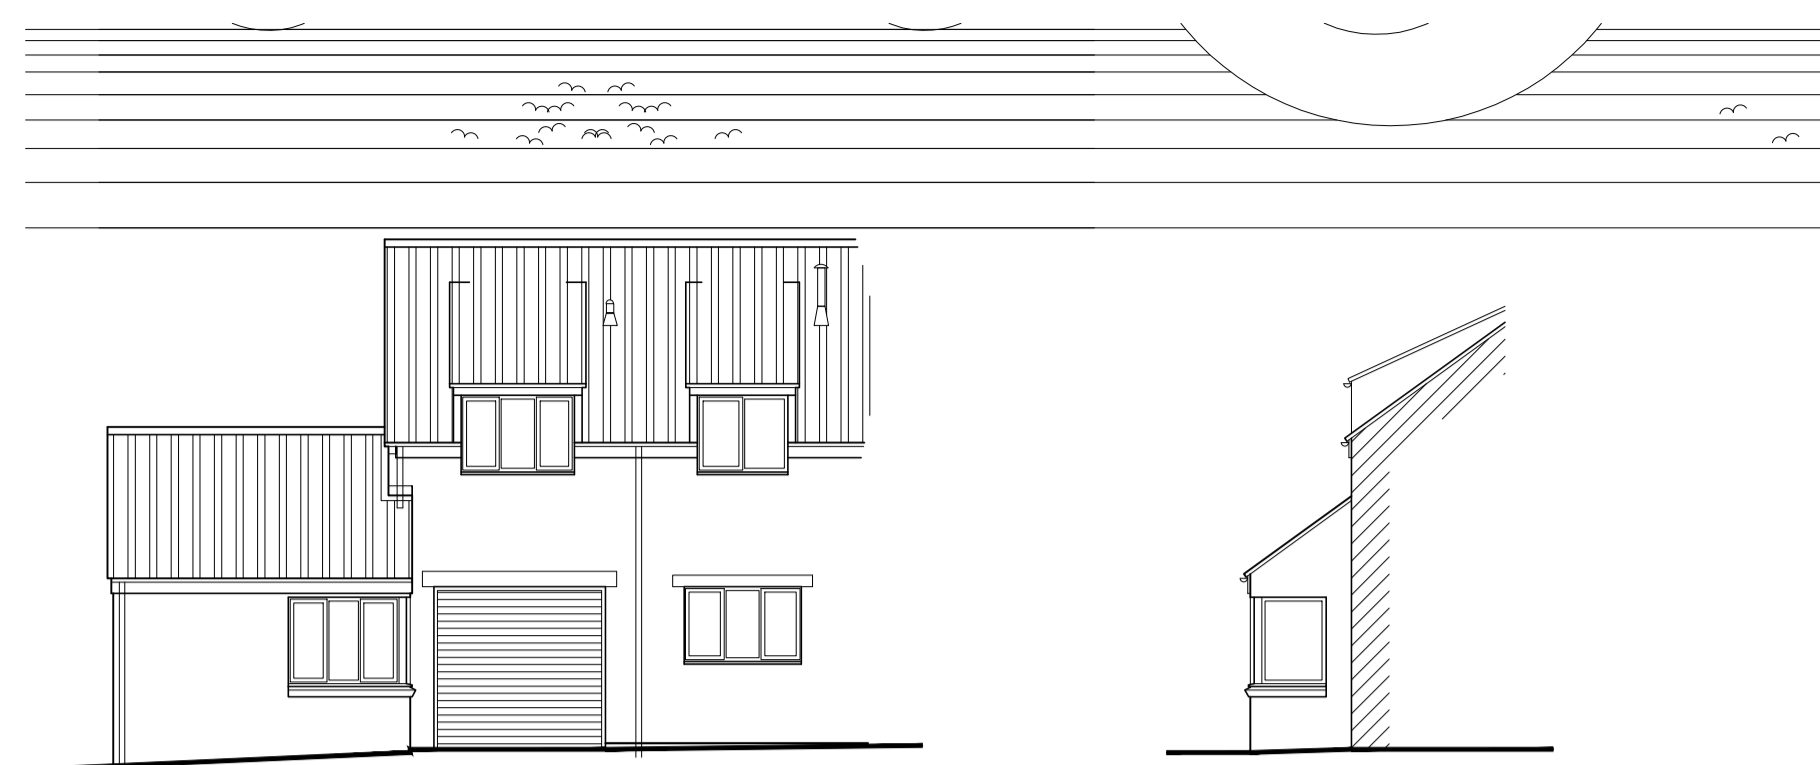

Front Elevation
Scale 1:100


Part Side Elevation
Scale 1:100

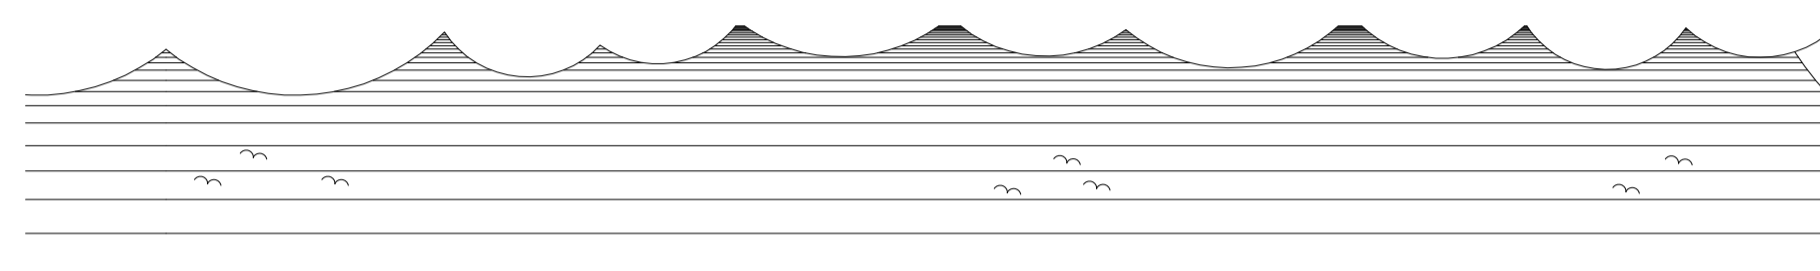


Rear Elevation
Scale 1:100

Side NE Elevation
Scale 1:100

existing

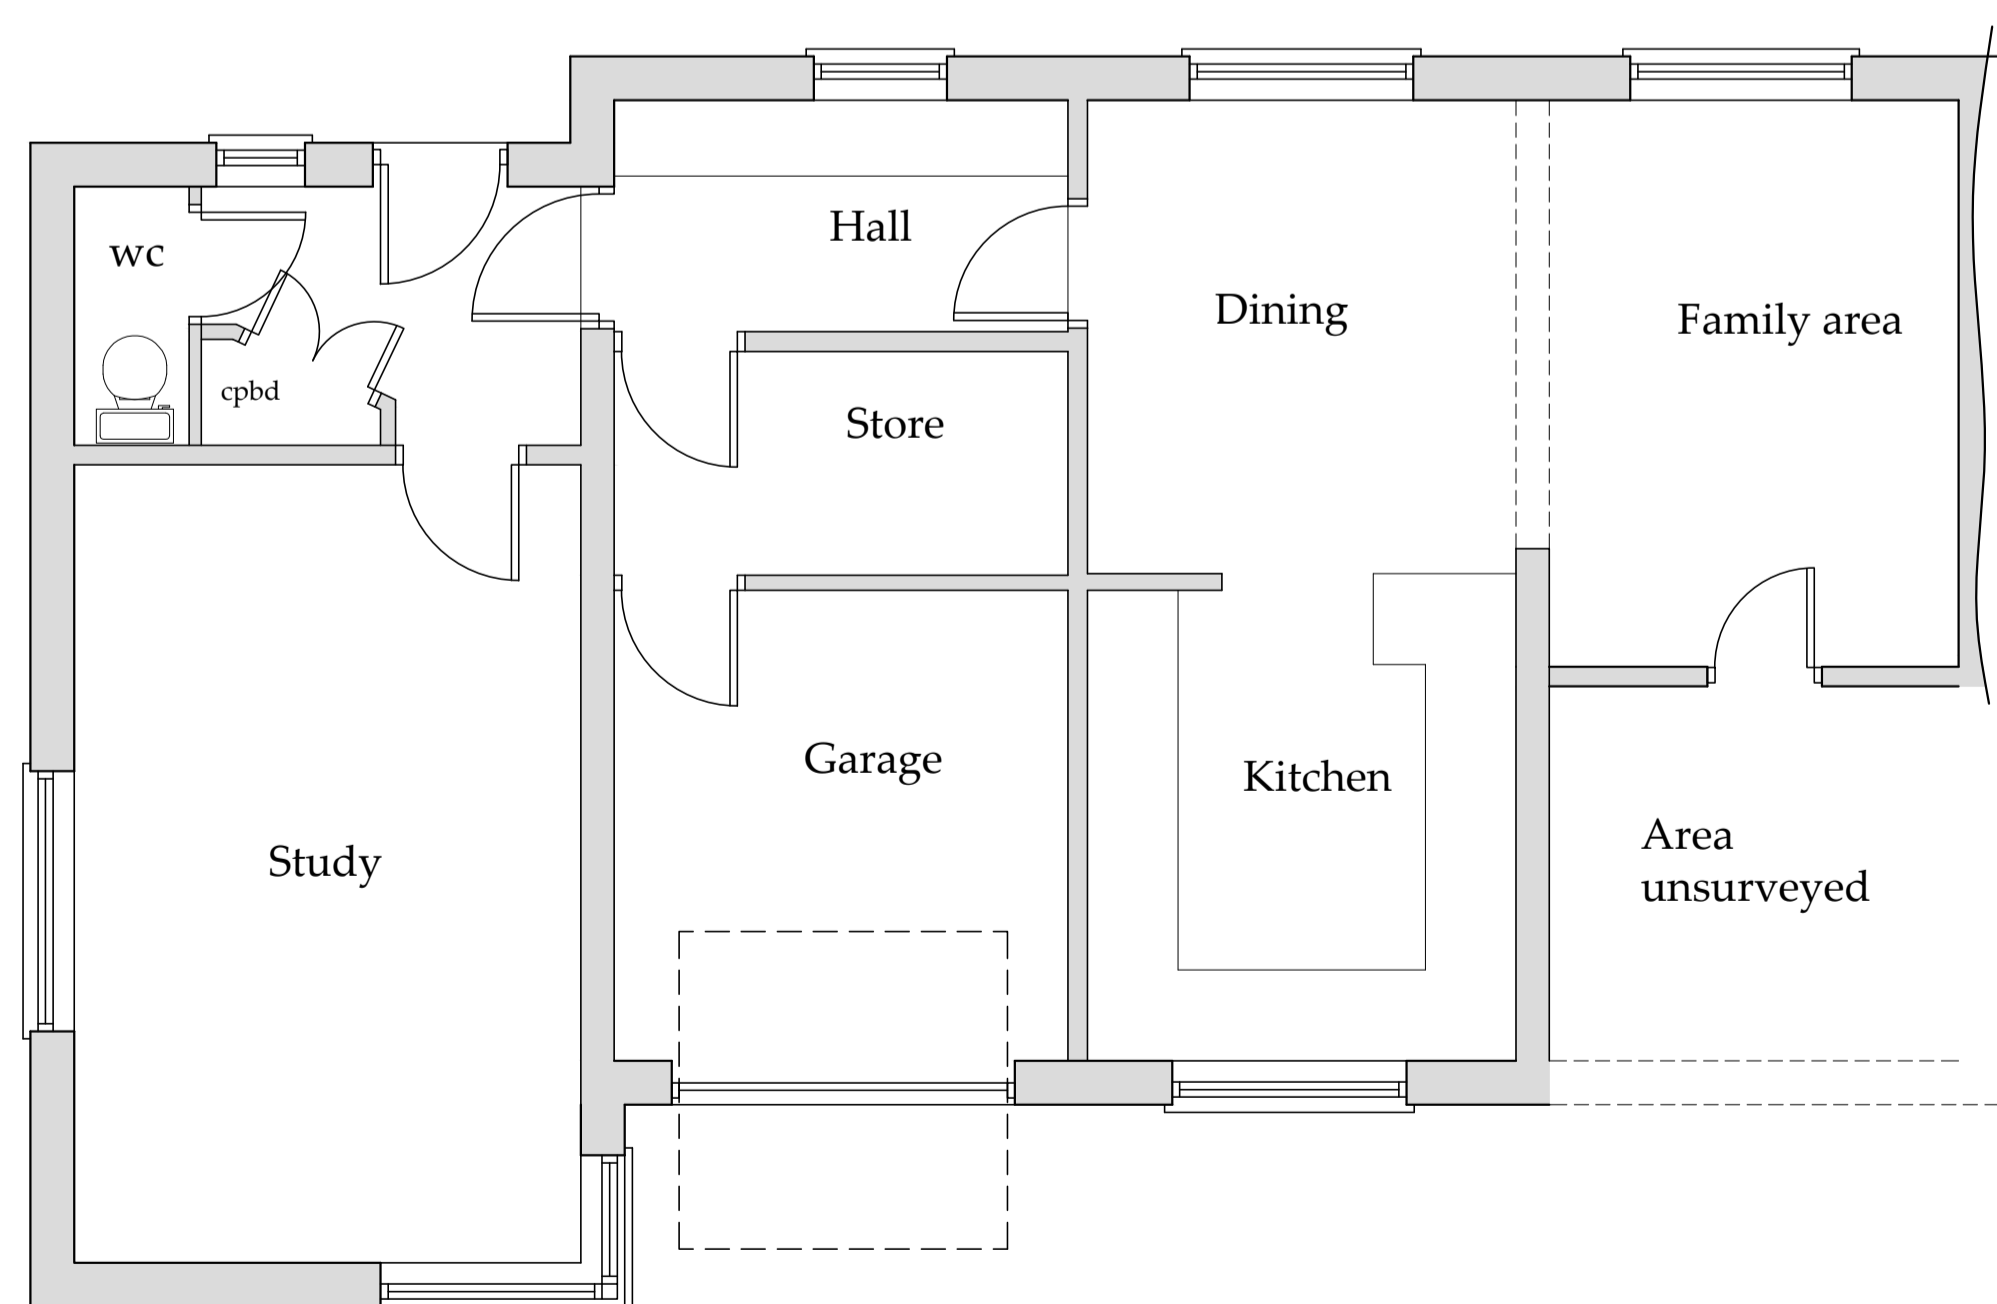


Ground Floor Plan
Scale 1:50

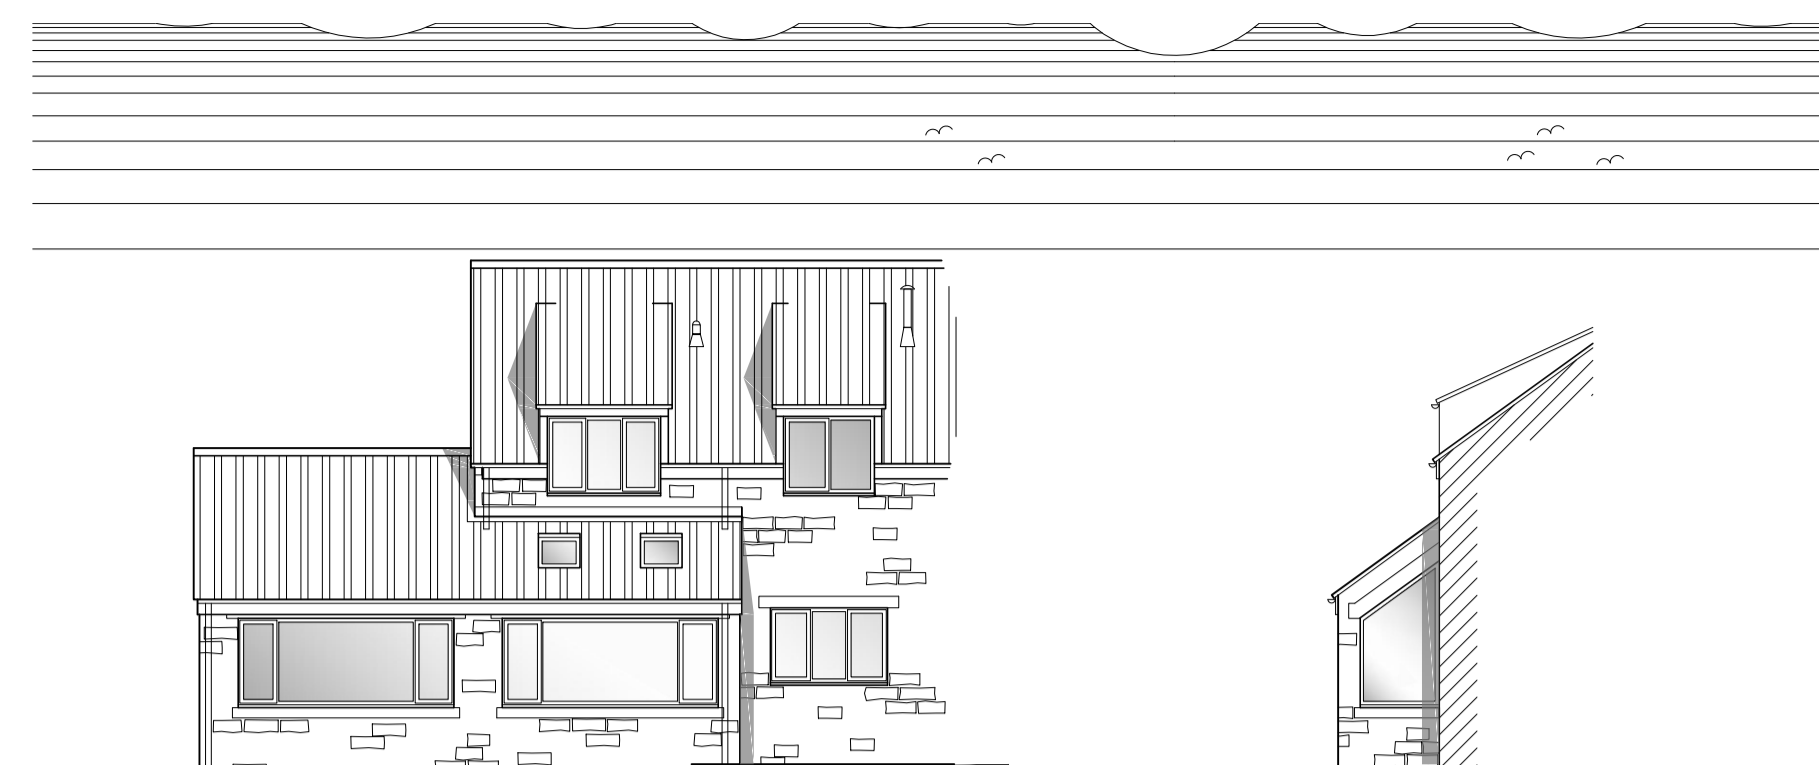

Front Elevation
Scale 1:100

Part Side Elevation
Scale 1:100

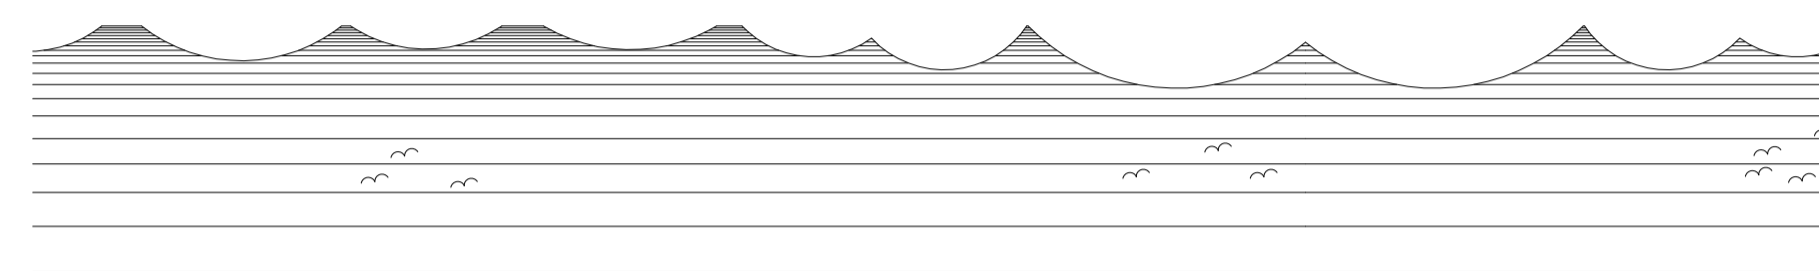


Rear Elevation
Scale 1:100


Side NE Elevation
Scale 1:100

Replace existing window with door
Terrace 'cut out' of existing roof
Line of terrace, tapered glazed balustrade

proposed

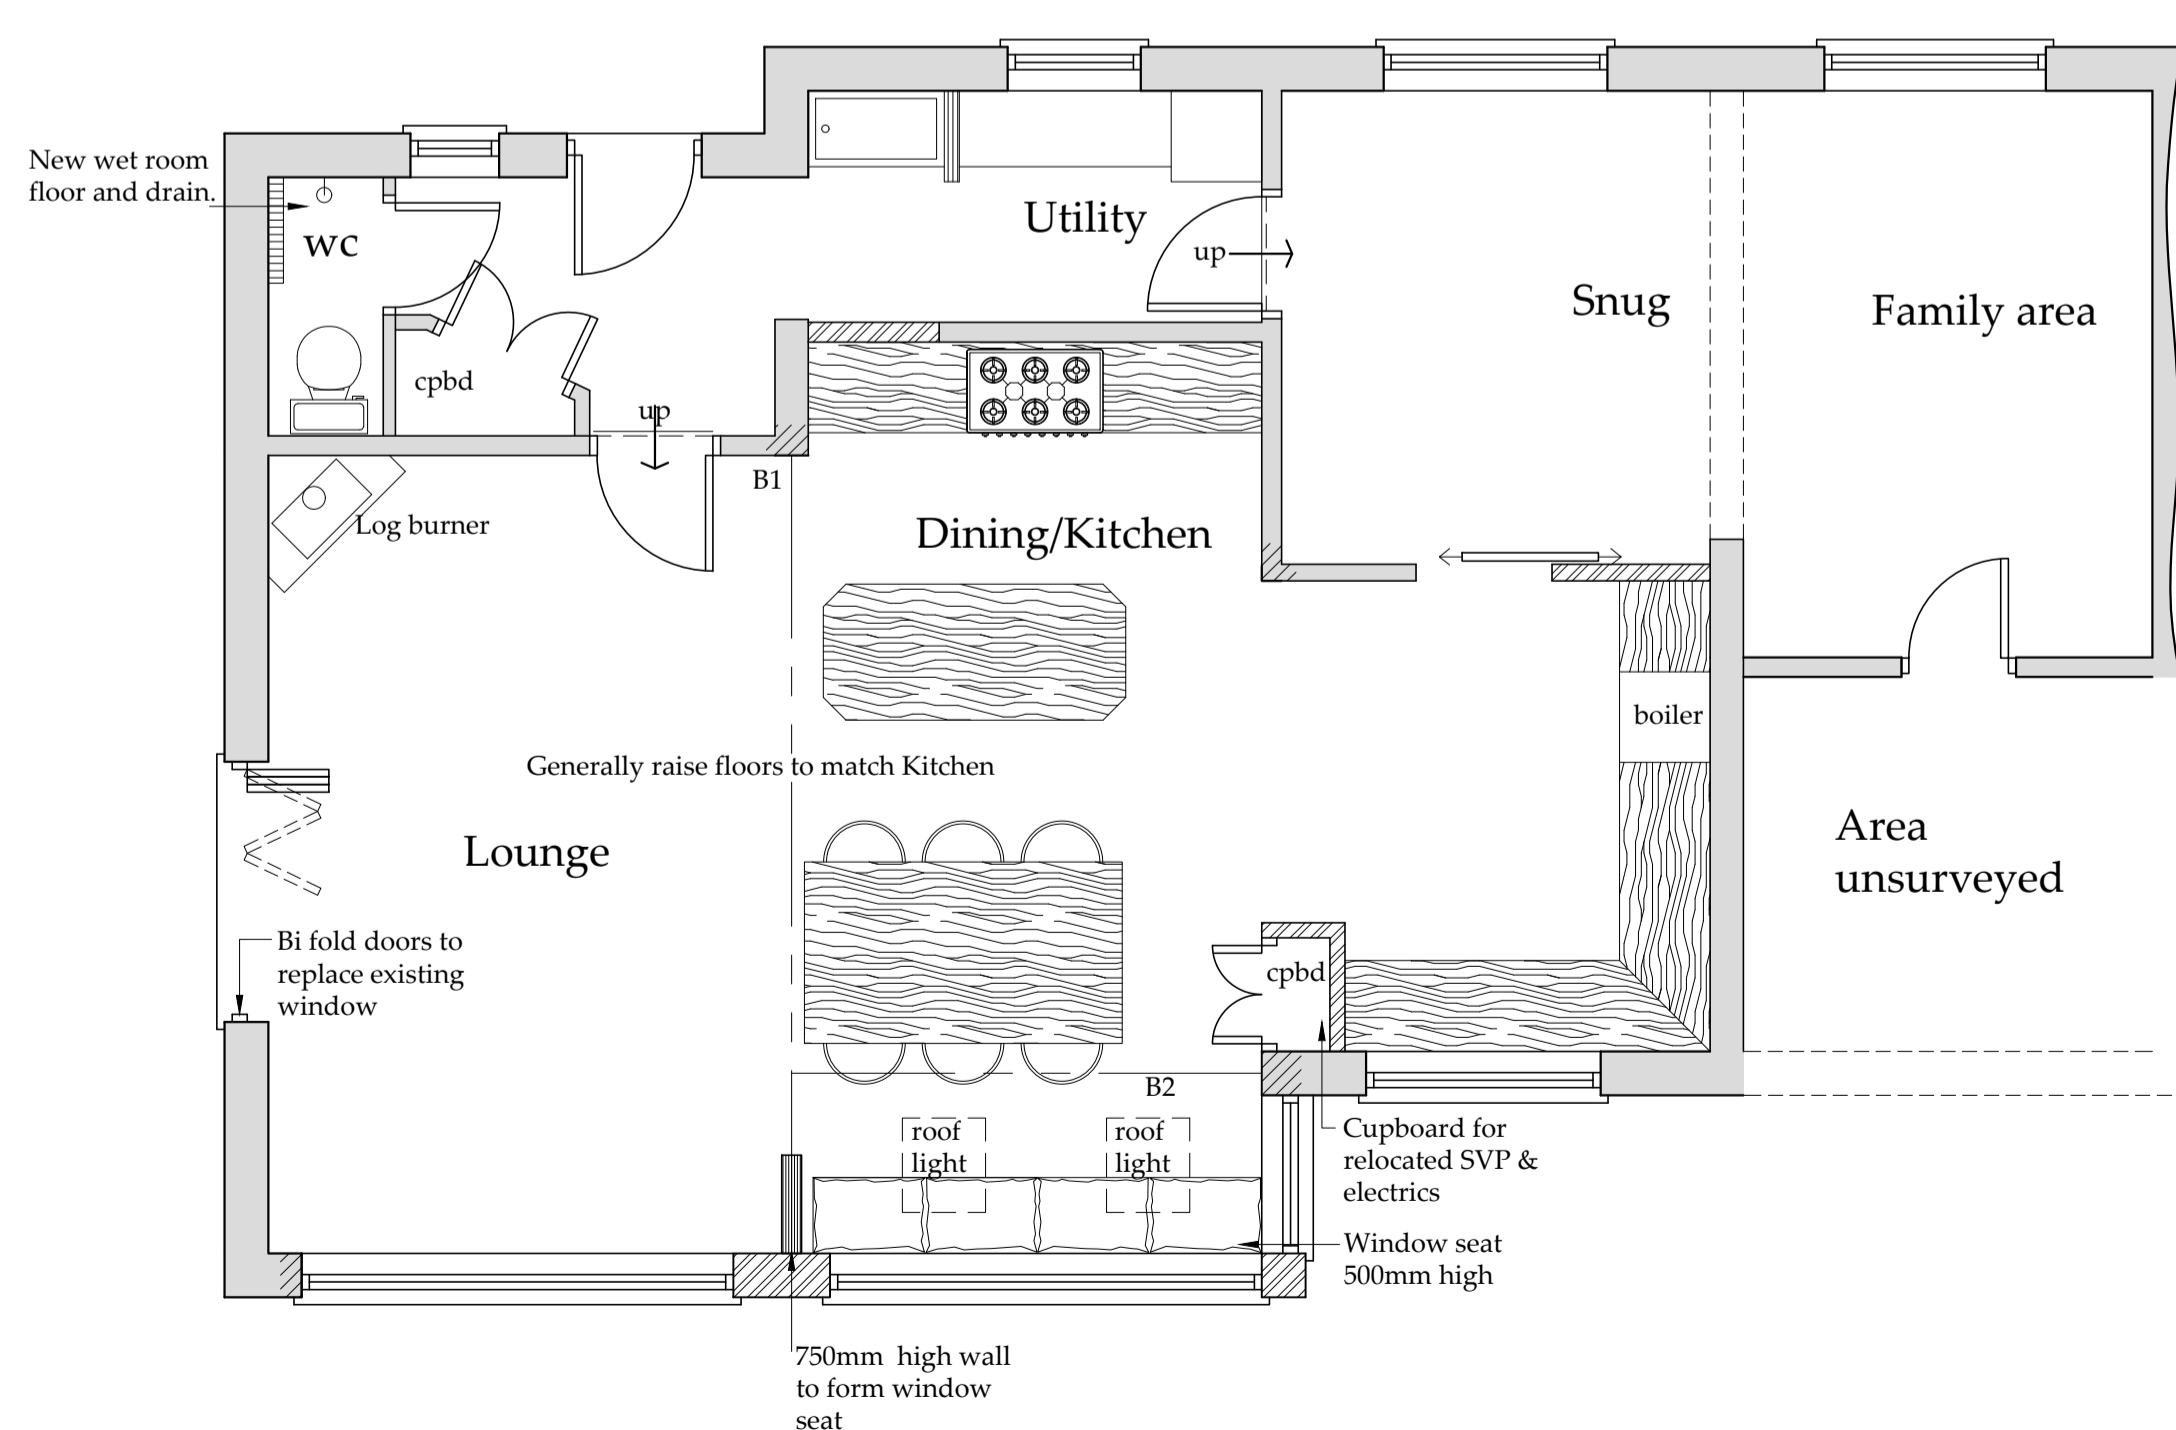

Ground Floor Plan
Scale 1:50

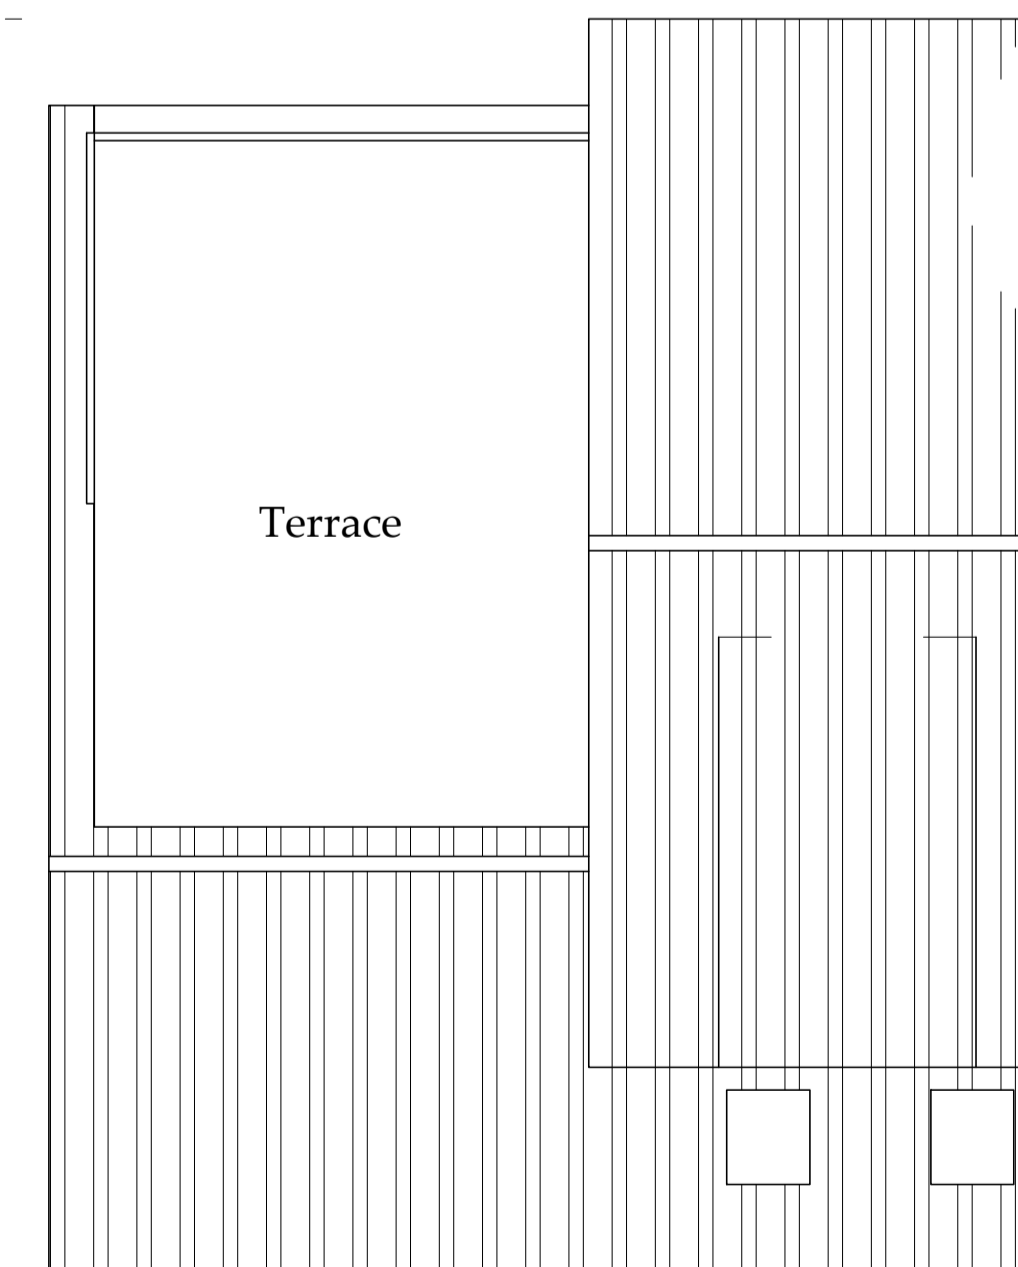

Roof Plan
Scale 1:50

Do not scale from this drawing, only figured dimensions are to be taken from this drawing.
The contractor must verify all dimensions on site before commencing any work or shop drawings.
The contractor must report any discrepancies before commencing work. If this drawing exceeds the quantities taken in any way, the technician is to be informed before work is initiated.
Work within the construction (design and management) regulations 2015 is not to start until a health & safety plan has been produced. This drawing is copyright and must not be reproduced without consent of BHD Partnership Ltd.
CDM Regulations
Contractor must not start without 'Pre Construction Information' from Principle Designer. If unsure contact BHD.
Contractor must agree the 'Principle Contractor' roll with the client prior to commencement of the works.
Ensure if required under CDM2015 regulations that the project is notified to the HSE.

NYMNP
23/03/2021

AMENDED

Drawings for Planning and client consideration only.

D	23/03/21	CE	Stair removed
C	28/01/21	CE	Roof plan added
B	20/01/21	nid	Client details and rear elevation
A	06/01/21	CE	Issued for approval

bhd partnership
Architecture + Engineering
Airy Hill Manor, Waterstead Lane, Whitby, N. Yorks. YO21 1QB.
P: +441947 604871 F: +441947 600010
E: general@bhdpartnership.com

CLIENT: Mr S & Mrs L Shaw
PROJECT: Alterations to Flushing Meadows Egton YO21 1UA

Drawing: Existing and Proposed Plans and Elevations

DRAWING STATUS: Preliminary

DRAWN: C Eynon CHECKED: N I Duffield

SCALE @ SIZE: 1:100&1:50 @ A1 DATE: 06/01/21

DRAWING No: D12014-02 REV: D