
From: Robert Dillon

Sent: 02 June 2021 20:41

To: Planning

Cc: Hilary Saunders



Subject: Re: NYM/2021/0398/FL

Good evening Hilary

Please find attached our updated drawing for the siting of a caravan, the caravan location is shown in red and the property boundary shown in blue

Thanks Robert

Caravan location at Lodge hill farm

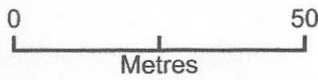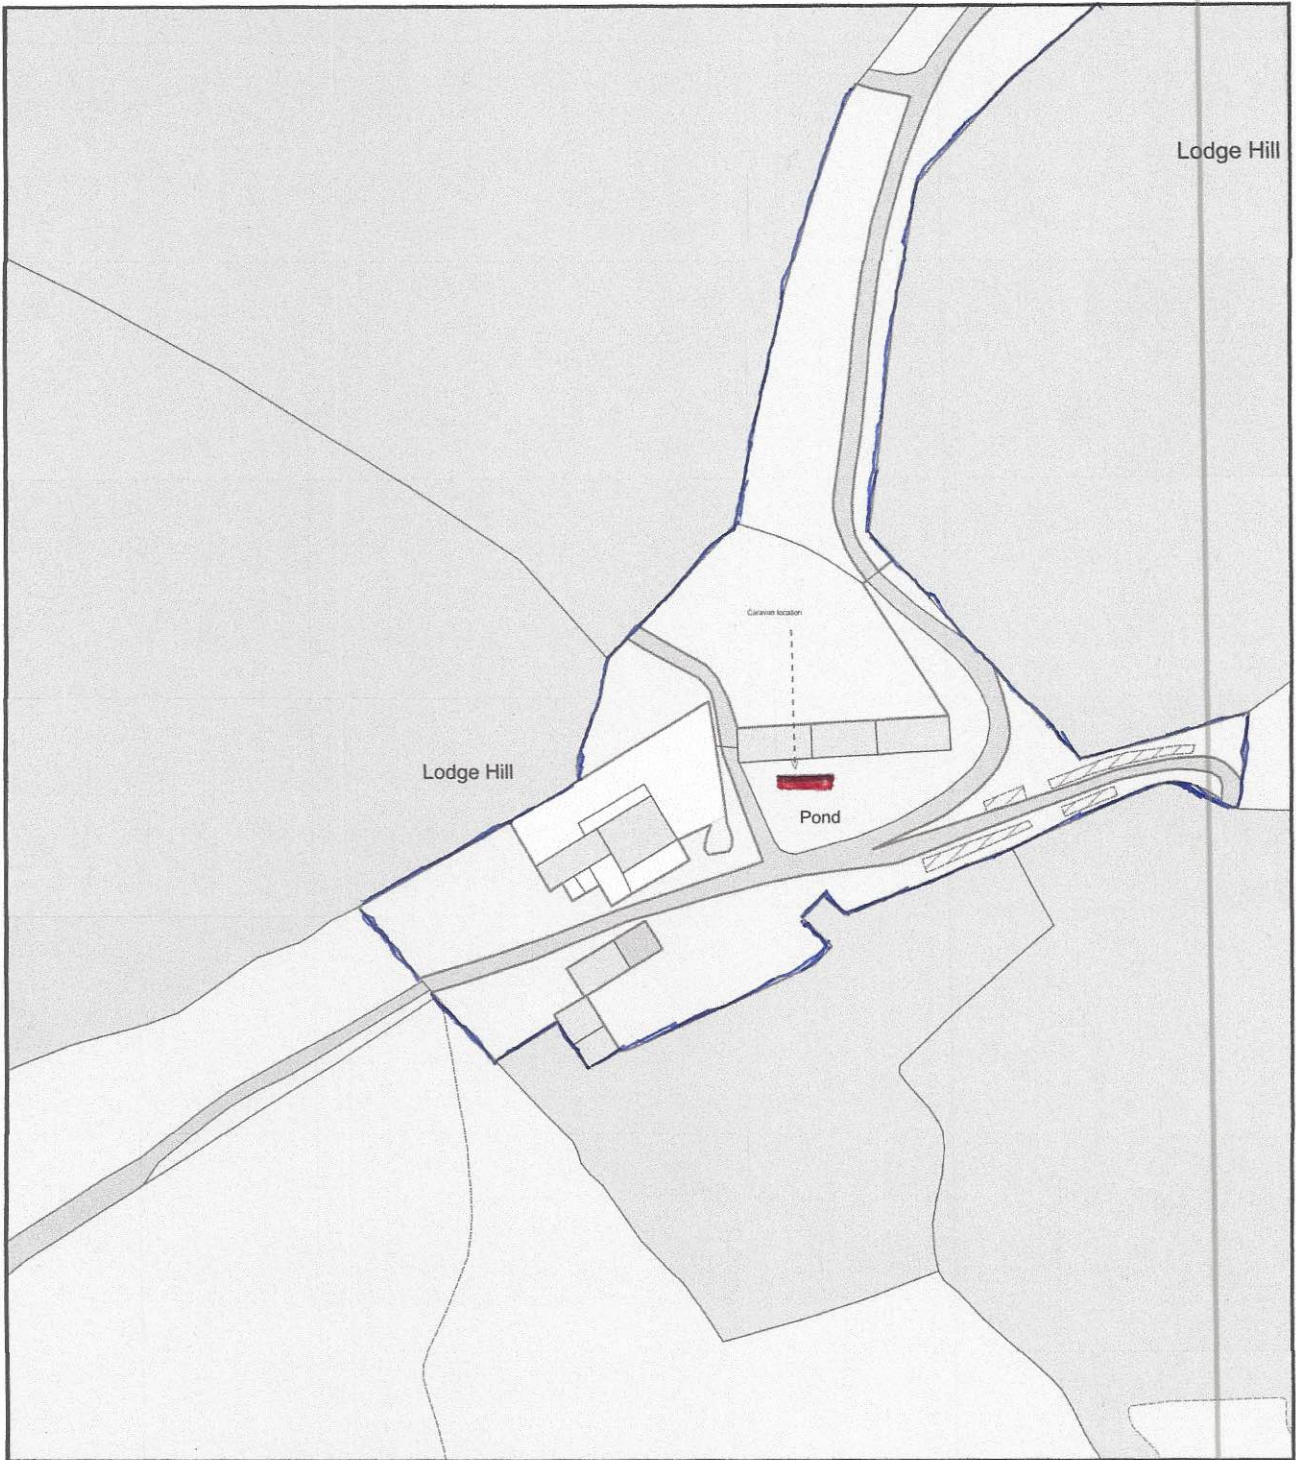

Plan Produced for: North York moors planning de
Date Produced: 26 May 2021
Plan Reference Number: TQRQM21146163537286
Scale: 1:1250 @ A4



AMENDED

NYMNP
03/06/2021