


01













EXISTING PLANS PRIOR TO APPROVAL

SCALE 1:100 @ A1

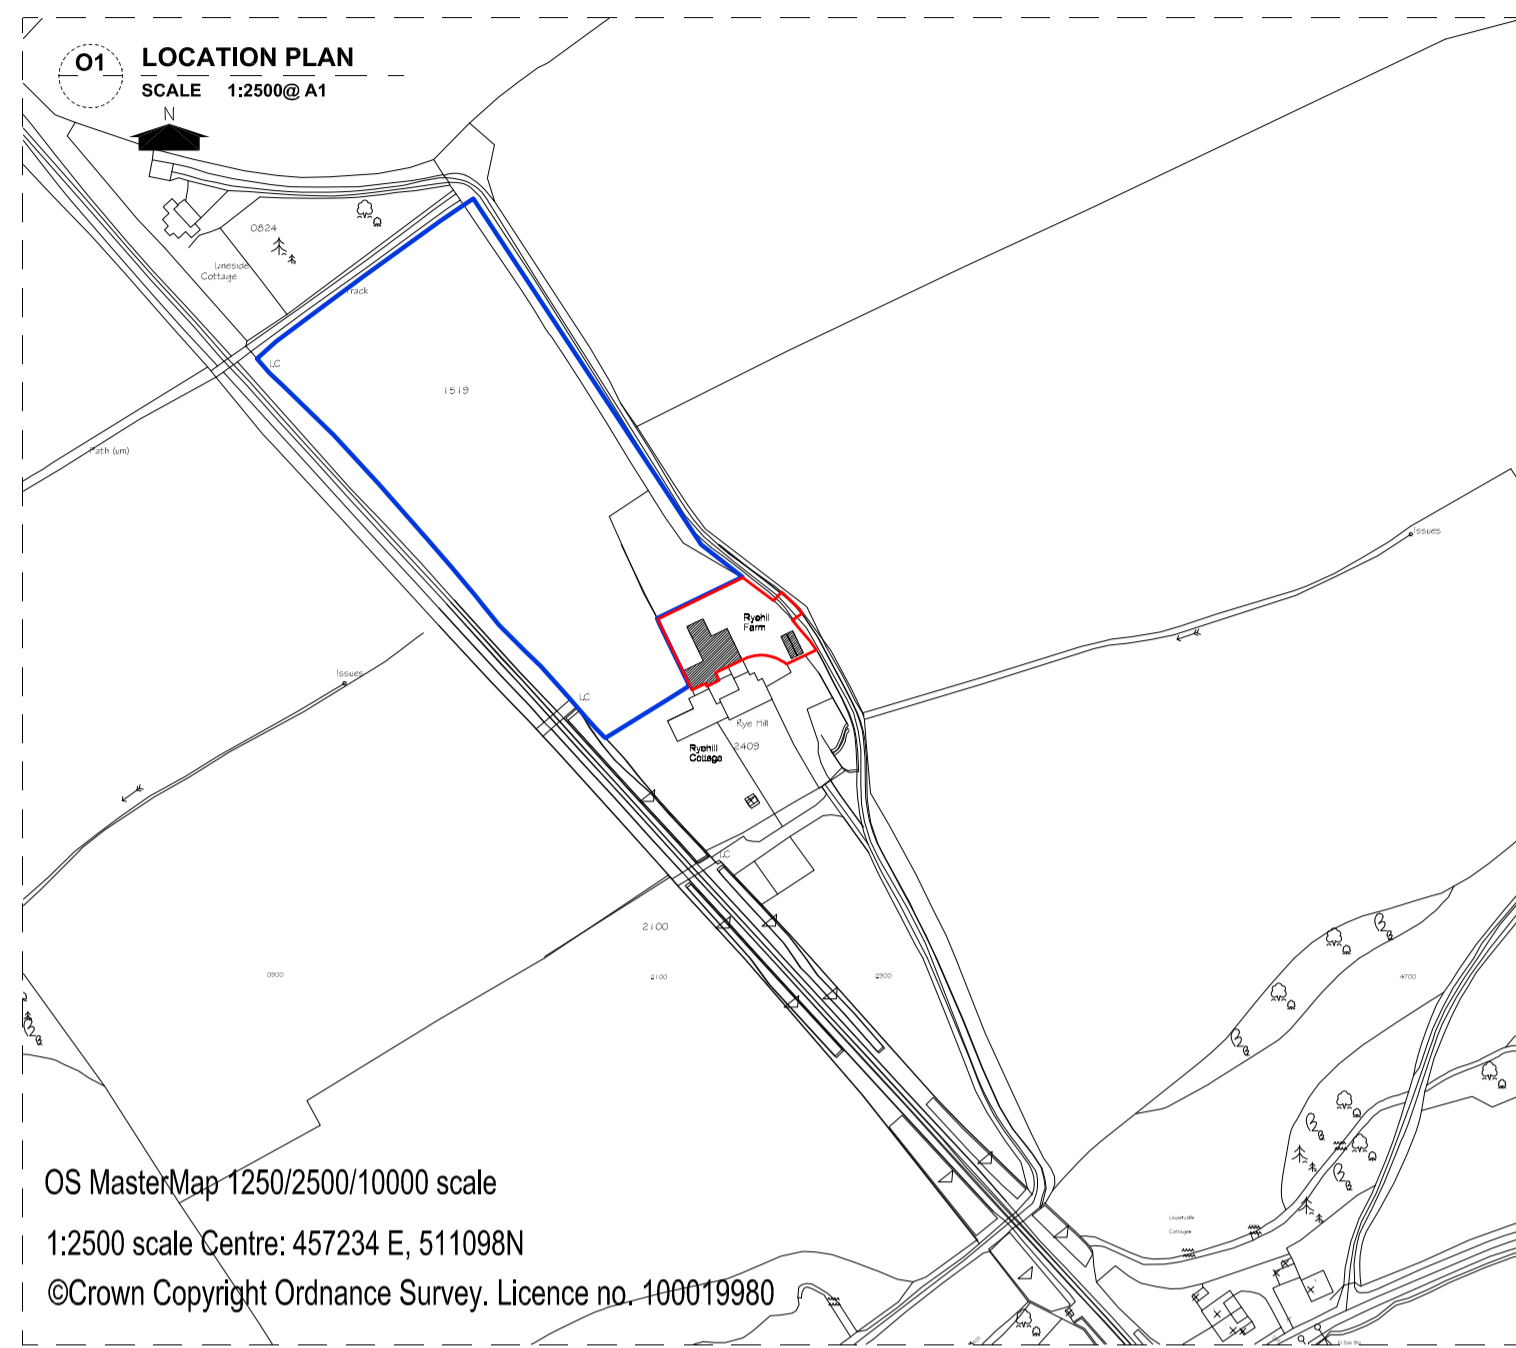

Copyright
The ownership of copyright is retained in accordance with the Copyright Designs and Patents Act 1988.
Statutory Authority Copies may be made only when in accordance with the Copyright (Material) Class to Public Information (Sharing of Copies of Plans and Drawings) Order 1986.
The moral rights of TOTAL PLANNING SOLUTIONS (UK) LTD to be identified as the author of this work has been asserted.
Check Dimensions prior to work commencing.



NYMNP
01/02/2024

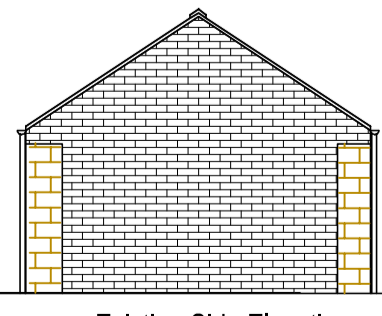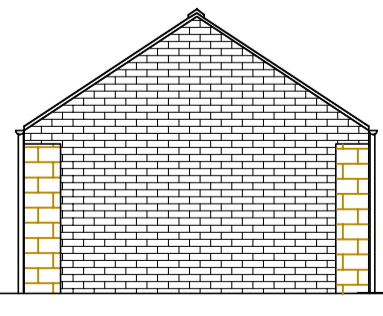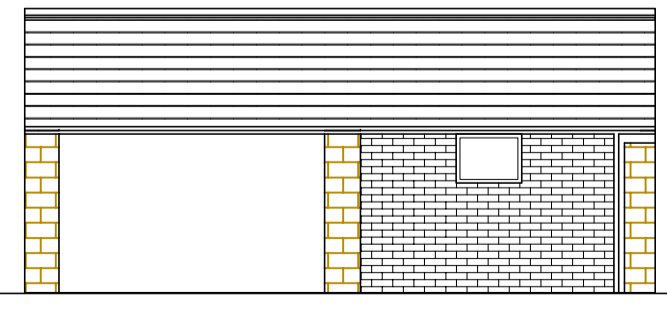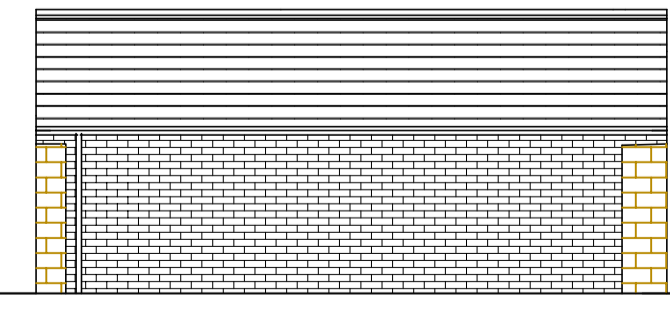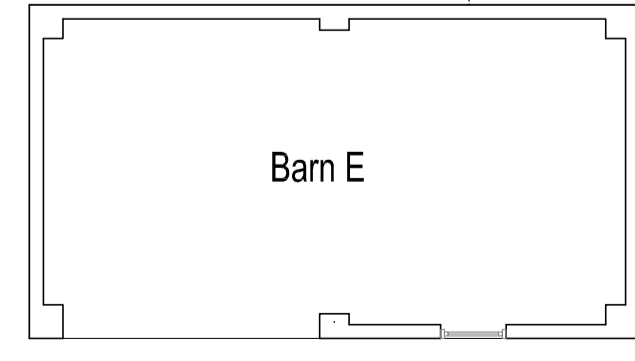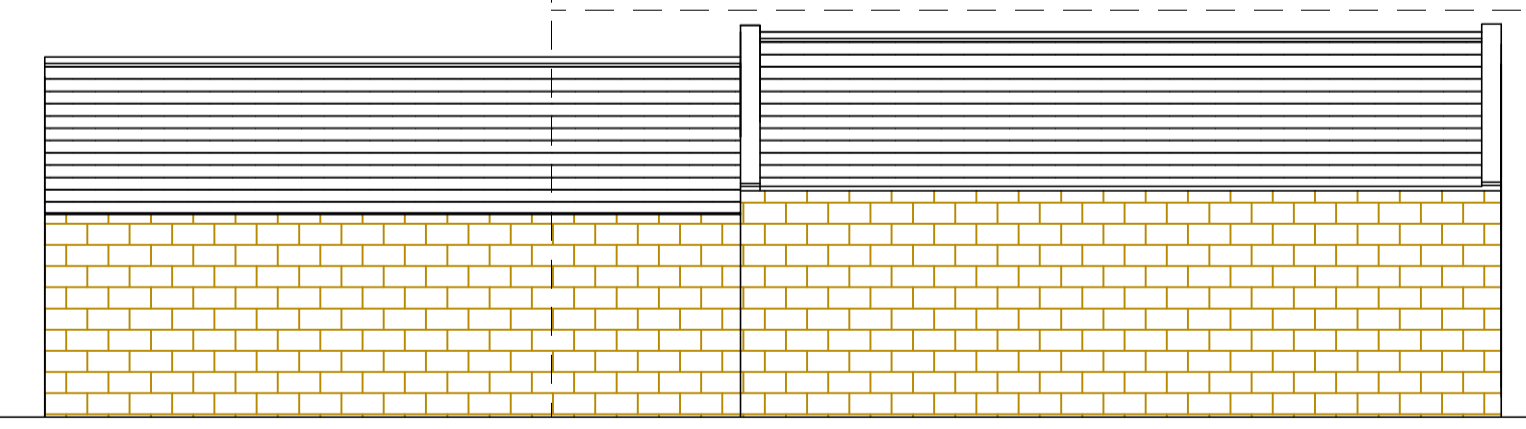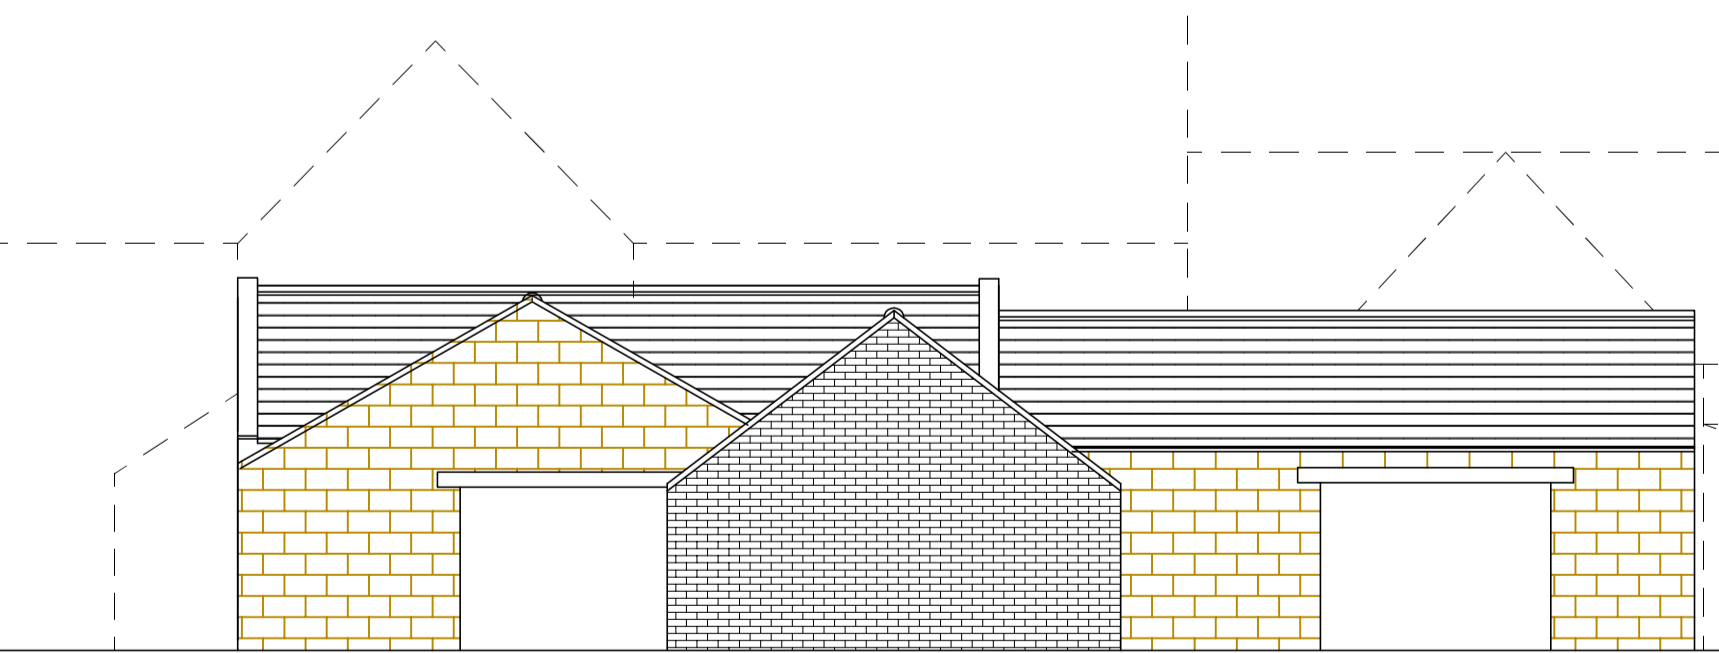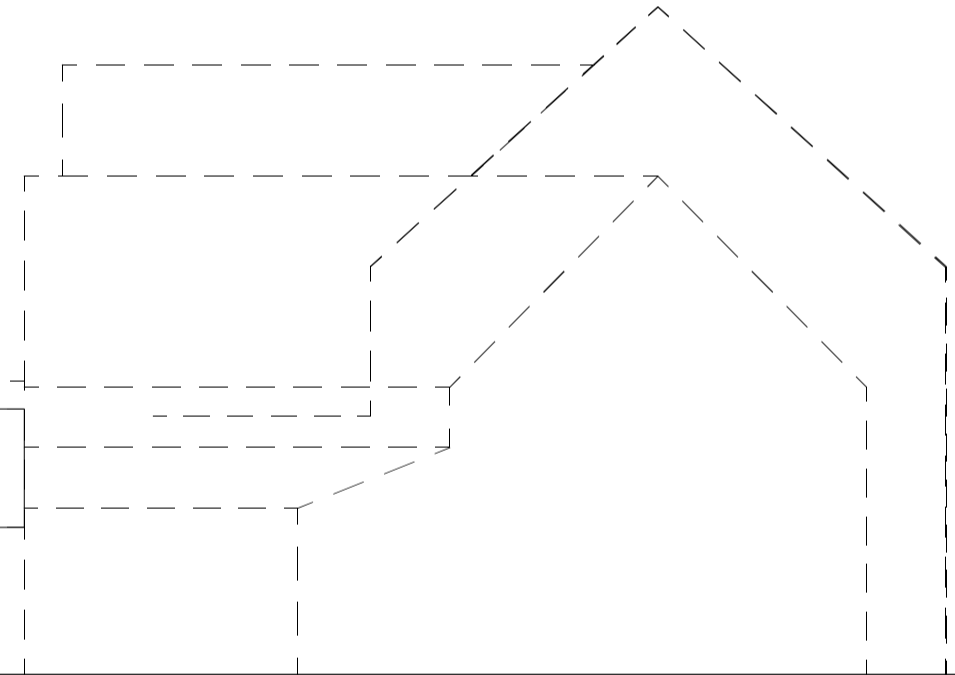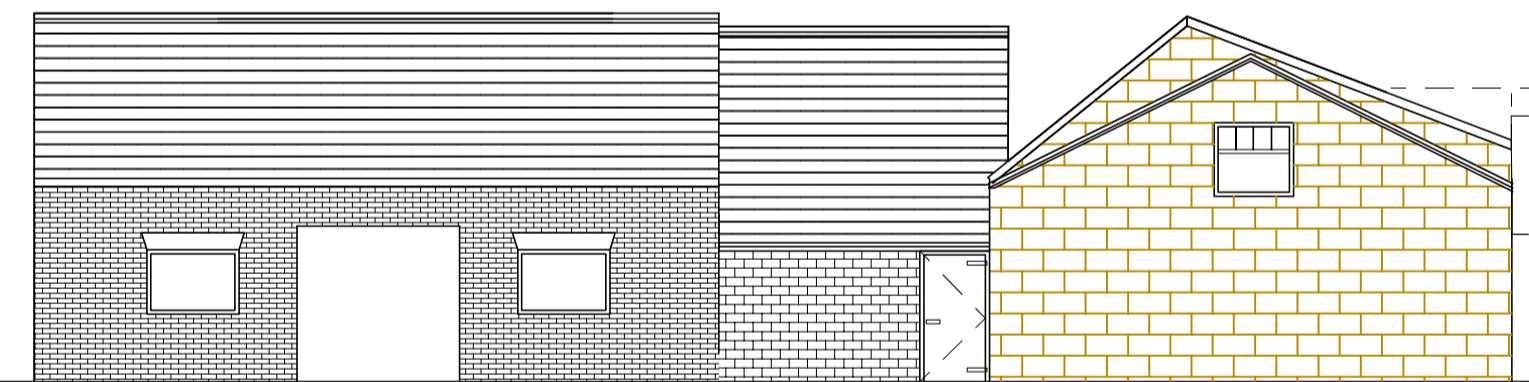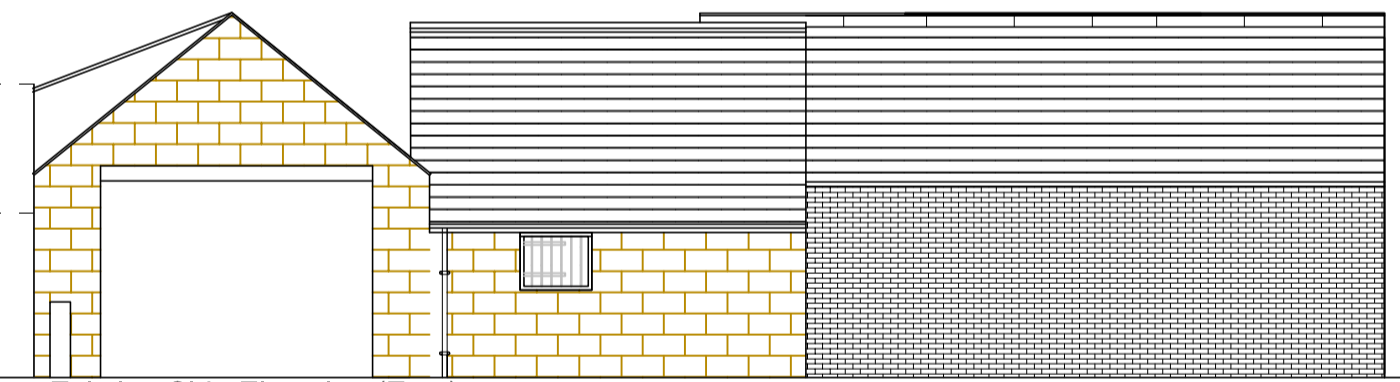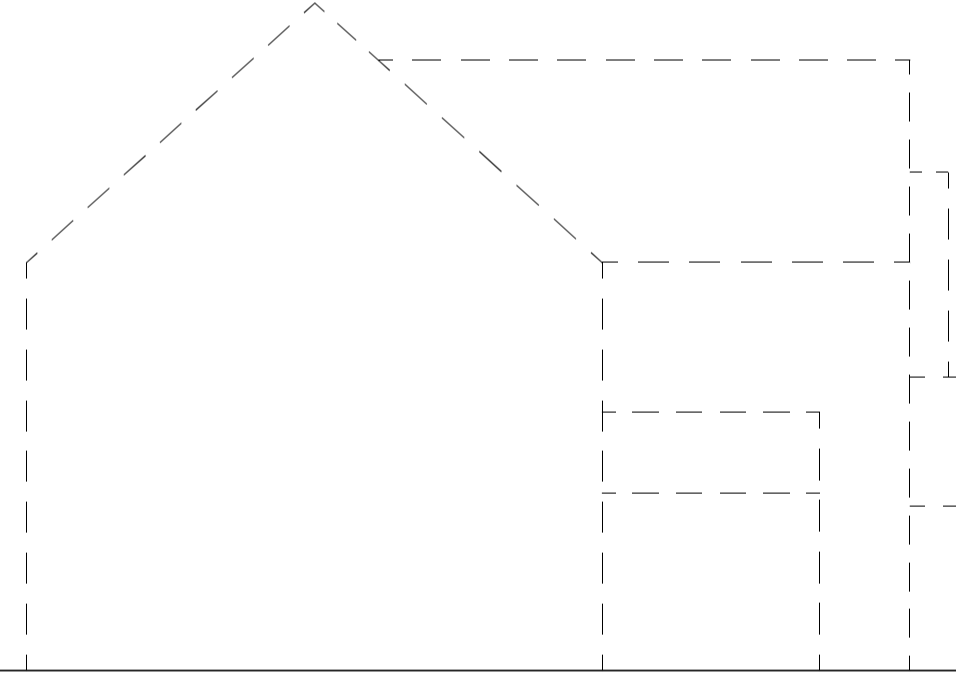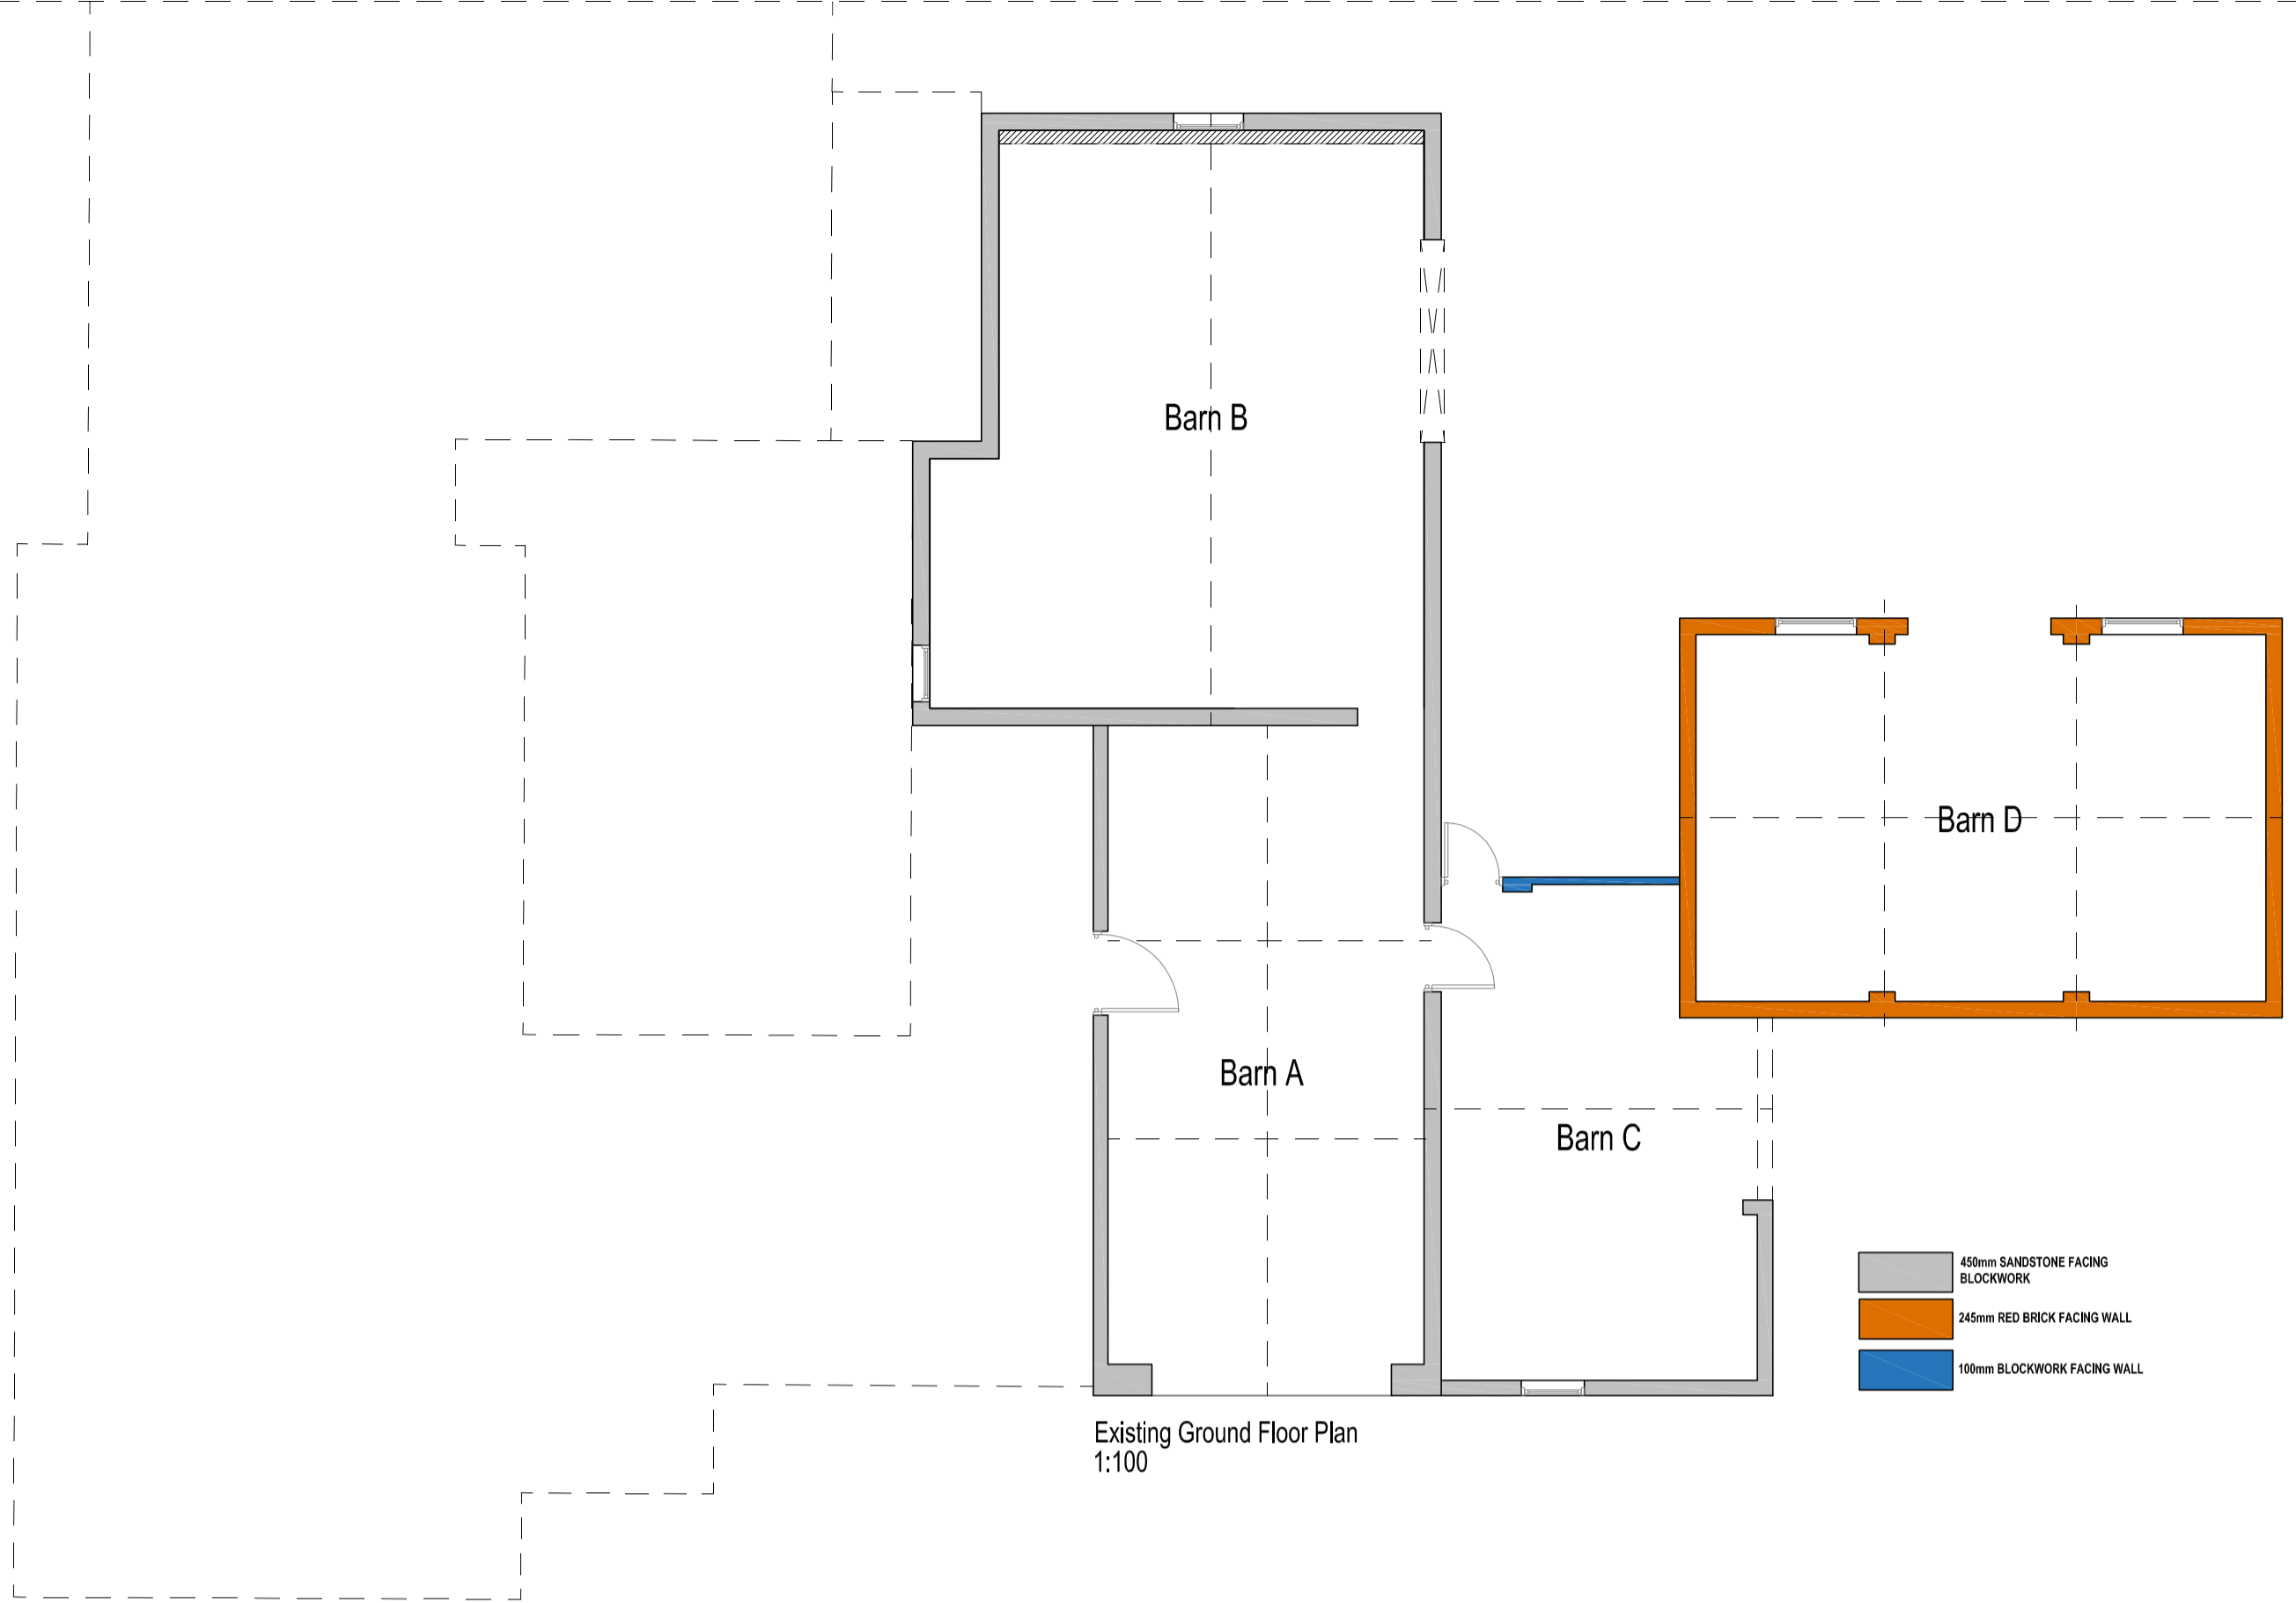

TOTAL PLANNING SOLUTIONS (UK)
3 ROCKAWAY TERRACE, LINTH-KOPPE, MEDKESBOROUGH, TS20 3QF
Tel: 01462 66782
Mob: 0792020000
Email: info@totalplanning.co.uk
Web: www.totalplanning.co.uk
Facebook: TotalPlanningSolutionsUK Ltd


PROJECT: BARN CONVERSION
LOCATION: RYEHILL FARM
GREAT AYTON

SCALE: 1:2500; 1:100 @ A1
DATE: JANUARY 2024
DWG No: 001-EXISTING PLANS
DRAWN BY: FF

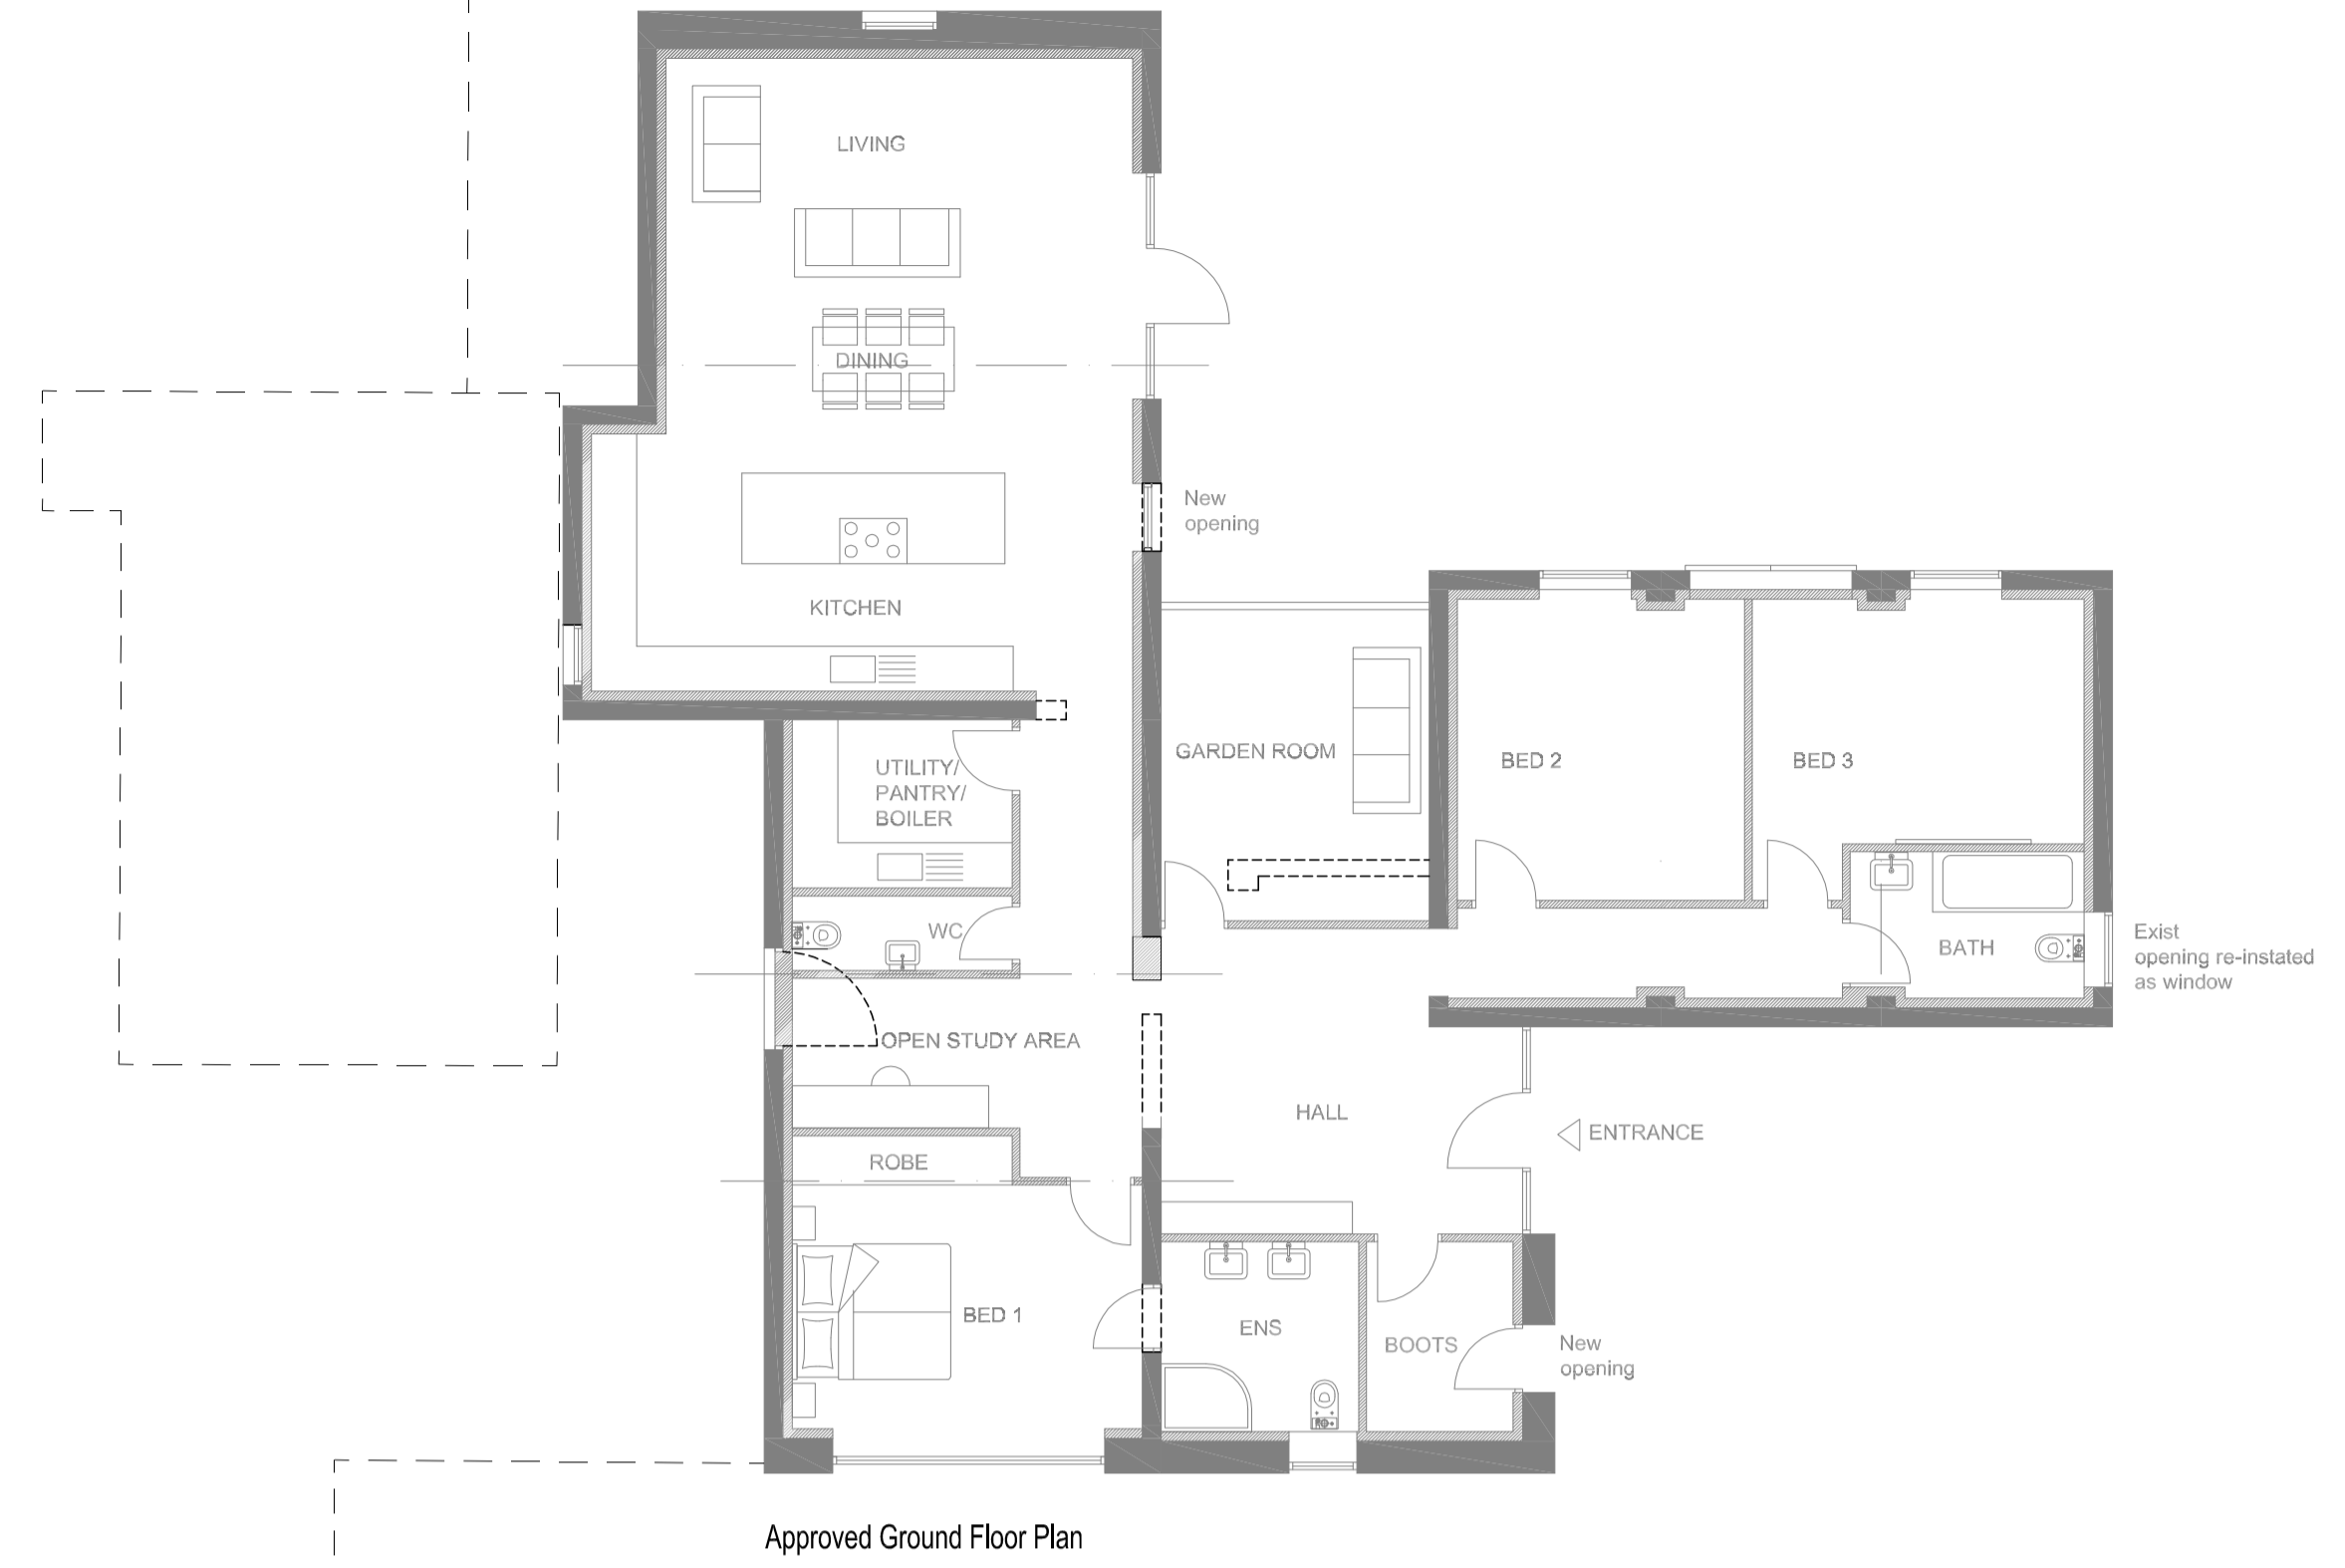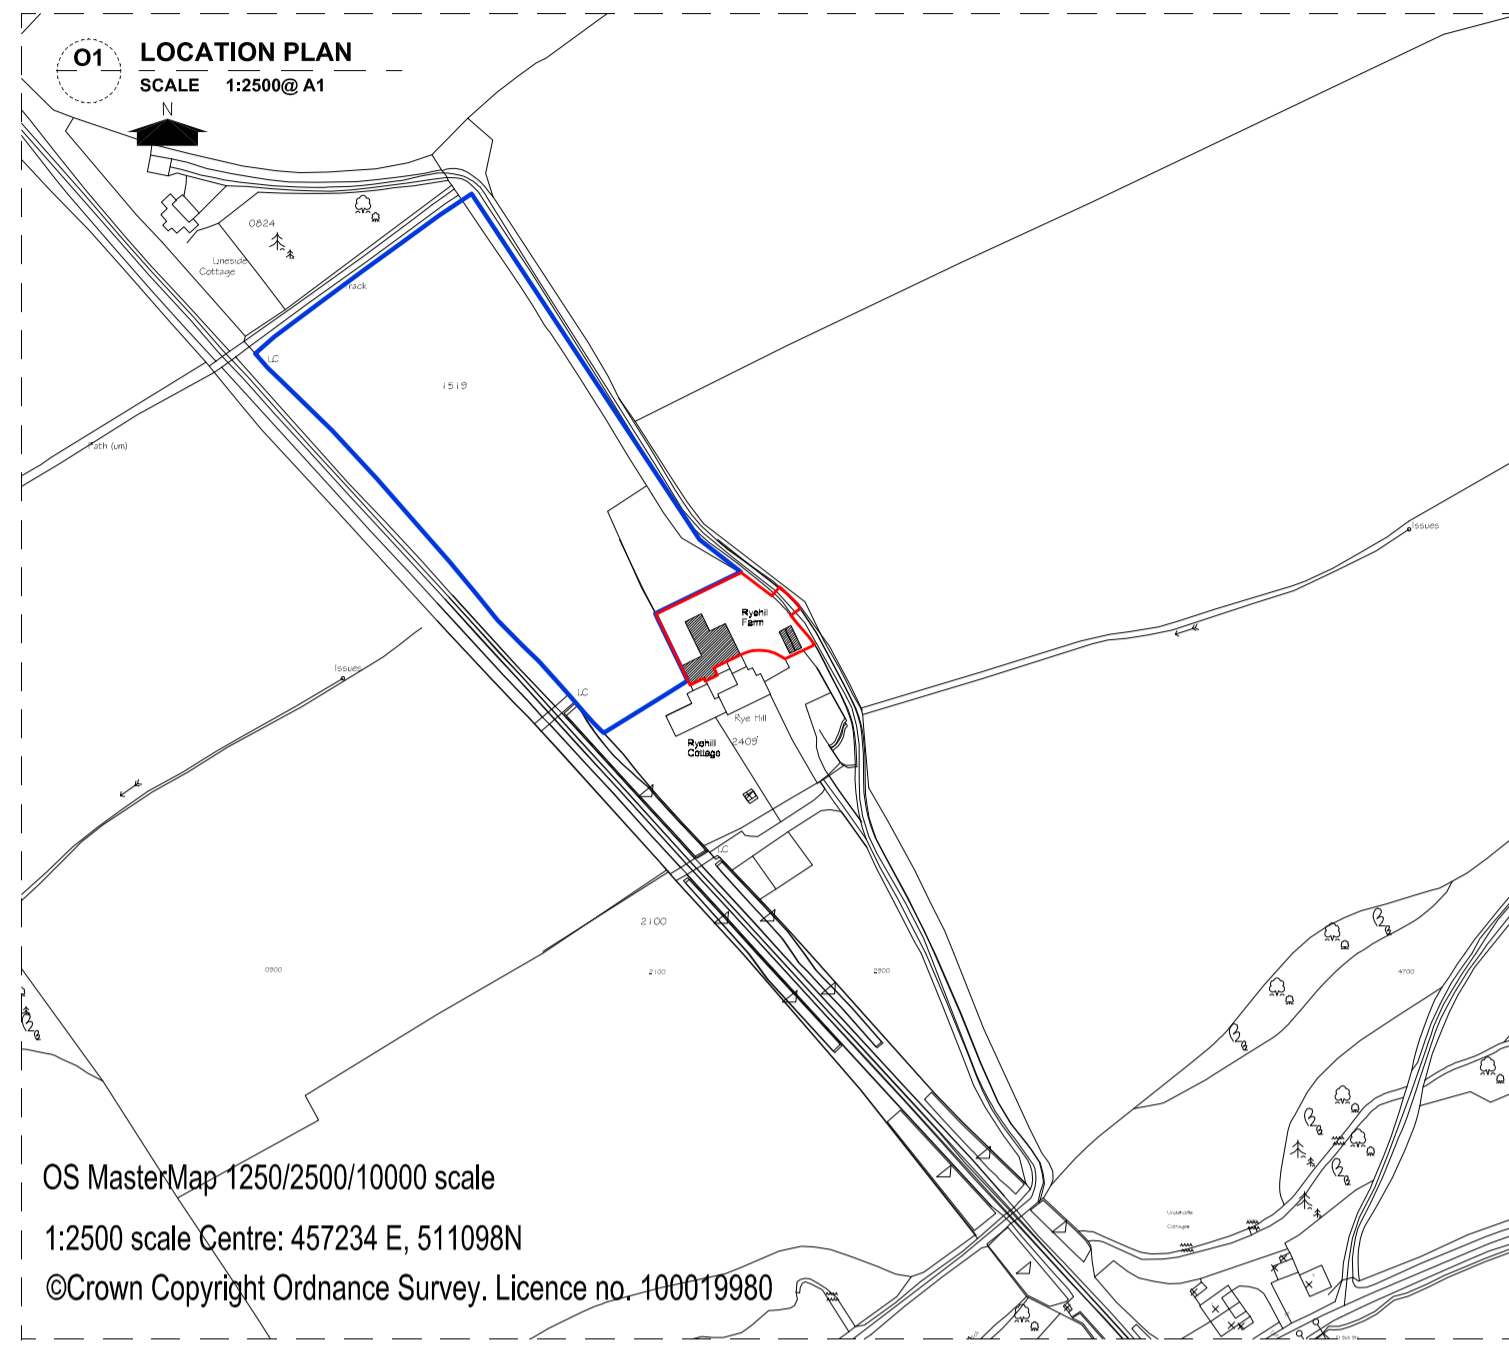

NYMNP
01/02/2024


Copyright
The ownership of copyright is retained in accordance with the Copyright Design and Patents Act 1988.
Statutory Authority Copies may be made only when in accordance with the Copyright (Designs and Patents) Act 1988.
(Marking of Copies of Plans and Drawings) Order 1995.
The moral rights of TOTAL PLANNING SOLUTIONS (UK) LTD to be identified as the author of this work has been asserted.
Check Dimensions prior to work commencing.

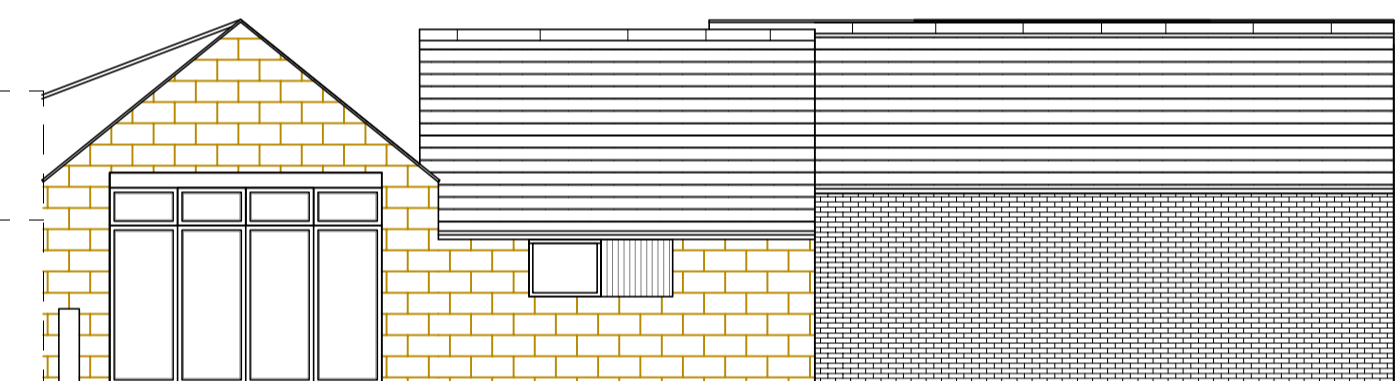


Approved Side Elevation (East)




Approved Side Elevation (West)

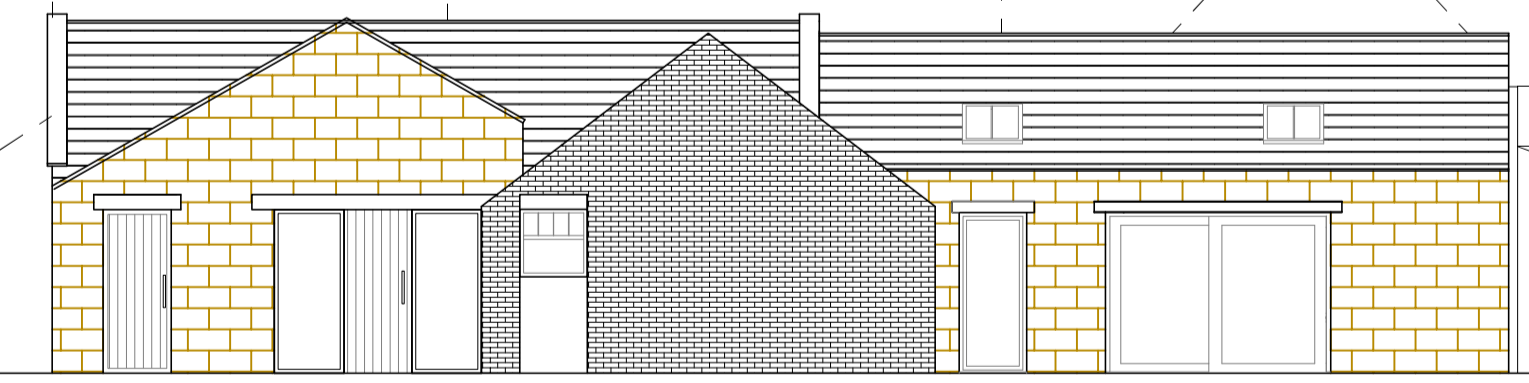


Approved Front Elevation (north)

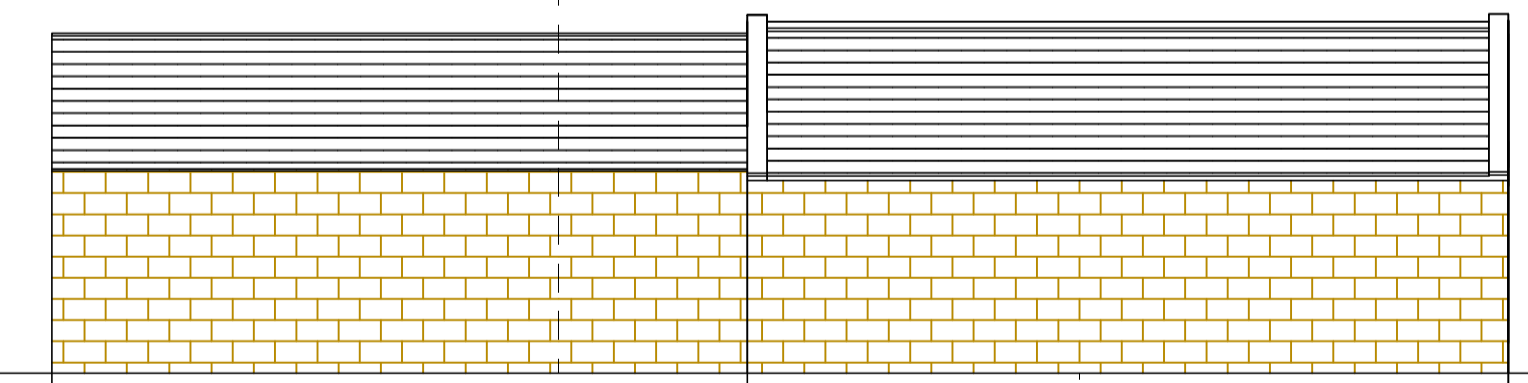


Approved Rear Elevation South (partly obscured by neighbour)

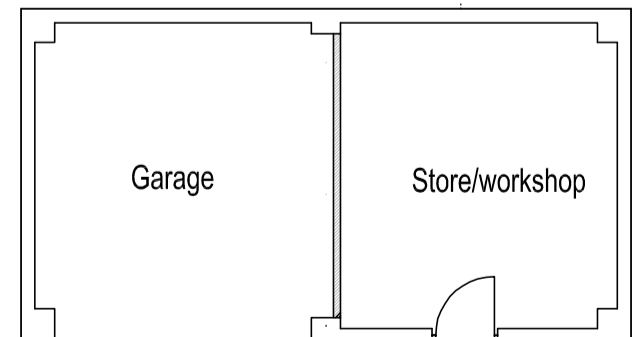


Approved Ground Floor Plan

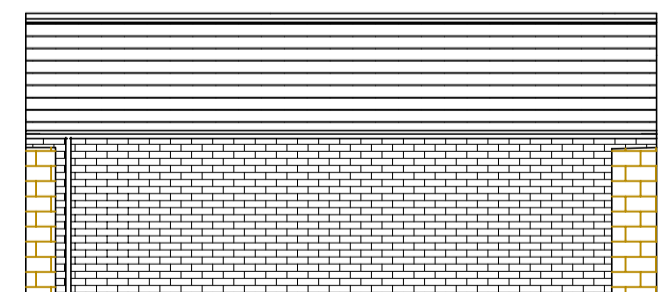


Approved Rear Elevation

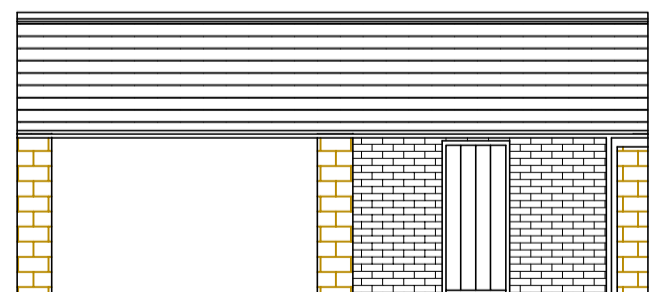

Approved Front Elevation

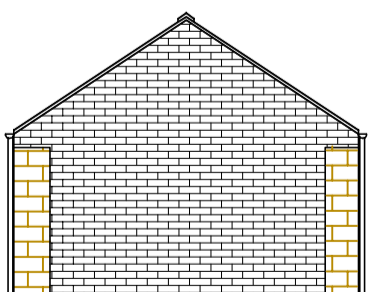

Approved Side Elevation

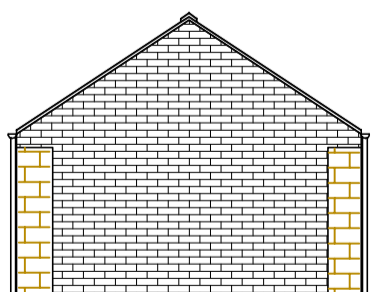


Approved Side Elevation


TOTAL PLANNING SOLUTIONS (UK)
2 ROMAN TERRACE, LINTHORPE,
MIDDLESBROUGH TS10 5GF
Tel: 01642 860752
Mob: 07950350069
Email: info@totalplanning.co.uk
Web: www.totalplanning.co.uk
Facebook: Total Planning Solutions UK Ltd

PROJECT: BARN CONVERSION
LOCATION: RYE HILL FARM
GREAT AYTON



SCALE: 1:2500:1:100 @A1
DATE: JANUARY 2024
DWG No: 002-AS APPROVED PLANS
DRAWN BY: FF

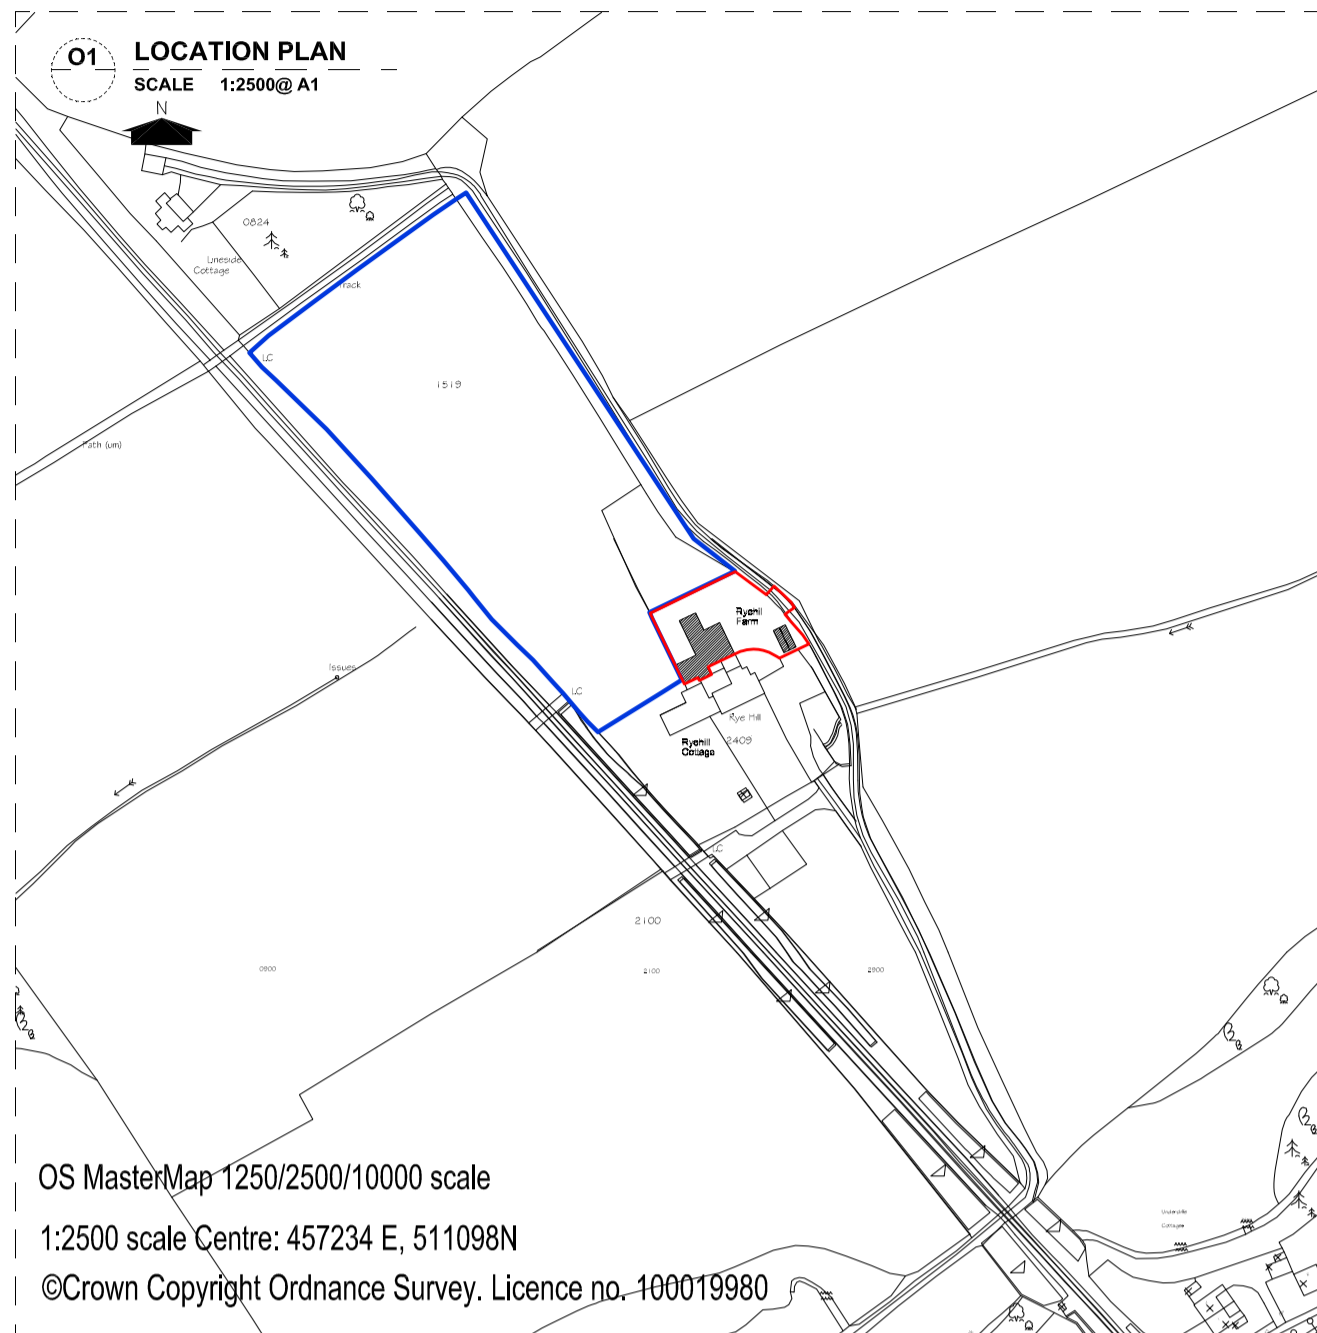


OS MasterMap 1250/2500/10000 scale
1:2500 scale Centre: 457234 E, 511098N
©Crown Copyright Ordnance Survey. Licence no. 100019980

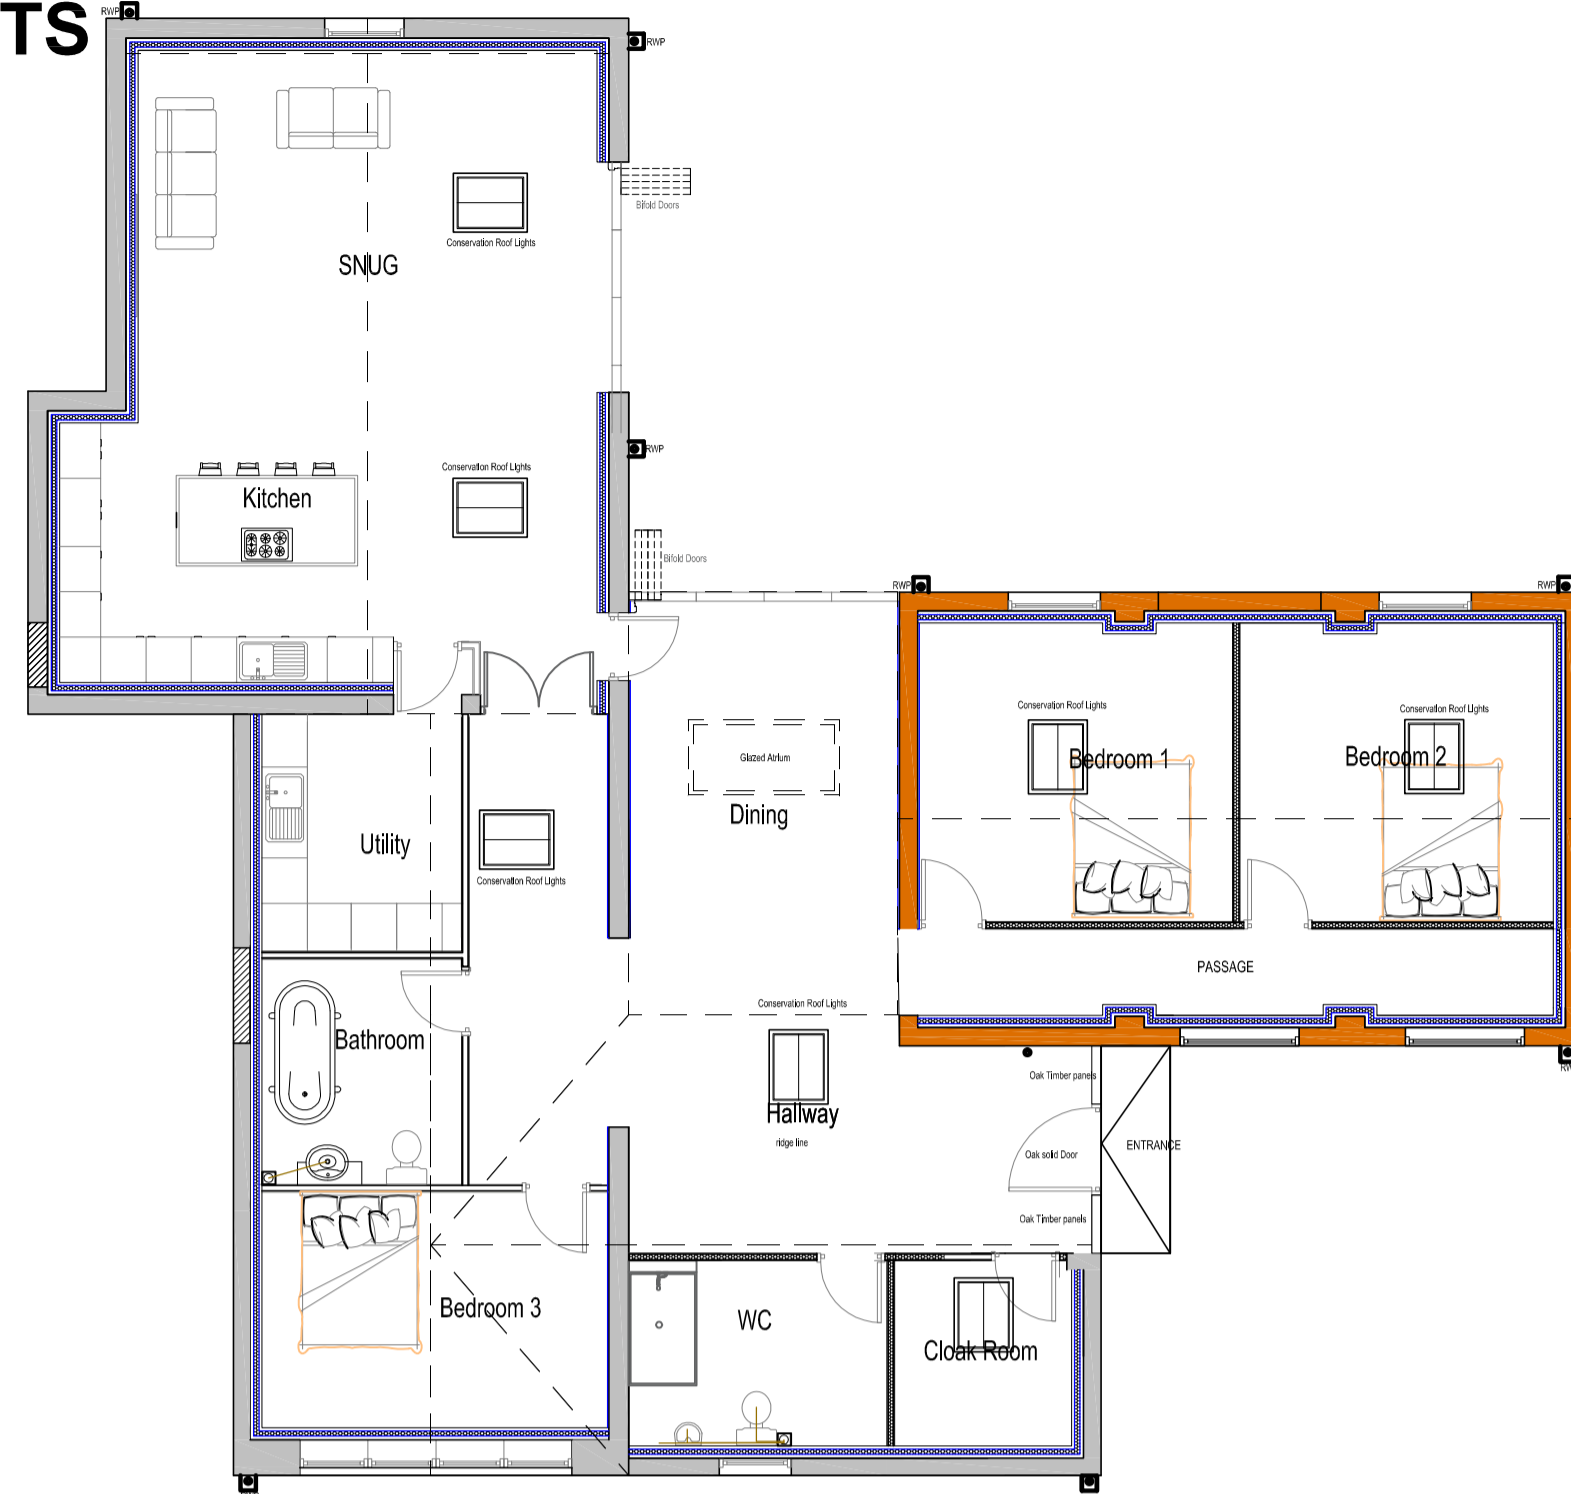


Proposed Ground Floor Plan

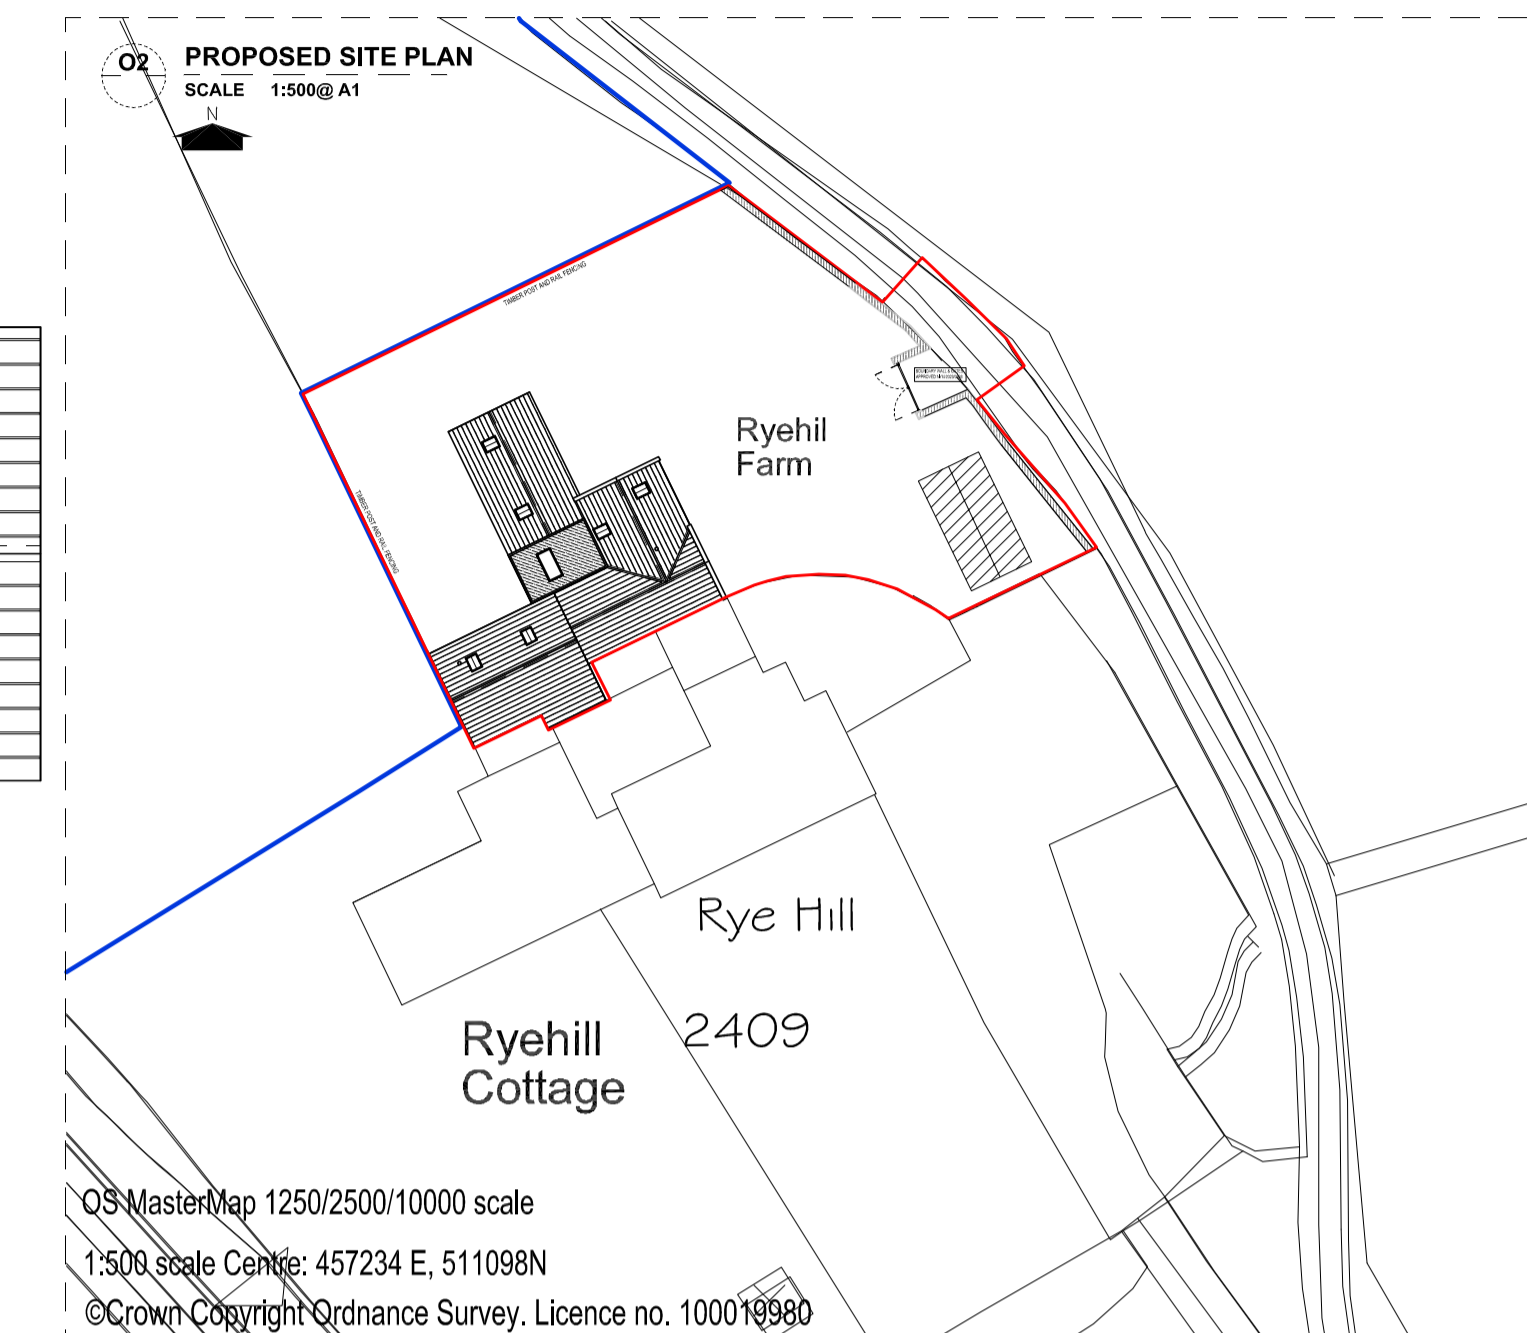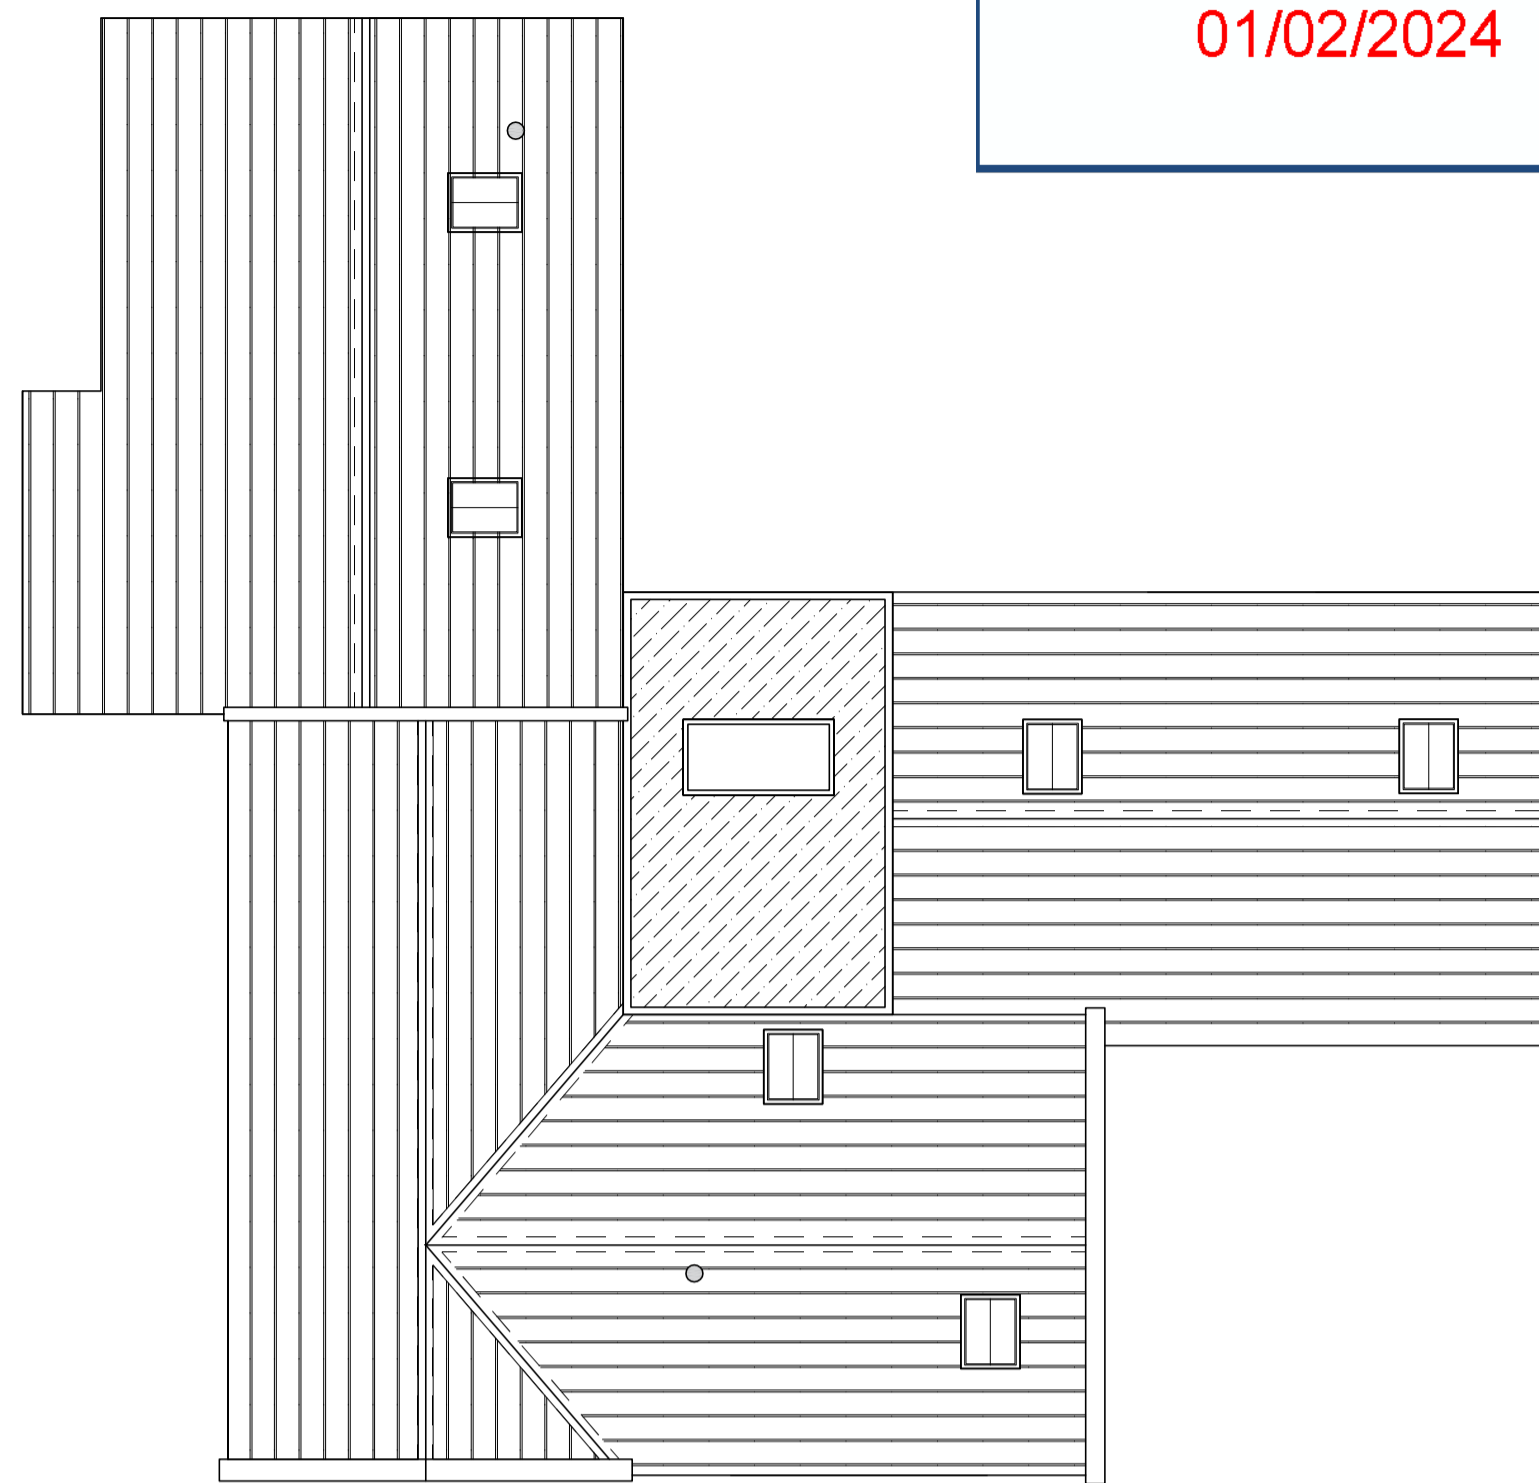


OS MasterMap 1250/2500/10000 scale
1:500 scale Centre: 457234 E, 511098N
©Crown Copyright Ordnance Survey. Licence no. 100019980

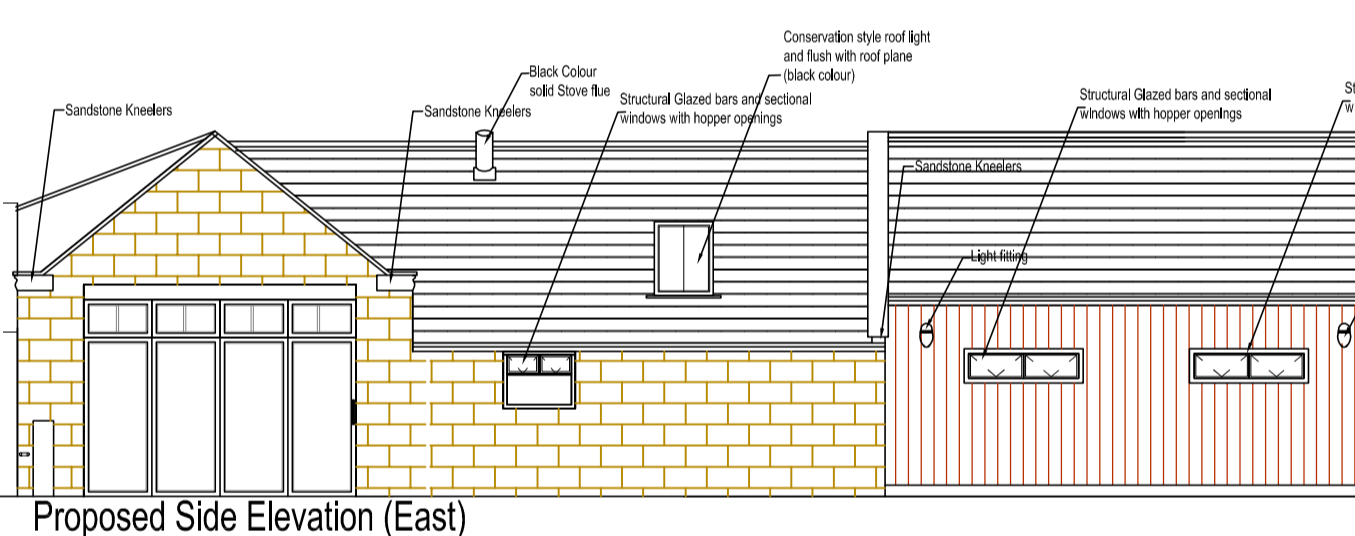


Proposed Side Elevation (East)

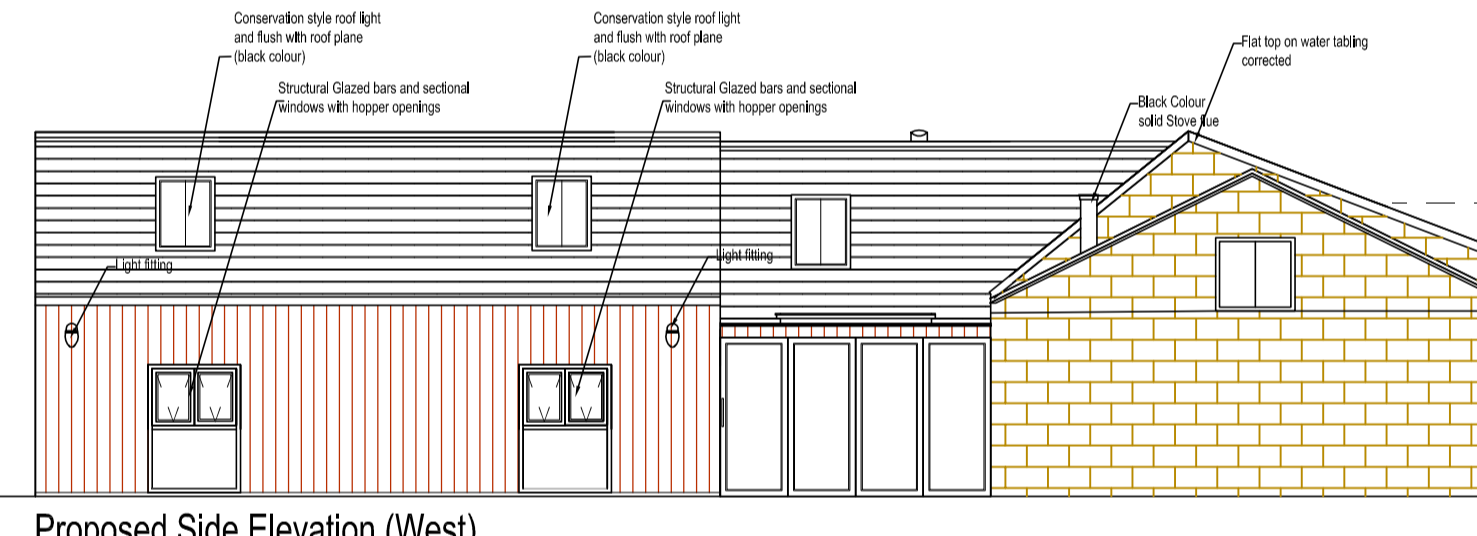


Proposed Side Elevation (West)

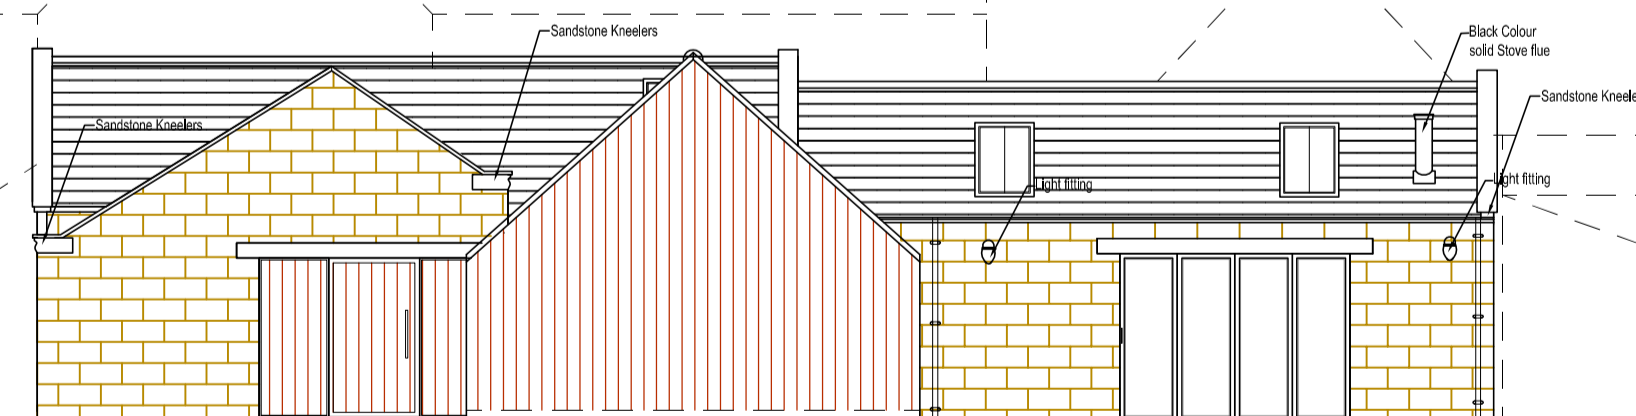


Proposed Front Elevation (north)

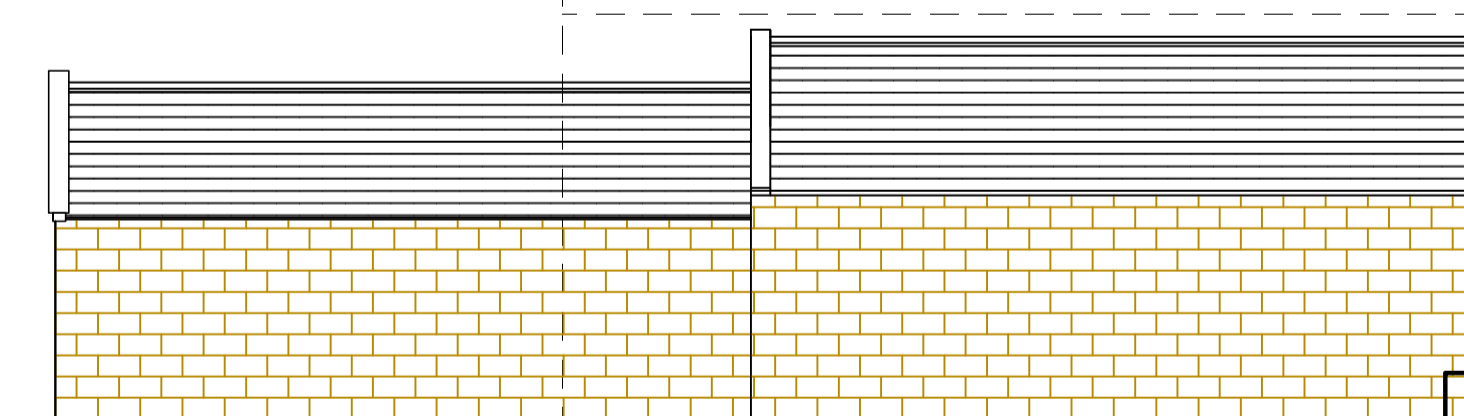


Proposed Rear Elevation South (partly obscured by neighbour)
1:100

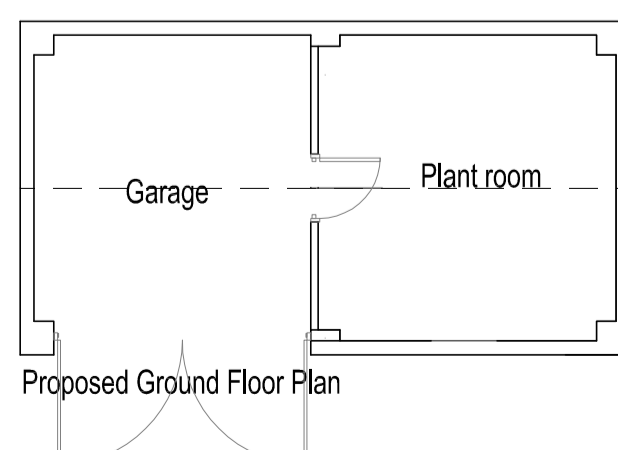


Proposed Ground Floor Plan

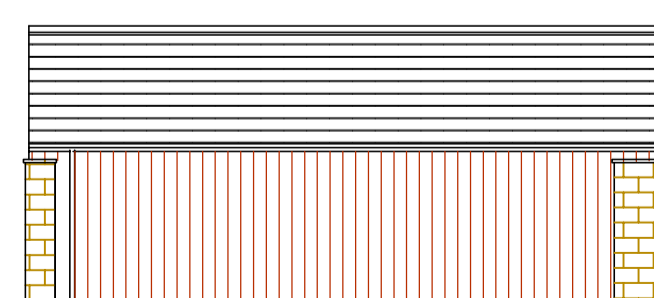


Proposed Rear Elevation

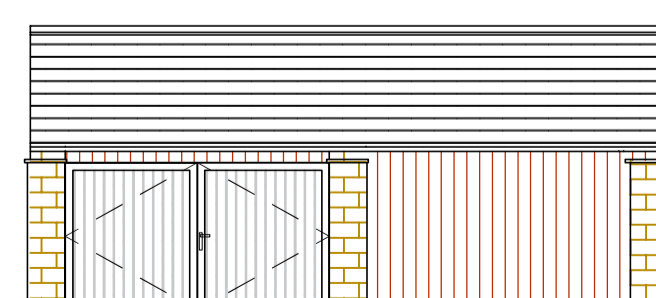


Proposed Front Elevation

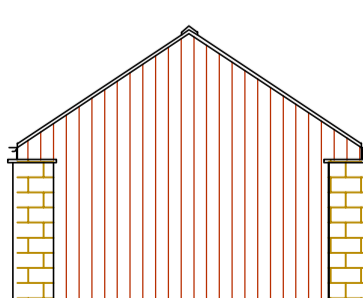

Proposed Side Elevation

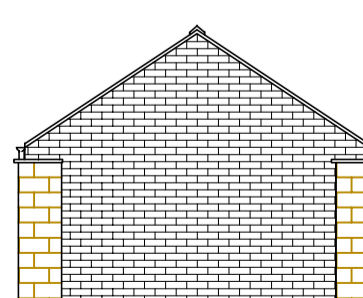

Proposed Side Elevation

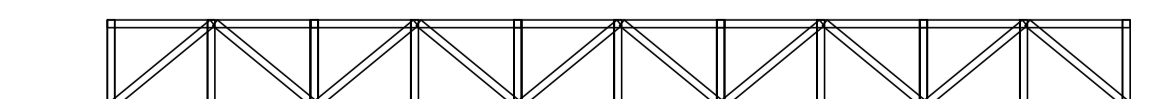

Timber Post and rail fence boundary treatment plan

TOTAL PLANNING SOLUTIONS (UK)
 5 ROMAN TERRACE, LINTHORPE,
 MEDLETHOROUGH, LEICESTERSHIRE, LE12 2GF
 Tel: 01532 845702
 Fax: 01532 550692
 Email: info@totalplanning.co.uk
 Web: www.totalplanning.co.uk
 Facebook: Total Planning Solutions UK Ltd

PROJECT: BARN CONVERSION
 LOCATION: RYEHILL FARM
 GREAT AYTON

SCALE: 1:2500; 1:500; 1:100 @A1
 DATE: JANUARY 2024
 DWG No: 002- AS BUILT PLAN
 DRAWN BY: FF