

Approved tractor shed section not to be built

○ **Proposed Floor Layout**
scale 1:100

NYMNP
30/05/2024

Rev.	Description	Date	Chk.



Bell Snoxell Building Consultants Ltd
Mortar Pit Farm
Sneatonthorpe
Whitby
North Yorkshire
YO22 5JG
T. 01947 880529
www.info@bell-snoxell.co.uk

Project: **Stainsacre Hall**
Stainsacre
Whitby

Client: **Mr Collinson**

Drawing: **Proposed Stable Block**
Floor Layout

Date: **May 2024** Scale@A3: **1:100**


Drawn By: **LS** Check By: **N/A** Approved By:

Drawing Status: **Planning. Condition**

Job. no. **8115** Dwg. no. **Rev 02** Rev.

A01. These notes are intended to augment drawings and specifications. Where conflict of requirements exists the order of precedence shall be as shown in the specification. Otherwise the strictest provision shall govern.
A02. This drawing to be read in conjunction with all other relevant drawings.
A03. Drawings not to be scaled. All dimensions to be checked on site by the contractor. Any discrepancies to be notified to the surveyor and further instructions obtained before work is commenced.
No part of this drawing may be reproduced, stored in a retrieval system or transmitted in any form or by any means without prior permission in writing from Bell-Snoxell Associates Ltd.



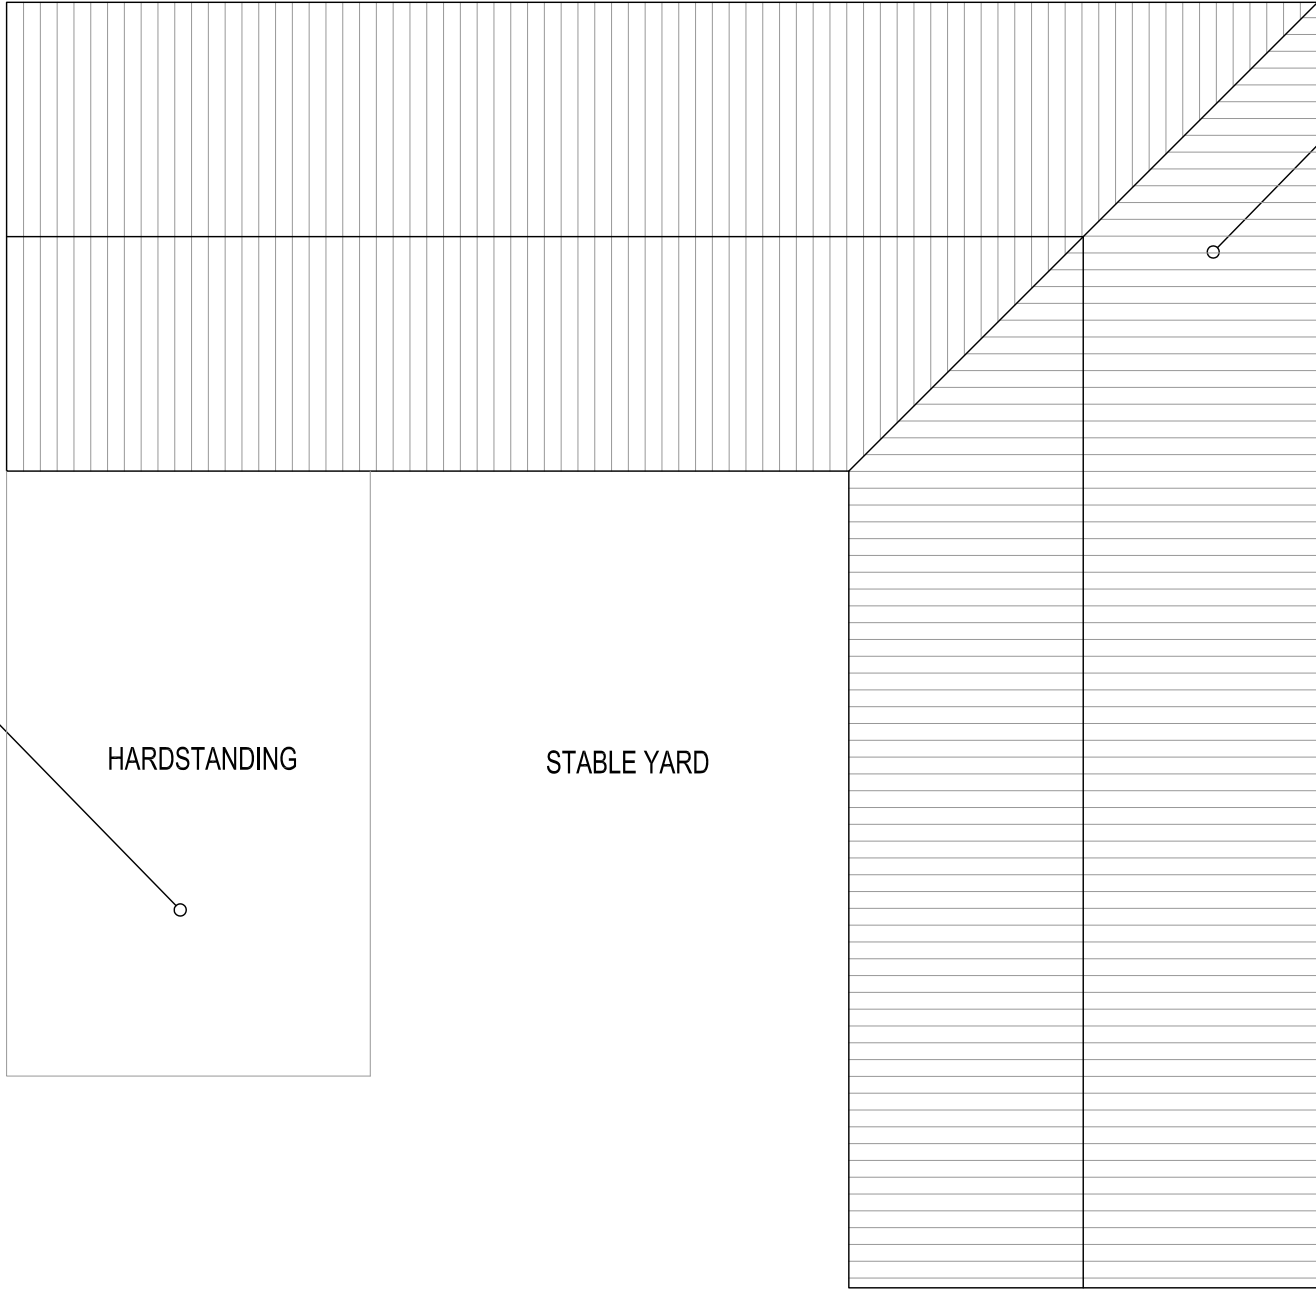

Approved tractor shed section not to be built

HARDSTANDING

STABLE YARD

Dark green insulated steel roof sheets

NYMNP
30/05/2024

Rev.	Description	Date	Chk.

Bell Snoxell Building Consultants Ltd

Bell Snoxell Building Consultants Ltd
Mortar Pit Farm
Sneatonthorpe
Whitby
North Yorkshire
YO22 5JG
T. 01947 880529
www.info@bell-snoxell.co.uk

Project: **Stainsacre Hall**
Stainsacre
Whitby

Client: **Mr Collinson**

Drawing: **Proposed Stable Block**
Roof Plan

Date: **May 2024** Scale@A3: **1:100**


Drawn By: **LS** Check By: **N/A** Approved By:


Drawing Status: **Planning. Condition**

Job. no. **8115** Dwg. no. **Rev 03** Rev.


Proposed Roof Plan
scale 1:100

A01. These notes are intended to augment drawings and specifications. Where conflict of requirements exists the order of precedence shall be as shown in the specification. Otherwise the strictest provision shall govern.
A02. This drawing to be read in conjunction with all other relevant drawings.
A03. Drawings not to be scaled. All dimensions to be checked on site by the contractor. Any discrepancies to be notified to the surveyor and further instructions obtained before work is commenced.
No part of this drawing may be reproduced, stored in a retrieval system or transmitted in any form or by any means without prior permission in writing from Bell-Snoxell Associates Ltd.

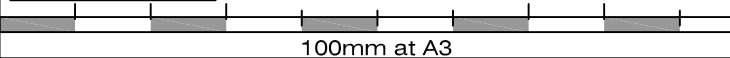


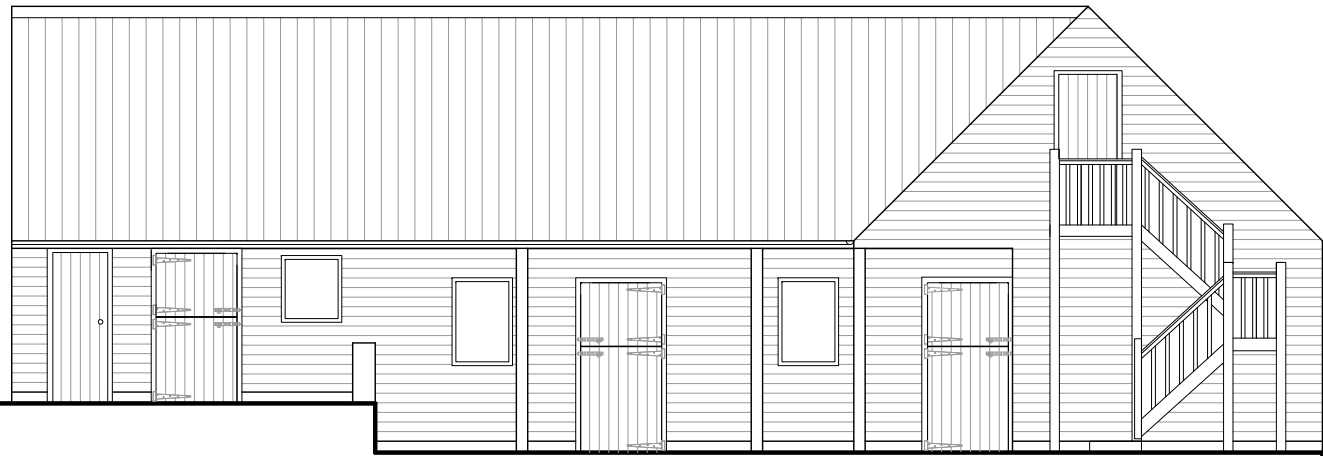

Proposed North Elevation
scale 1:100

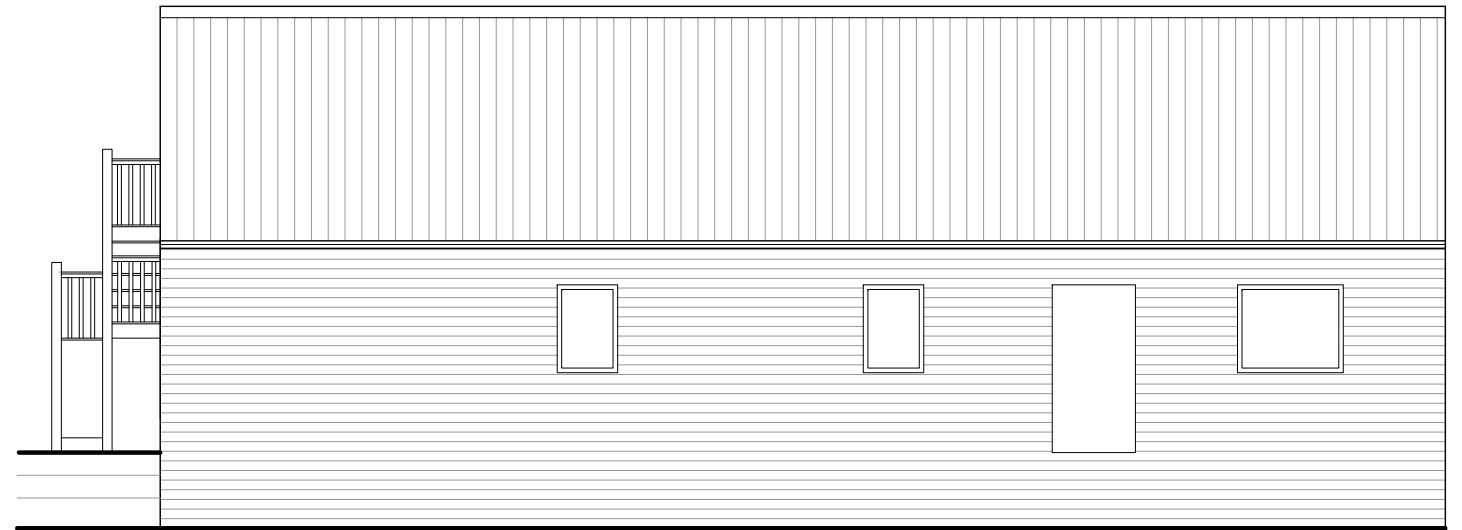

Proposed West Elevation
scale 1:100

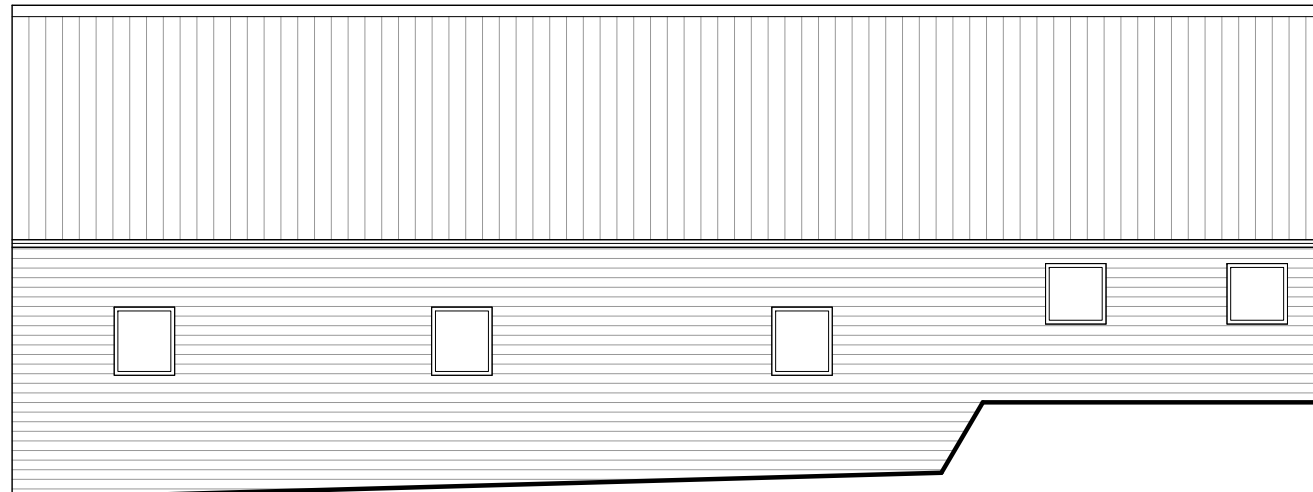

Proposed South Elevation
scale 1:100



Proposed East Elevation
scale 1:100

Materials:

- dark green insulated steel roof sheets
- horizontal timber cladding to block walls
- timber framed external stair
- timber framed doors and windows
- concrete floor slab

As built photograph



Design:

- conventional low impact design
- sits low in the landscape and shielded by trees
- green roof sheets and brown timber walls make it blend in with surroundings
- scale of the building reduced with tractor shed not built to allow more natural daylight to stables

Rev.	Description	Date	Chk.

Bell Snoxell Building Consultants Ltd

Bell Snoxell Building Consultants Ltd
Mortar Pit Farm
Sneatonthorpe
Whitby
North Yorkshire
YO22 5JG
T. 01947 880529
www.info@bell-snoxell.co.uk

Project: Stainsacre Hall
Stainsacre
Whitby

Client: Mr Collinson

Drawing: Proposed Stable Block Elevations

Date: May 2024 Scale@A3: 1:100

Drawn By: LS Check By: N/A Approved By:

Drawing Status: **Planning. Condition**

Job. no. 8115 Dwg. no. Rev 04

A01. These notes are intended to augment drawings and specifications. Where conflict of requirements exists the order of precedence shall be as shown in the specification. Otherwise the strictest provision shall govern.
A02. This drawing to be read in conjunction with all other relevant drawings.
A03. Drawings not to be scaled. All dimensions to be checked on site by the contractor. Any discrepancies to be notified to the surveyor and further instructions obtained before work is commenced.
No part of this drawing may be reproduced, stored in a retrieval system or transmitted in any form or by any means without prior permission in writing from Bell-Snoxell Associates Ltd.
100mm at A3

NYMNPA
30/05/2024