

Amendments/Additional Information

Amended layout of buildings/outside areas

Additional background information

Amended design


Revised access arrangements

Change of description of proposed development

Change in site boundaries

Other (as specified below)

Location Plan of high Farm, Newholm, Whitby

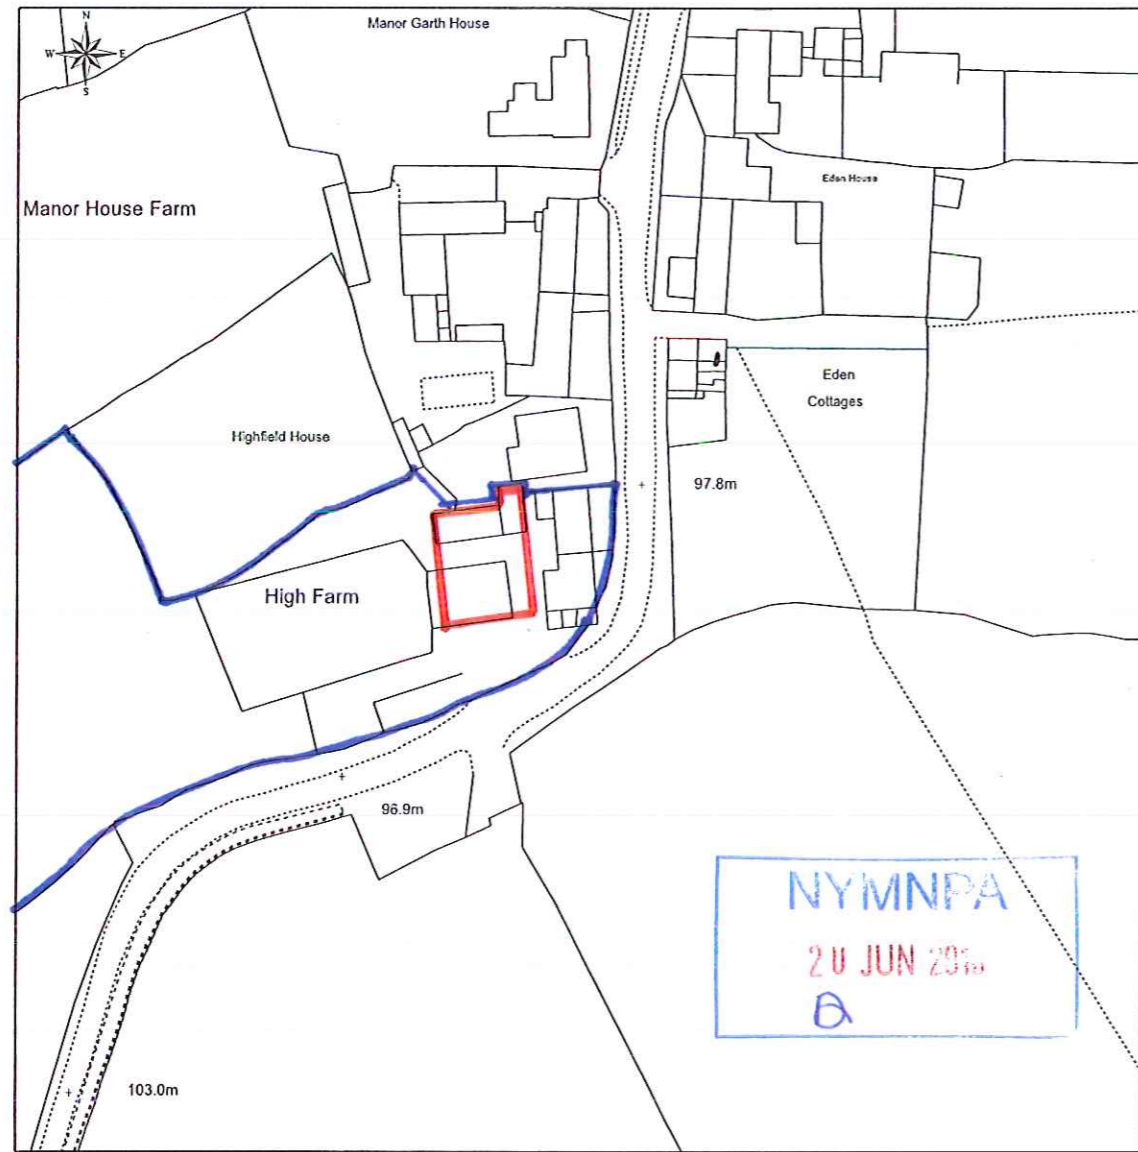

This Plan includes the following Licensed Data: OS MasterMap Black and White PDF Location Plan by the Ordnance Survey National Geographic Database and incorporating surveyed revision available at the date of production. Reproduction in whole or in part is prohibited without the prior permission of Ordnance Survey. The representation of a road, track or path is no evidence of a right of way. The representation of features, as lines is no evidence of a property boundary. © Crown copyright and database rights, 2016. Ordnance Survey 0100031673

Scale: 1:1250, paper size: A4


REV. A. Blue line indicating area of land of applicants ownership amended. Jun 16.

AMENDED


Notes

plans ahead by emapsite™


Prepared by: Bill Henderson, 16-03-2016

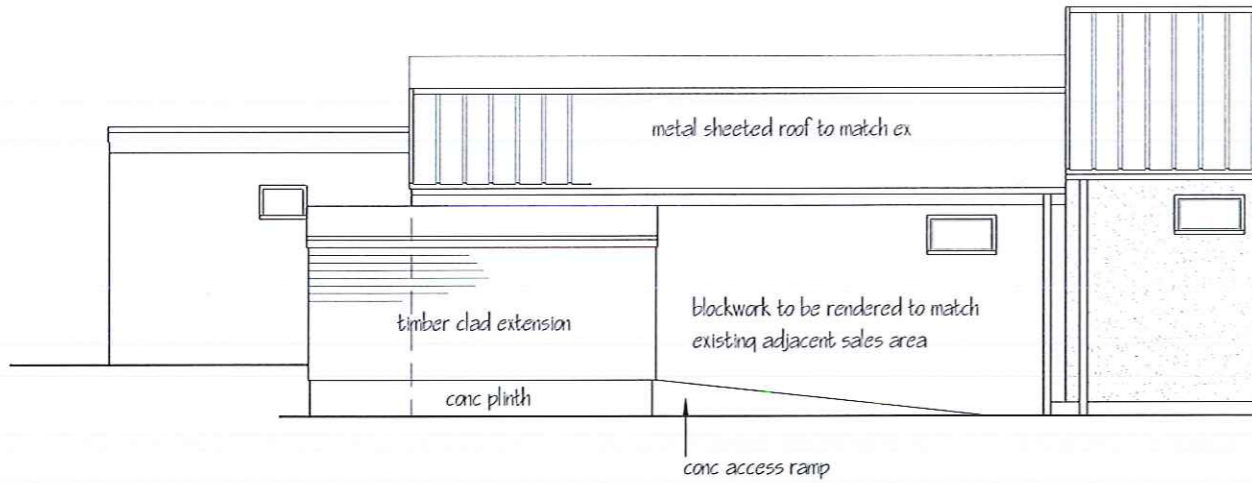

Left Hand Side Elevation A

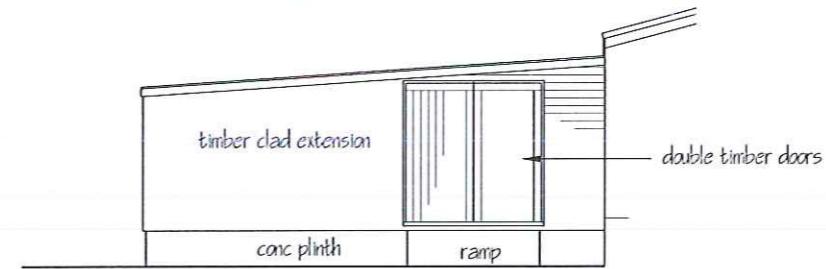

Left Hand Side Elevation E

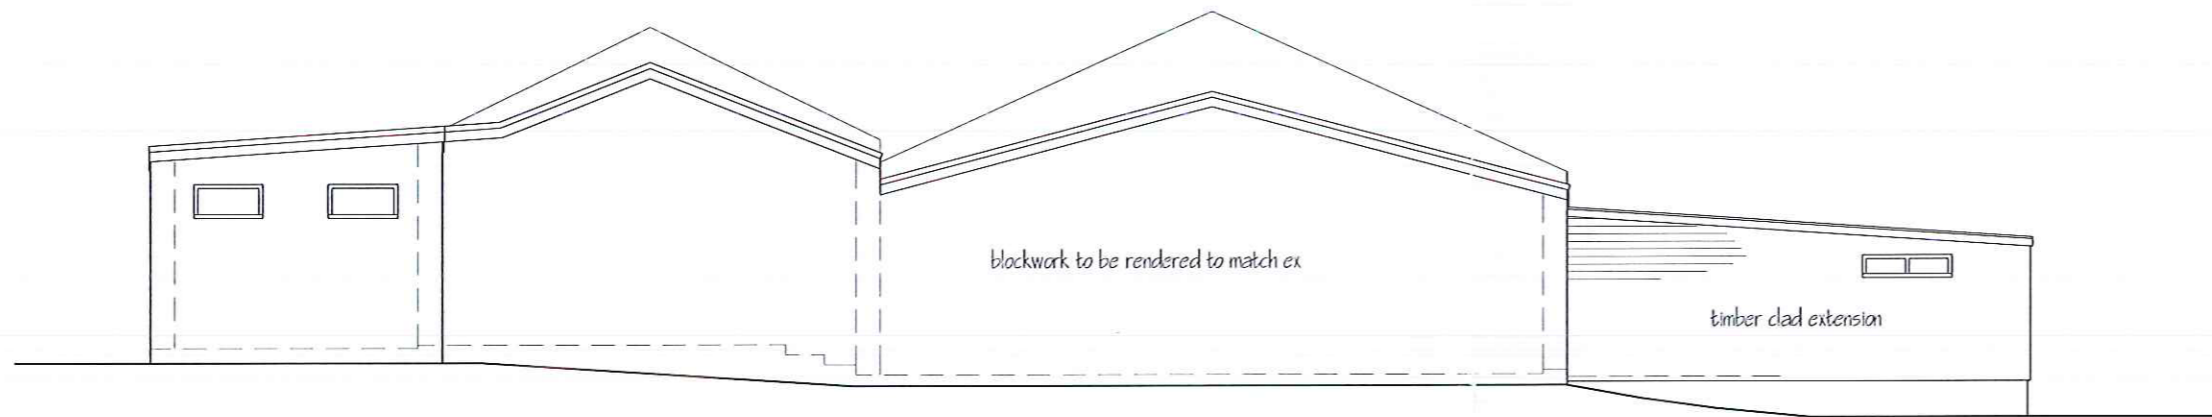


Rear Elevation B


AMENDED

Notes

NYMNPA
20 JUN 2016

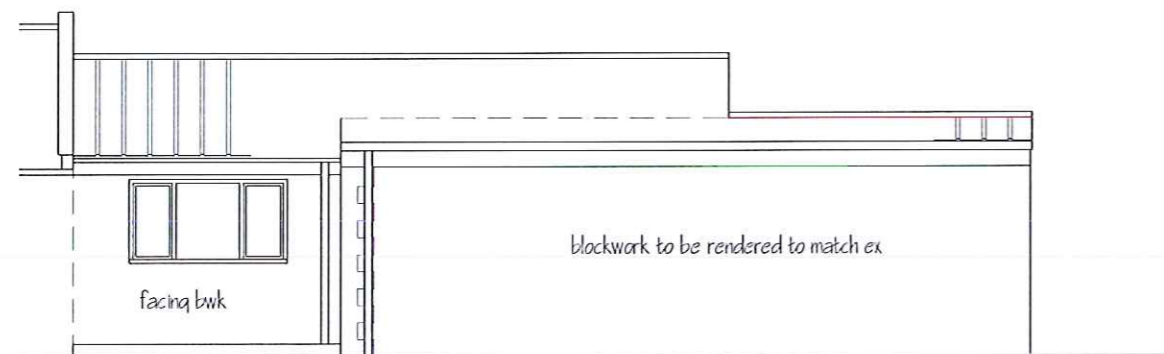

Right Hand Side Elevation C

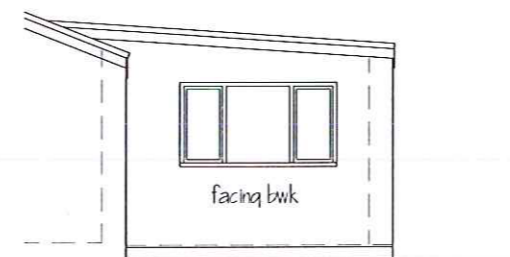

Elevation facing frontage D

Rev A Side storage room ext shown, and elevation E added Jun 16

| | | | | |
|------------|---|-------------|--------|-------|
| Applicant | Ms P Richardson, High Farm, Newholm Whitby YO21 3QY | | | |
| Project | Tea Room / Retail Craft Sales Area Extension | | | |
| Drawing | Elevations as built | | | |
| Job No 383 | Sheet no 2 | Scale 1:100 | Mar 16 | Rev A |


This drawing is for the purpose of obtaining Planning & or Building Regulation approval only. Read this drwg in conjunction with the construction specification & "Robust details"
 NOTE Any work carried out prior to the granting of any required regulatory approvals, including the satisfying of any associated conditions is undertaken entirely @ the applicants own risk

Spectrum Design Tel

Architectural Design, Planning &
Building Regulation Applications



Spectrum Design
E-Mail spectrum_design@hotmail.com

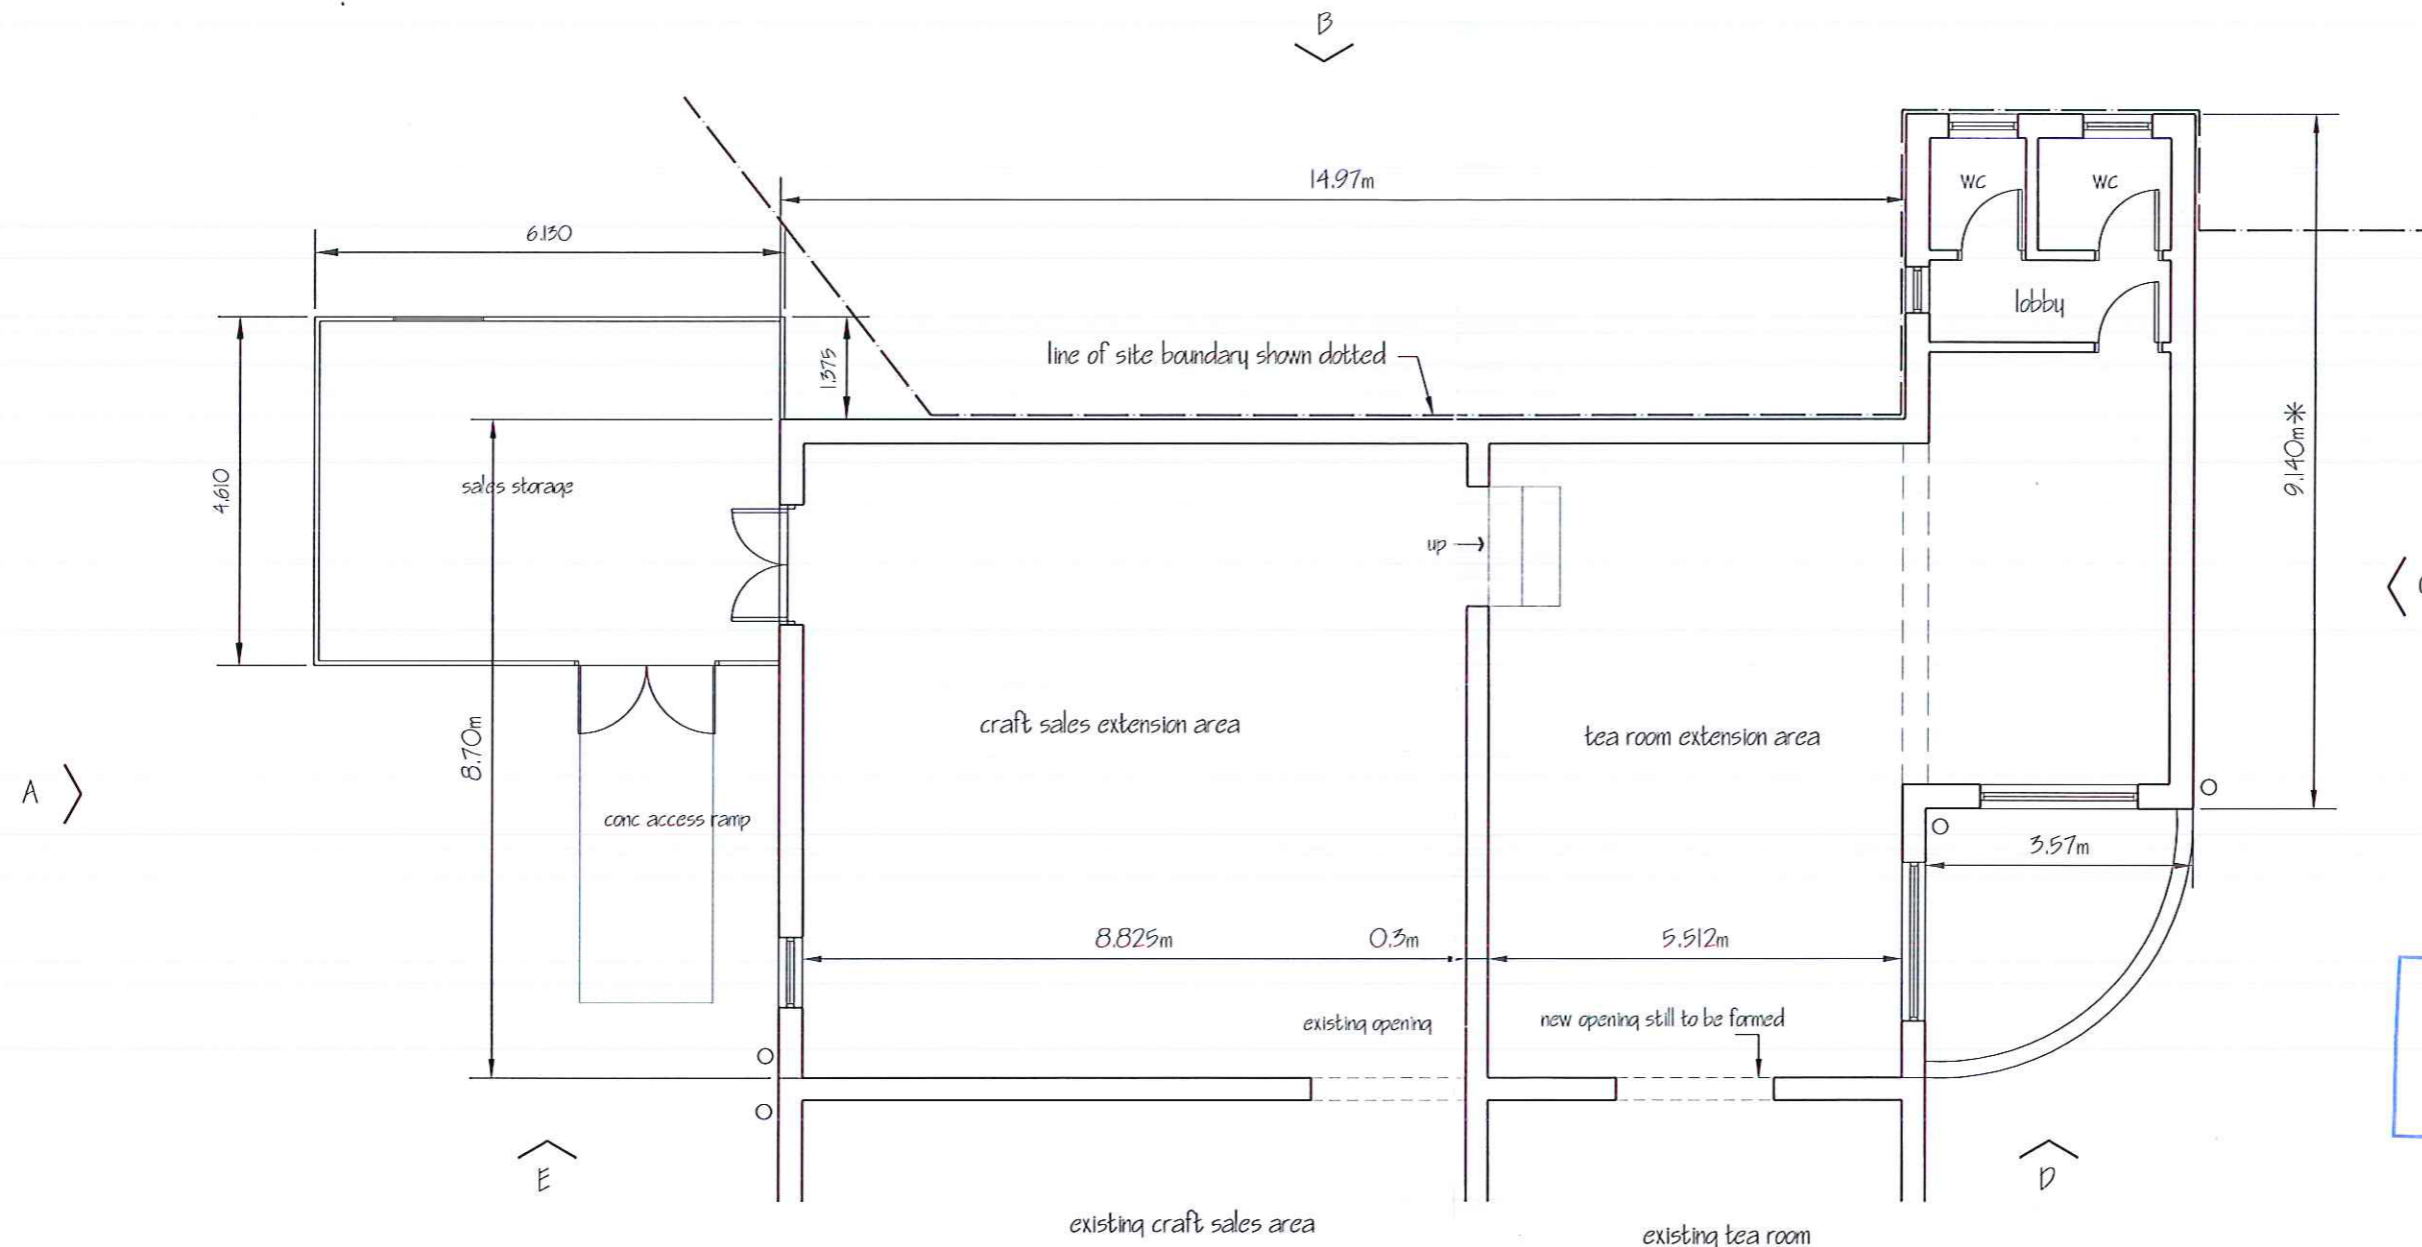

NYMNP
 20 JUN 2016

Rev B Side storage room ext added, wc's within ext shown, and site boundary line added Jun 16

Rev A Dimension marked thus* amended March 16

AMENDED

Notes

| | |
|-------------|---|
| Applicant | Ms P Richardson, High Farm, Newholm Whitby YO21 3QY |
| Project | Tea Room / Retail Craft Sales Area Extension |
| Drawing | Extension Plan as built |
| Job No 383 | Sheet no 1 |
| Scale 1:100 | Mar 16 |
| Rev B | |

This drawing is for the purpose of obtaining Planning & or Building Regulation approval only Read this drwg in conjunction with the construction specification & "Robust details"
 NOTE Any work carried out prior to the granting of any required regulatory approvals, including the satisfying of any associated conditions is undertaken entirely @ the applicants own risk



Spectrum Design

Architectural Design, Planning &
Building Regulation Applications

NYMNPA

0

F.A.O. HILARY SAUNDERS
PLANNING DEPT

HC

HIGH FARM, NEWHOLM NYM/2016/0057/FL

amended plans & deviations for HC above
as requested.

With Compliments

W.J Henderson 12 Willow Close, Saltburn-by-the-sea, Cleveland, TS12 1PB