

Amendments/Additional Information

Amended layout of buildings/outside areas

Additional background information

Amended design

Revised access arrangements

Change of description of proposed development

Change in site boundaries

Other (as specified below)

AT

Dawn Paton

From: Claire Eynon
Sent: 06 September 2016 16:30
To: Planning
Subject: E10951-17 NYMNP 06.09.16 NYM/2016/0397/FL
Attachments: D10951-01D.pdf

Dear Ailsa

Your ref: NYM/2016/0397/FL 1 Ivy Cottage, Green End Goathland

Further to your letter dated 5th September 2016 please find attached a revised copy of the site plan.

If you require anything further please do not hesitate to contact us.

Regards


Claire Eynon
Architectural Technician

The information contained in this email is intended only for the person or entity to whom it is addressed and may contain confidential and/or privileged material. If you have received this email in error please note that any review, retransmission, copying, dissemination or other use of, or taking of any action in reliance upon its contents is prohibited. If you are not an intended recipient please delete the material from any computer that may have it and contact BHD Partnership IT Personnel on 01947 829317, thank you for your co-operation.

The contents of an attachment to this email may contain software viruses which could damage your computer system. We cannot accept liability for any damage which you sustain as a result of software viruses, you should carry out your own virus checks before opening any attachment.


BHD Partnership, Airy Hill Manor, Whitby, North Yorkshire, YO21 1QB

NYMNP
- 6 SEP 2016

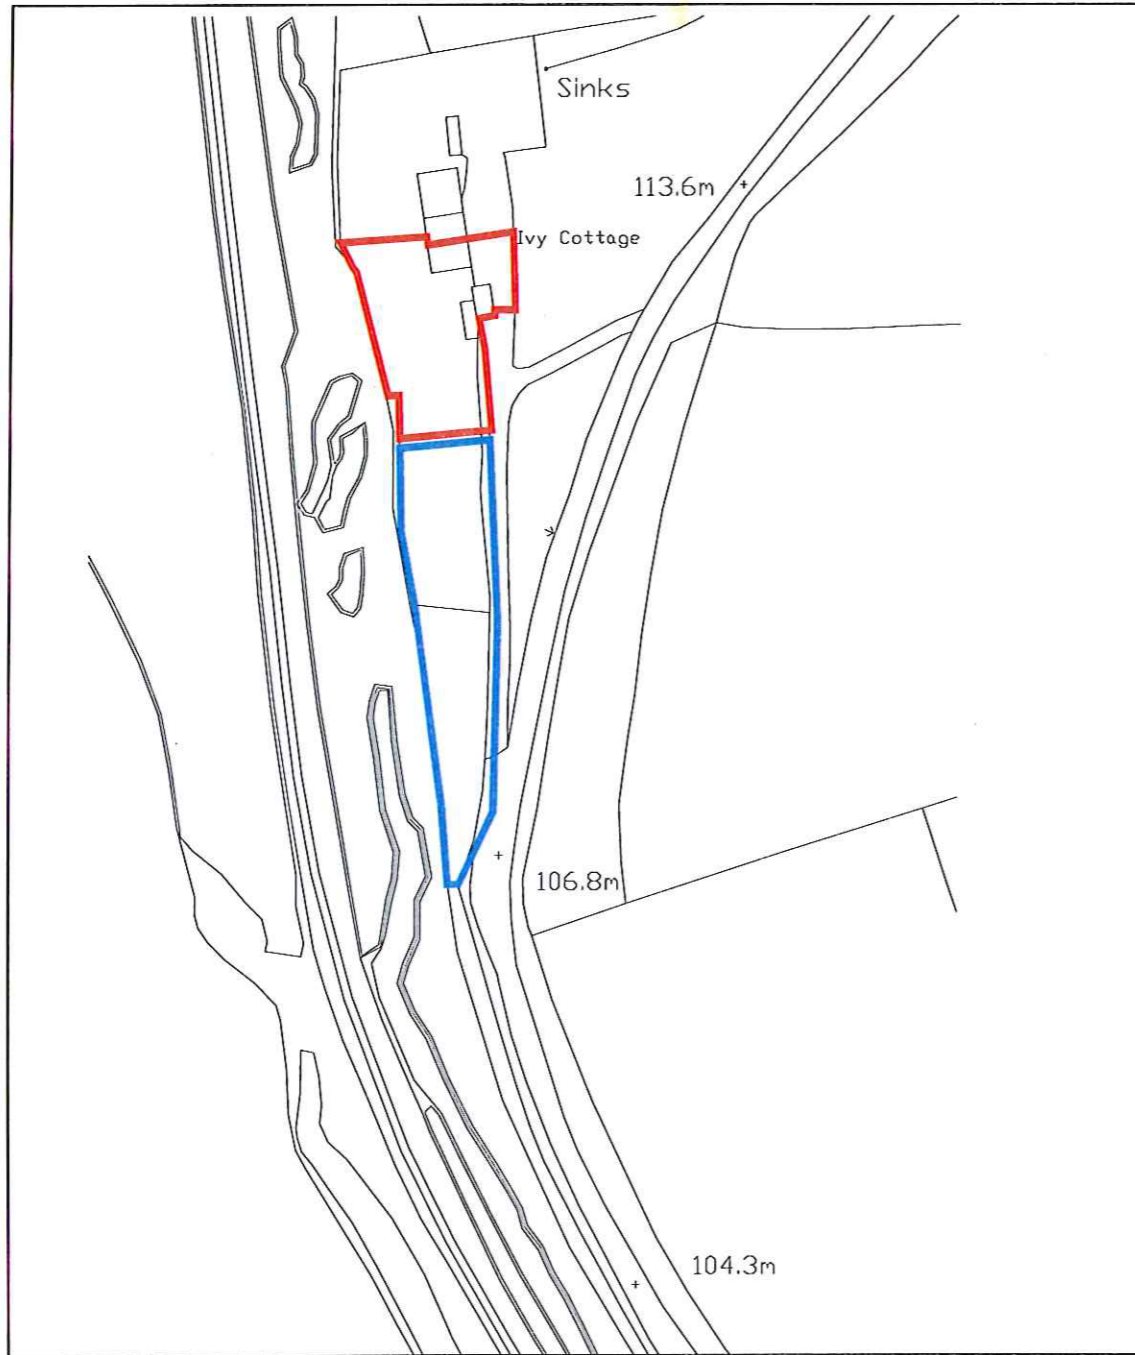

Site Plan

Scale 1:1250

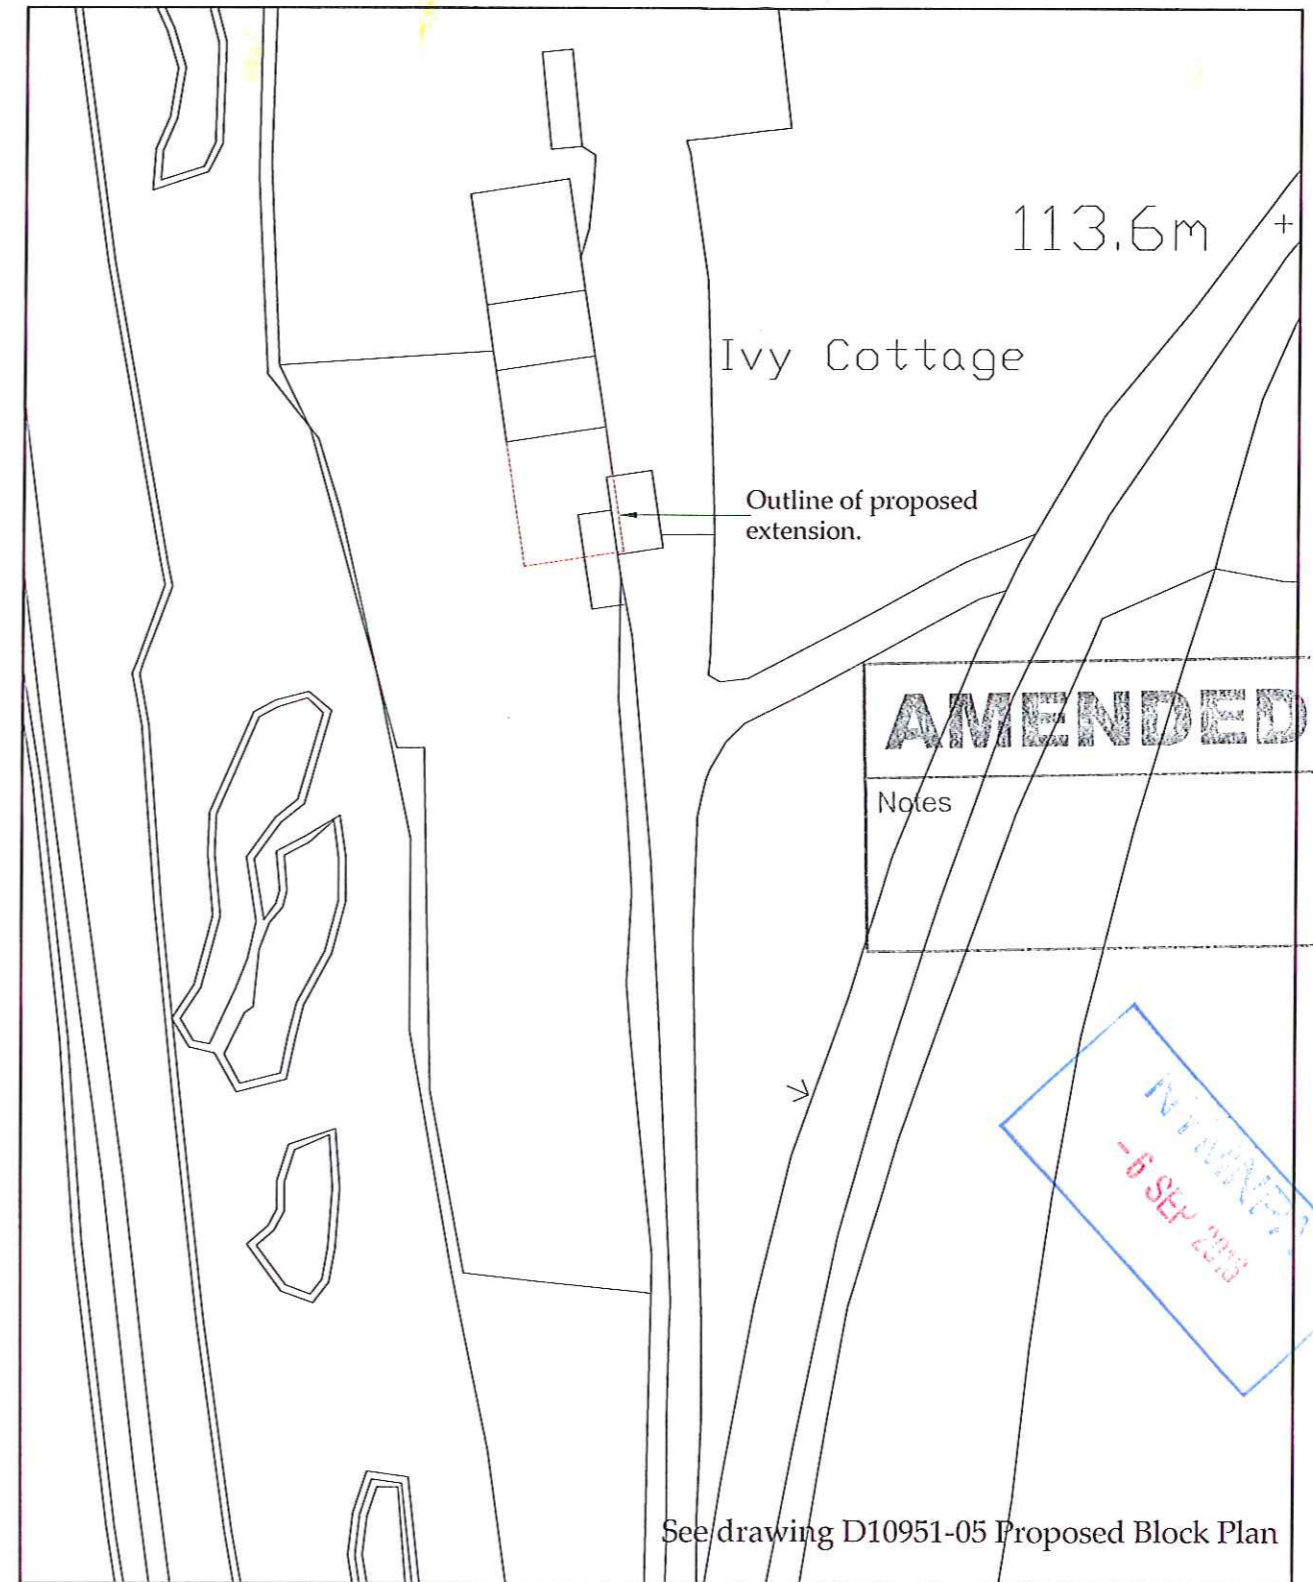

Block Plan

Scale 1:500

AMENDED
Notes

REVISED
- 6 SEP 2016

See drawing D10951-05 Proposed Block Plan

Ordnance Survey Licence No. 100002562

b h d partnership
Airtv Hill Manr. Whithv. North Yorkshire, UK, YO21 1QB.

●DO NOT SCALE from this drawing. Only figured dimensions are to be taken from this drawing.
●The Contractor must verify all dimensions on site before commencing any work or shop drawings.
The Contractor must report any discrepancies before commencing work. If this drawing exceeds the quantities taken in any way, the Technician is to be informed before work is initiated.
Work within The Construction (Design and Management) Regulations 2015 is not to start until a Health & Safety Plan has been produced. This drawing is Copyright and must not be reproduced without consent of BHD Partnership Ltd

REV	DATE	BY	AMENDMENT	CHKD	APVD
D	06/09/16	CE	Red line amended	NID	
C	26/08/16	NID	Amended Block plan		
B	01/06/16	nid	Red line and parking		
A	24/05/16	CE	Issued for approval	NID	

CLIENT:
Mr J Coulby & Ms K Nicholson

PROJECT:
1 Ivy Cottage Green end

A3 | DRN: C Eynon | DATE: 24/05/16
SCALE: As shown | ISSUE: Preliminary

DRAWING TITLE:
Site Plan and Block Plan

DRAWING NR:
D10951-01

REV:
D