


Approved  
-5 APR 2016


Rev A Dimension marked thus \* amended March 16

Applicant	Ms P Richardson, High Farm, Newholm Whitby YO21 3QY			
Project	Tea Room / Retail Craft Sales Area Extension			
Drawing	Extension Plan as built			
Job No 383	Sheet no 1	Scale 1:100	Mar 16	Rev A


This drawing is for the purpose of obtaining Planning & or Building Regulation approval only. Read this drwg in conjunction with the construction specification & "Robust details"  
 NOTE Any work carried out prior to the granting of any required regulatory approvals, including the satisfying of any associated conditions is undertaken entirely @ the applicants own risk

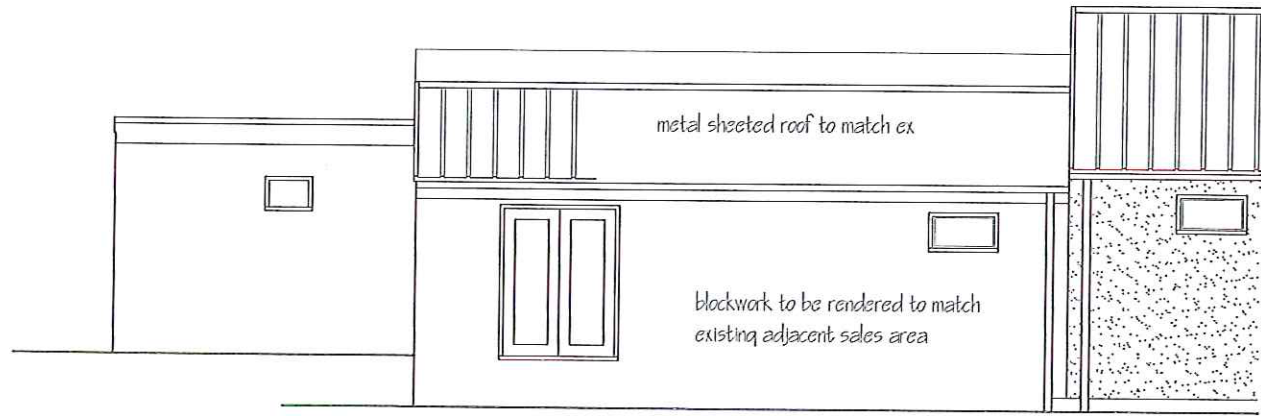


Left Hand Side Elevation A

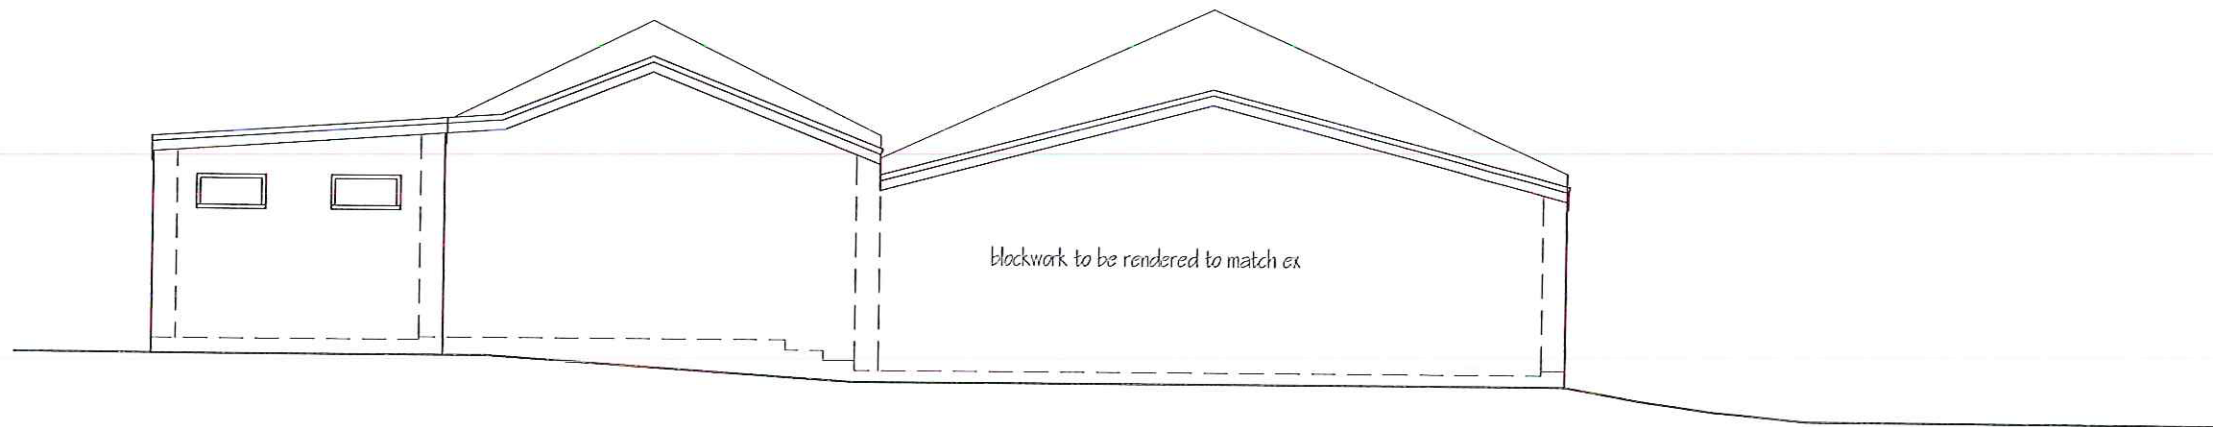

Rear Elevation B

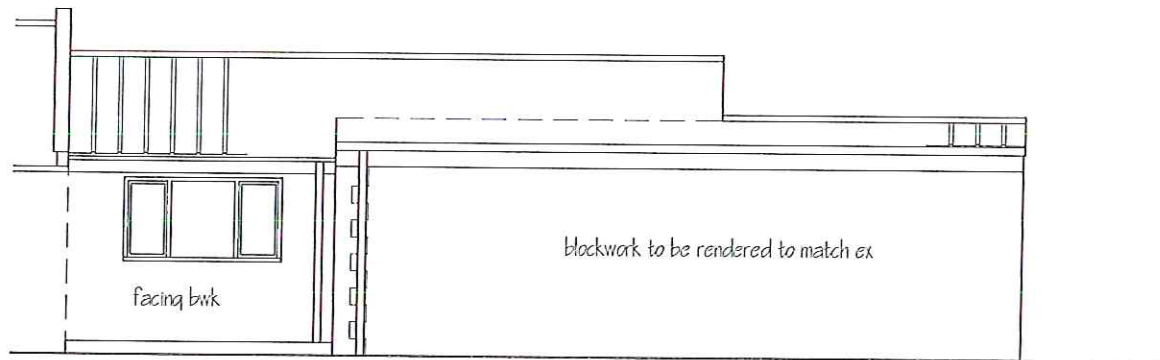

Right Hand Side Elevation C

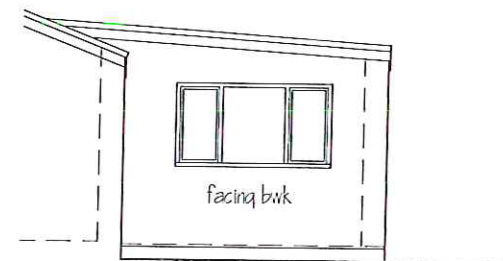

Elevation facing frontage D

18 MAR 2016

Applicant	Ms P Richardson, High Farm, Newholm Whitby YO21 3QY			
Project	Tea Room / Retail Craft Sales Area Extension			
Drawing	Elevations as built			
Job No 383	Sheet no 2	Scale 1:100	Mar 16	Rev

This drawing is for the purpose of obtaining Planning & or Building Regulation approval only. Read this drwg in conjunction with the construction specification & "Robust details".  
 NOTE Any work carried out prior to the granting of any required regulatory approvals, including the satisfying of any associated conditions is undertaken entirely @ the applicants own risk

Spectrum Design Tel 07527428594

Architectural Design, Planning &  
Building Regulation Applications

