


Do not scale off this drawing. All dimensions to be checked on site prior to manufacture and construction. This drawing is the property of Just-H Architects and should not be reproduced without permission. All discrepancies to be brought to the attention of the architect immediately. This drawing to be read in conjunction with the specification / bill of quantities and related drawings.

REVISION

FIRST ISSUE


14.11.16 RCO

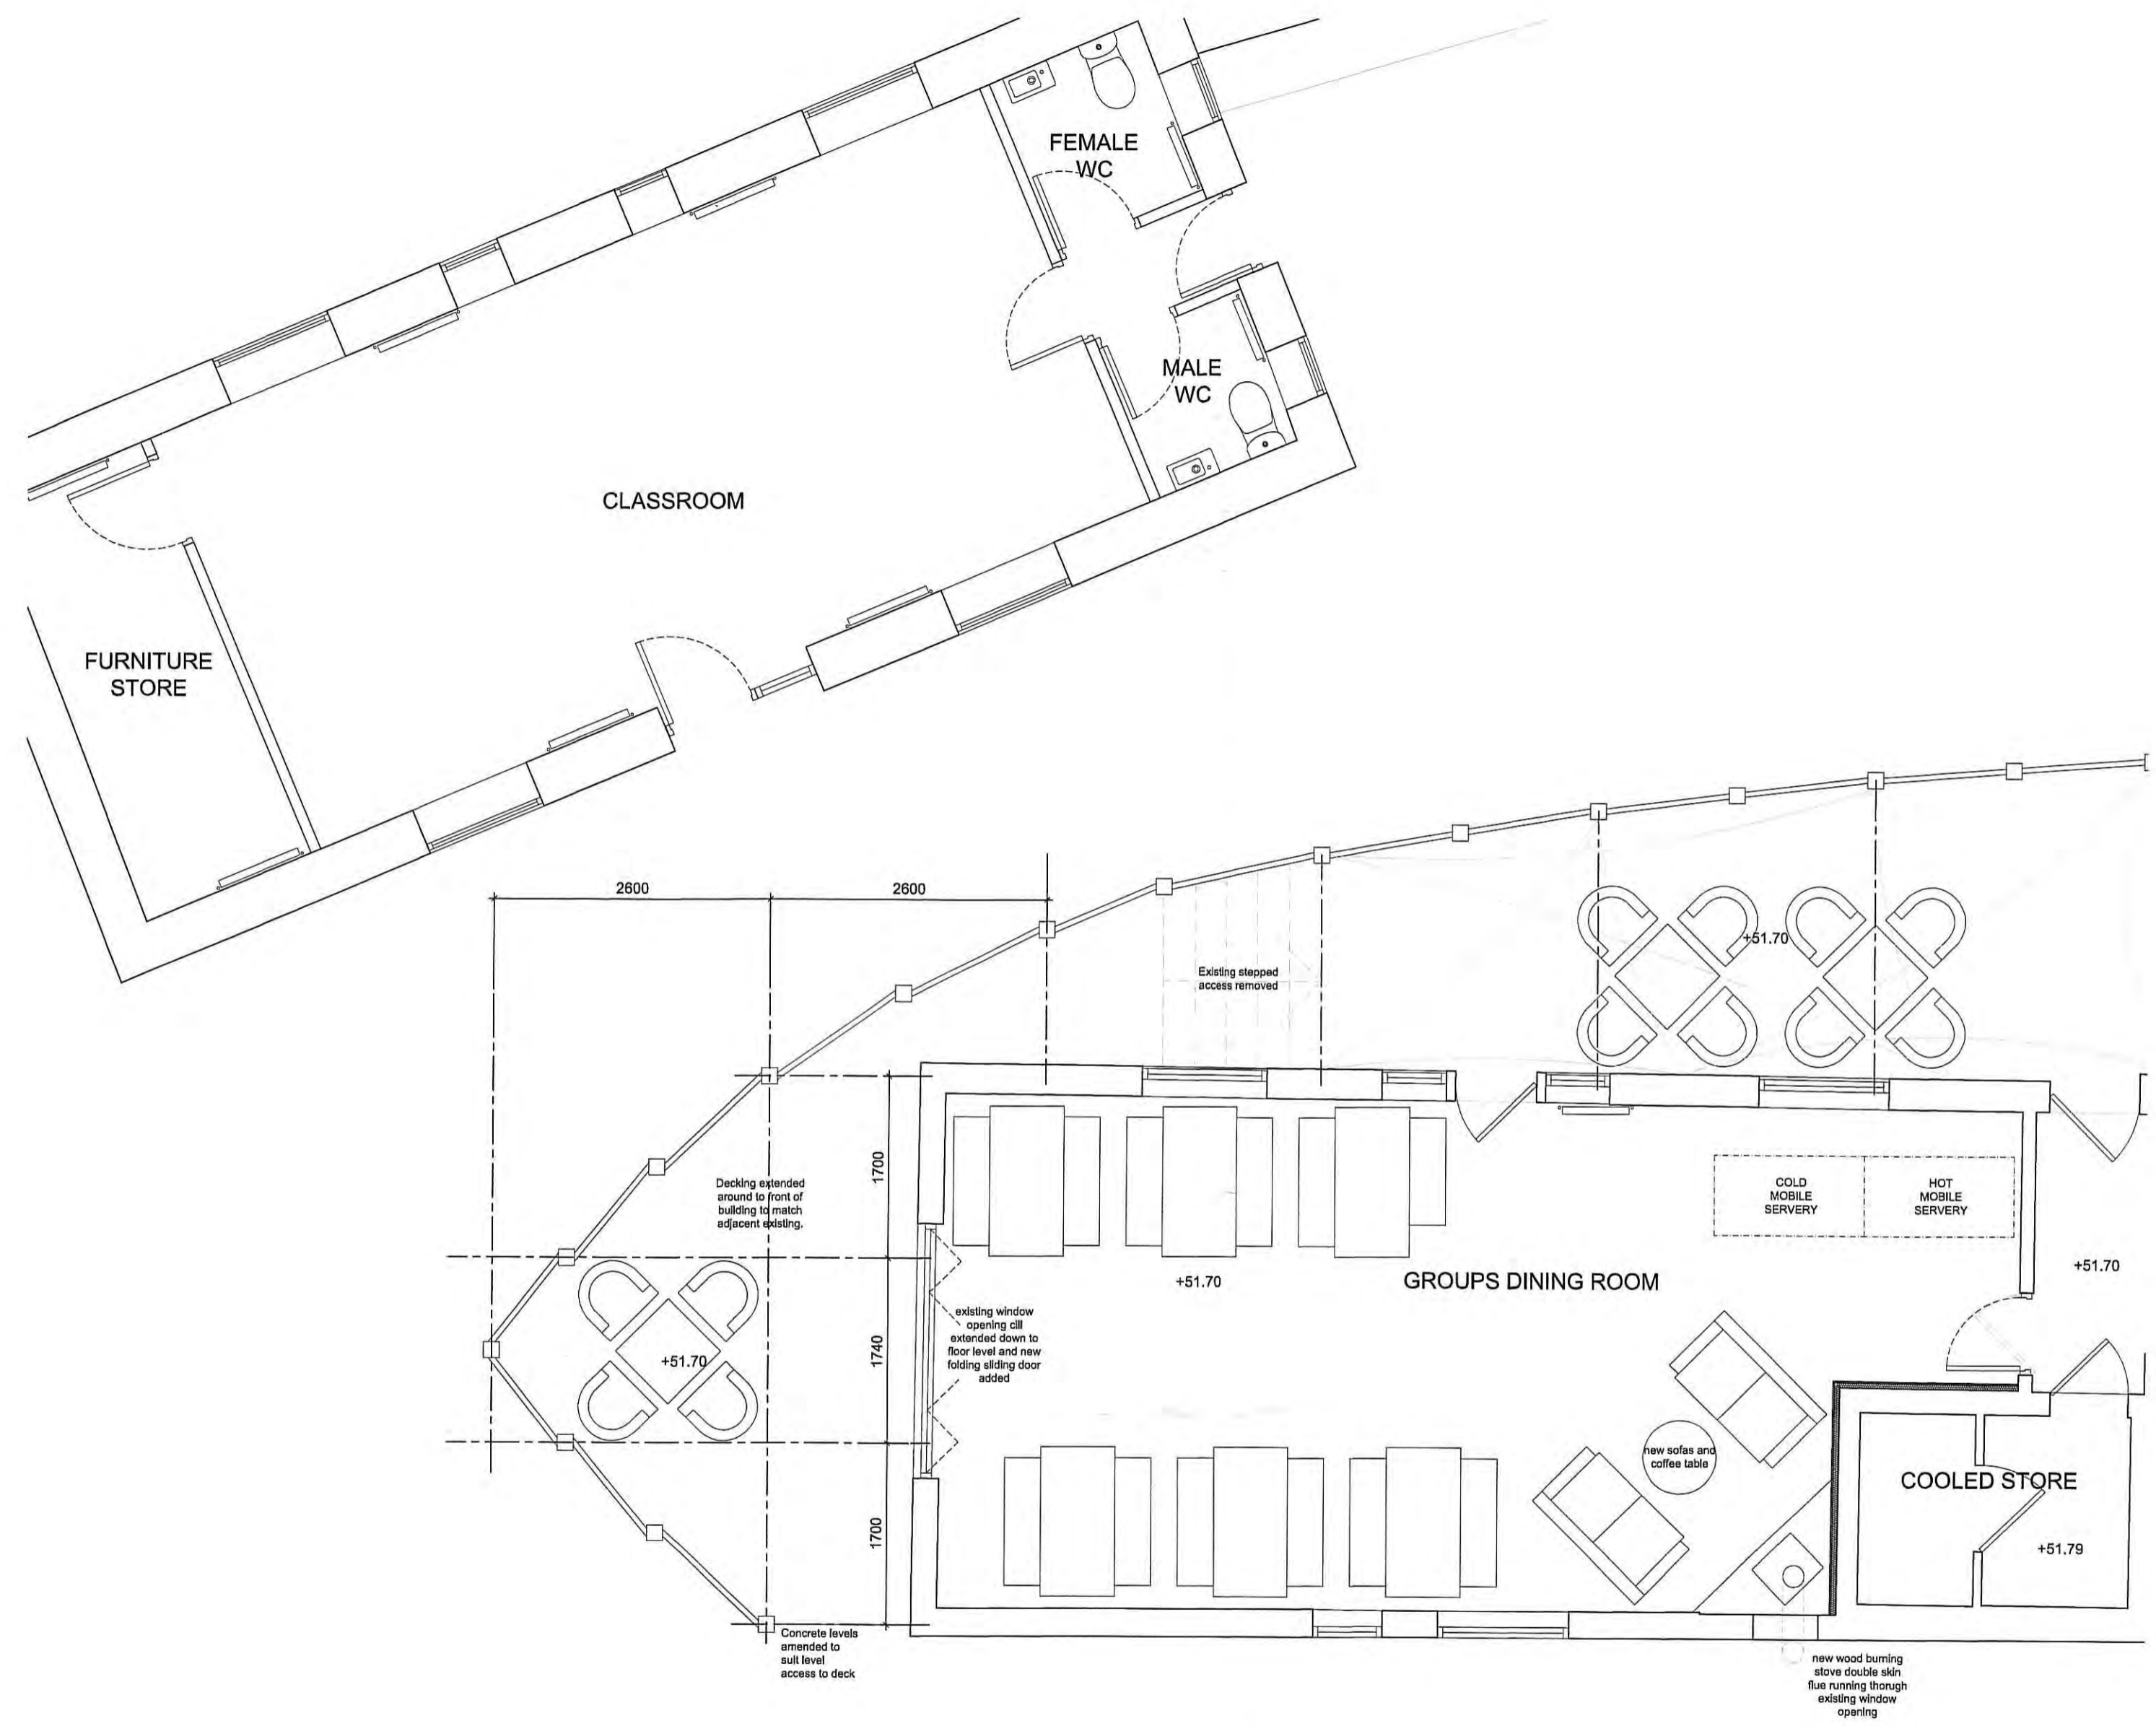

16 NOV 2016

16 NOV 2016

Proposed Ground Floor

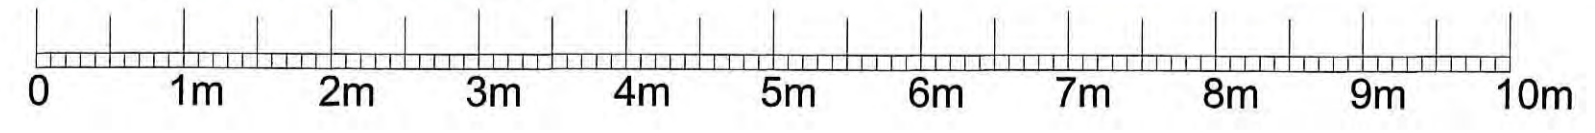

YHA (ENGLAND & WALES) LTD client

YHA BOGGLE HOLE, MILL BECK FYLINGTHORPE, WHITBY project

PROPOSED GROUPS DINING AND EXTENDED DECK title

YHA46 job No.

M-AL1.03 dwg No.

1:100 @ A2 scale


RCO drawn




3 Jordan Street Manchester M15 4PY

Do not scale off this drawing. All dimensions to be checked on site prior to manufacture and construction. This drawing is the property of Just-H Architects and should not be reproduced without permission. All discrepancies to be brought to the attention of the architect immediately. This drawing to be read in conjunction with the specification / bill of quantities and related drawings.

REVISION			
-	FIRST ISSUE	07.08.14	RCO
A	LAYOUT AMENDED FOLLOWING CLIENT FEEDBACK	14.08.14	RCO
B	COLD ROOM REINSTATED & KITCHEN UPDATED TO SPRINT SKETCH. FURNITURE TO GROUPS DINING AMENDED	19.08.14	RCO
C	RECEPTION & CANOPIES AMENDED, CONSTRUCTION DETAIL ADDED	01.09.14	RCO
D	TENDER ISSUE	05.09.14	RCO
E	CONSTRUCTION ISSUE	07.11.14	RCO
F	AS BUILT	06.05.15	RCO

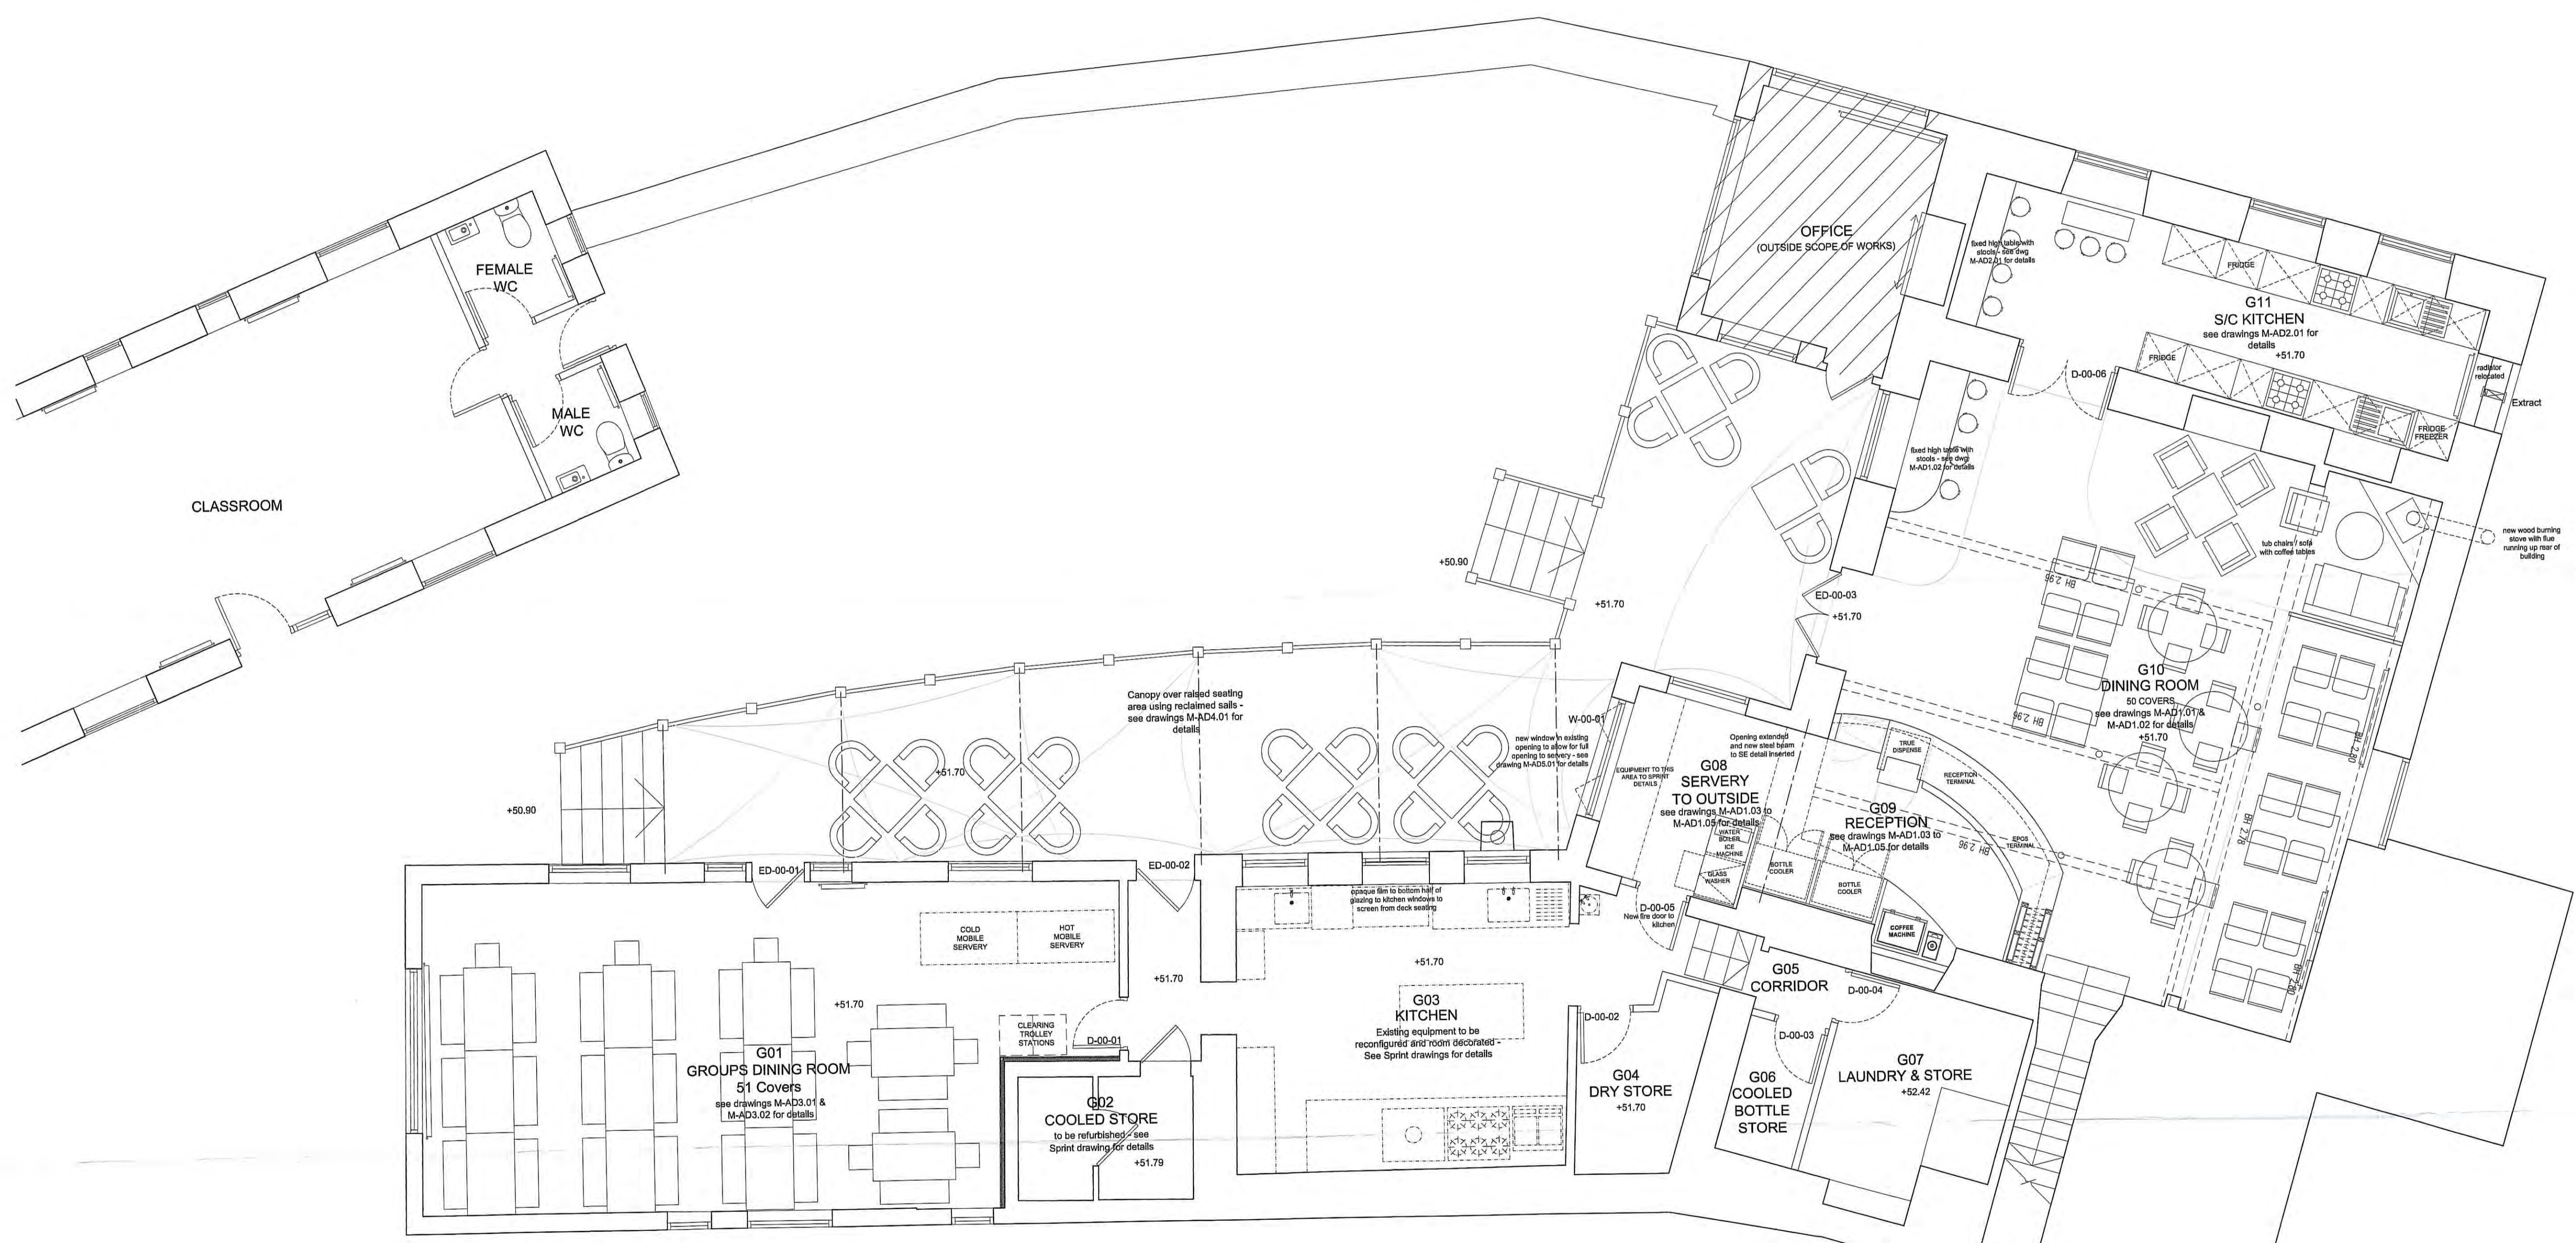


Proposed Ground Floor

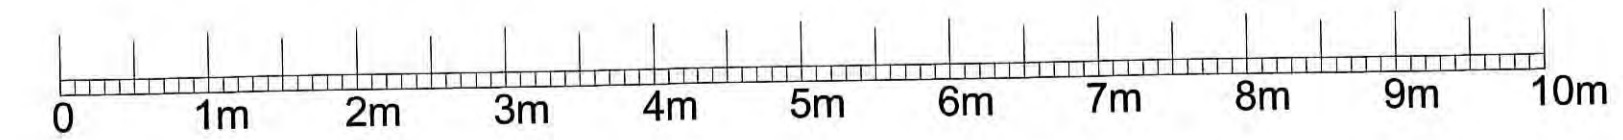

16 NOV 2015

AS BUILT


YHA (ENGLAND & WALES) LTD	client	 JUST ARCHITECTS
YHA BOGGLE HOLE, MILL BECK FYLINGTHORPE, WHITBY	project	
PROPOSED LOWER GROUND FLOOR PLAN	title	
YHA46	job No.	
M-AL1.01 - Rev F	dwg No.	7 Jordan Street Manchester M14 6JW
1:50 @ A1	scale	
RCO	drawn	

Do not scale off this drawing. All dimensions to be checked on site prior to manufacture and construction. This drawing is the property of Just-H Architects and should not be reproduced without permission. All discrepancies to be brought to the attention of the architect immediately. This drawing to be read in conjunction with the specification / bill of quantities and related drawings.

REVISION			
-	FIRST ISSUE	03.09.14	RCO
A	TENDER ISSUE	05.09.14	RCO
B	CONSTRUCTION ISSUE	07.11.14	RCO
C	AS BUILT	06.05.15	RCO



Elevation A

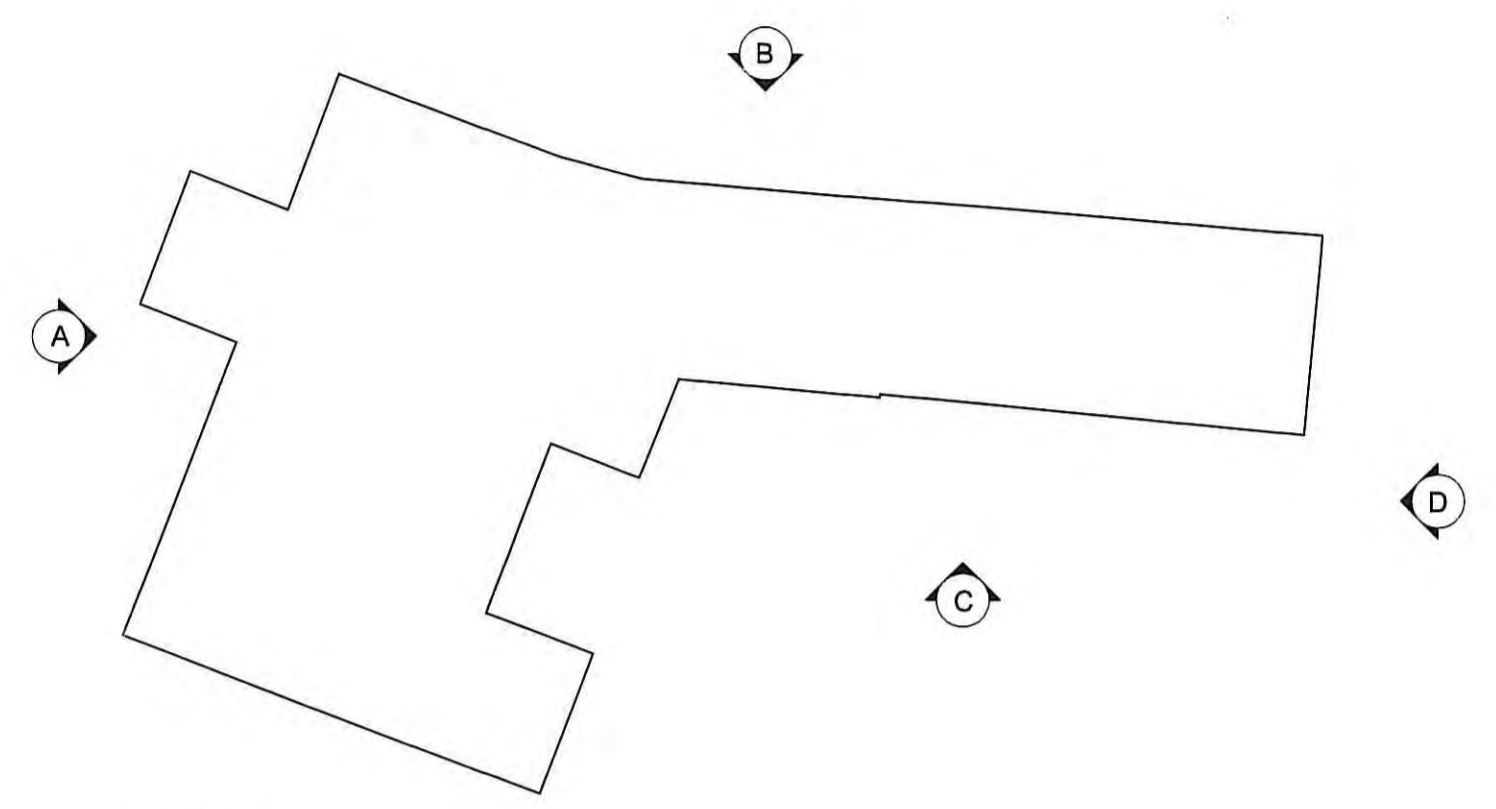

KEY PLAN



Elevation B

16 NOV 2015

AS BUILT


YHA (ENGLAND & WALES) LTD	client	
YHA BOGGLE HOLE, MILL BECK FYLINGTHORPE, NORTH YORKSHIRE	project	
PROPOSED ELEVATIONS SHEET 1	title	
YHA46	job No.	
AV1.01 - Rev C	dwg No.	
1:50 @ A1	scale	
RCO	drawn	7 Jordan Street Manchester M15 4PP

Do not scale off this drawing. All dimensions to be checked on site prior to manufacture and construction. This drawing is the property of Just-H Architects and should not be reproduced without permission. All discrepancies to be brought to the attention of the architect immediately. This drawing to be read in conjunction with the specification / bill of quantities and related drawings.

REVISION			
-	FIRST ISSUE	03.09.14	RCO
A	TENDER ISSUE	05.09.14	RCO
B	CONSTRUCTION ISSUE	07.11.14	RCO
C	AS BUILT	06.05.15	RCO



Elevation C

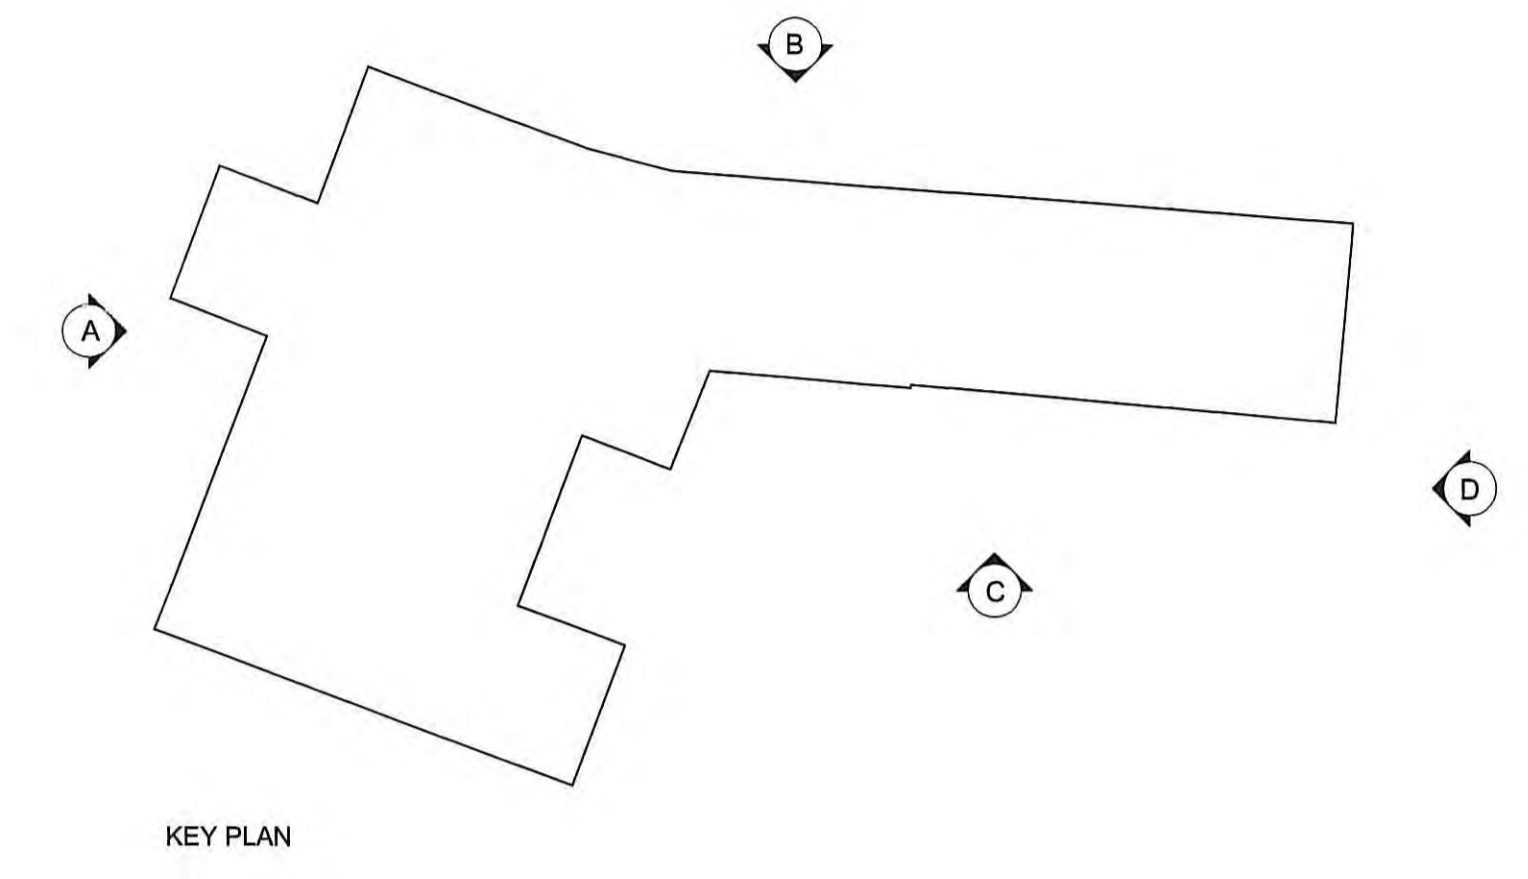

KEY PLAN




Elevation D



AV1.02
16 NOV 2016

AS BUILT

YHA (ENGLAND & WALES) LTD	client	 JUST ARCHITECTS
YHA BOGGLE HOLE, MILL BECK FYLLINGTHORPE, NORTH YORKSHIRE	project	
PROPOSED ELEVATIONS SHEET 2	title	
YHA46	job No.	
AV1.02 - Rev C	dwg No.	7 Jordan Street Manchester M11 2JW
1:50 @ A1	scale	
RCO	drawn	

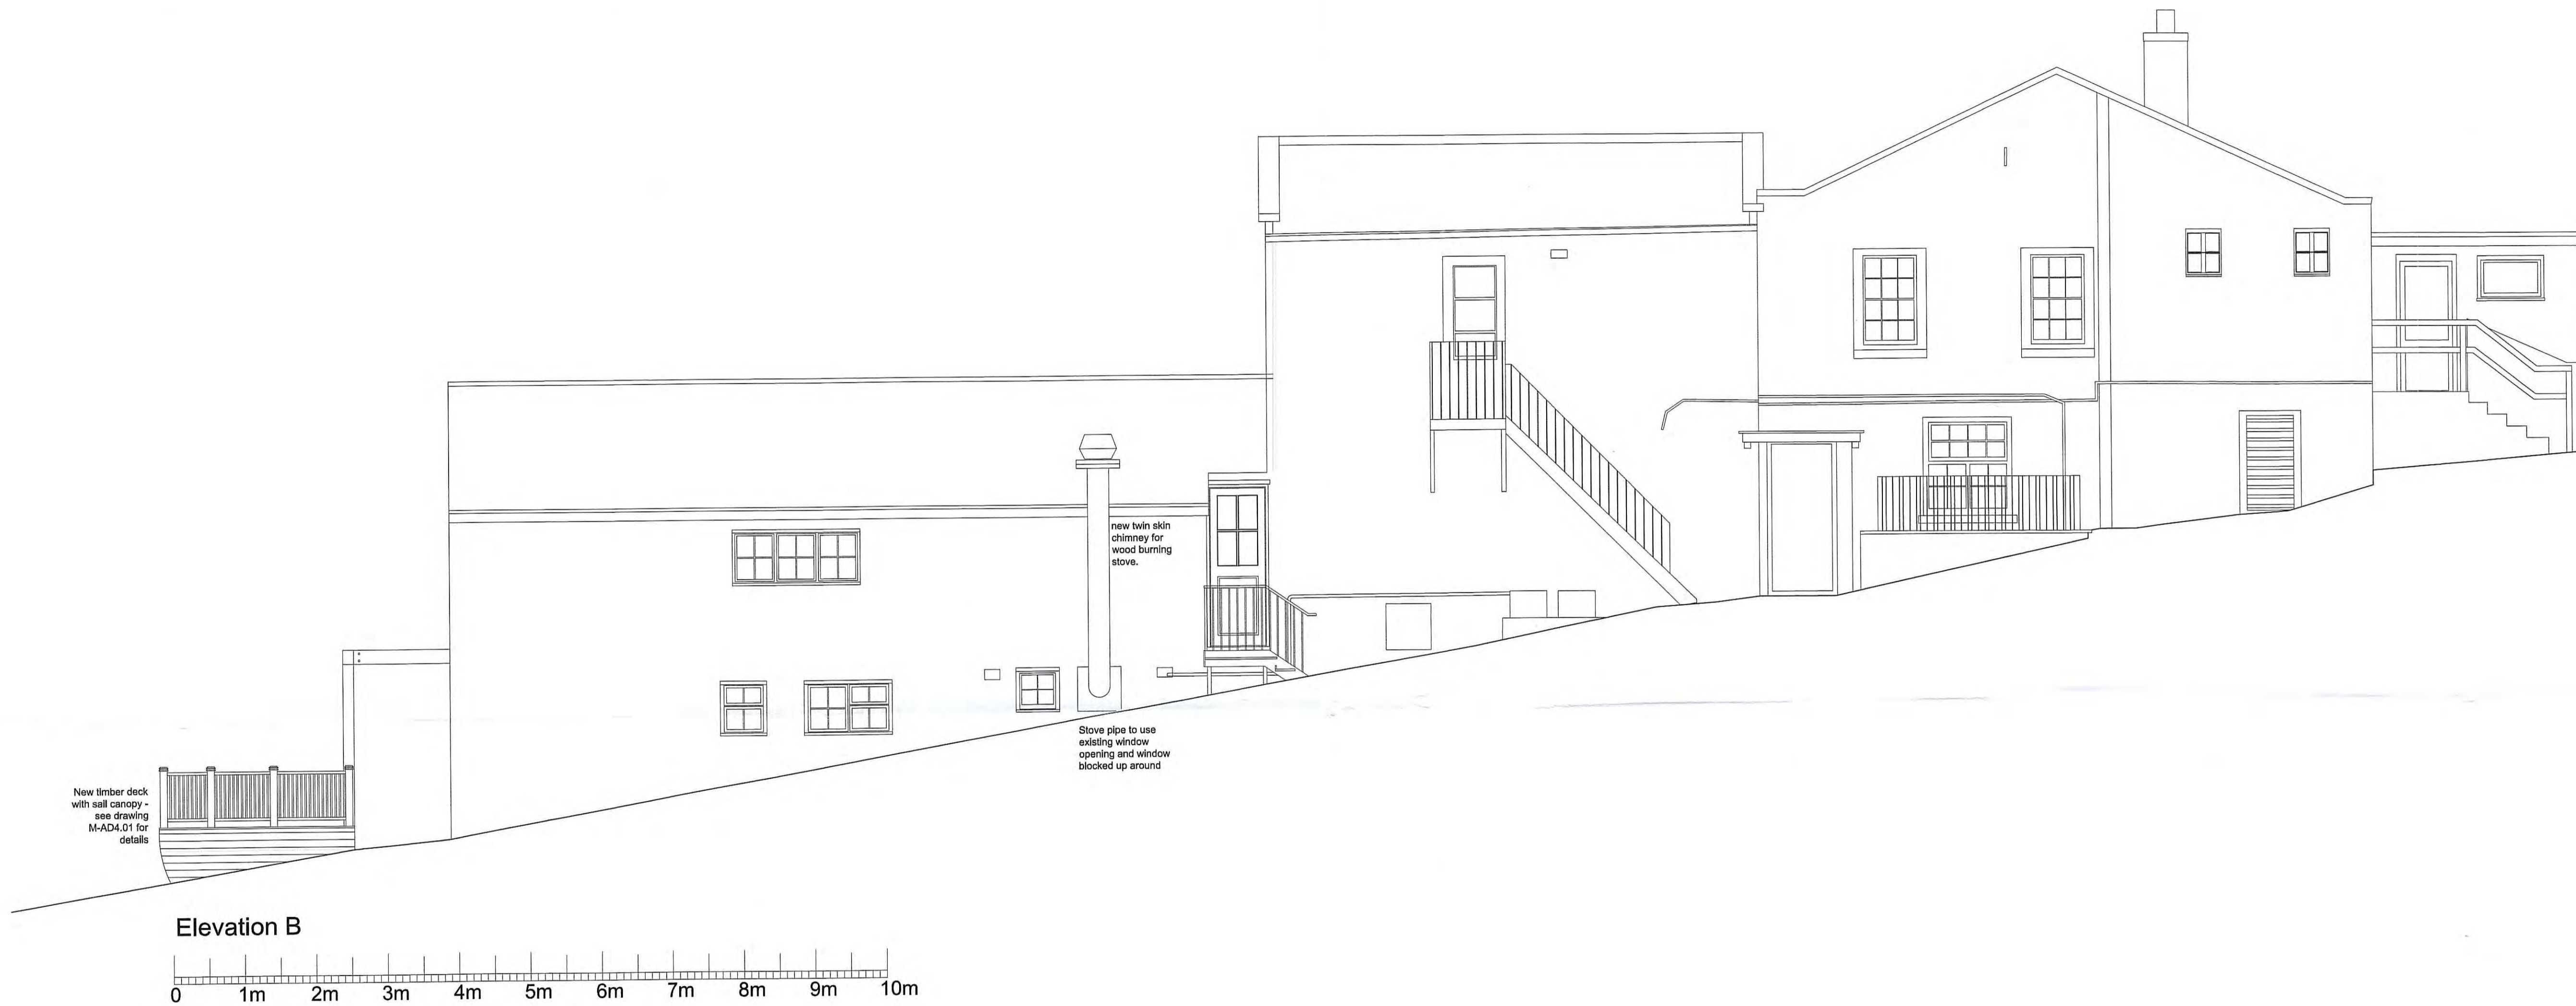


Elevation B

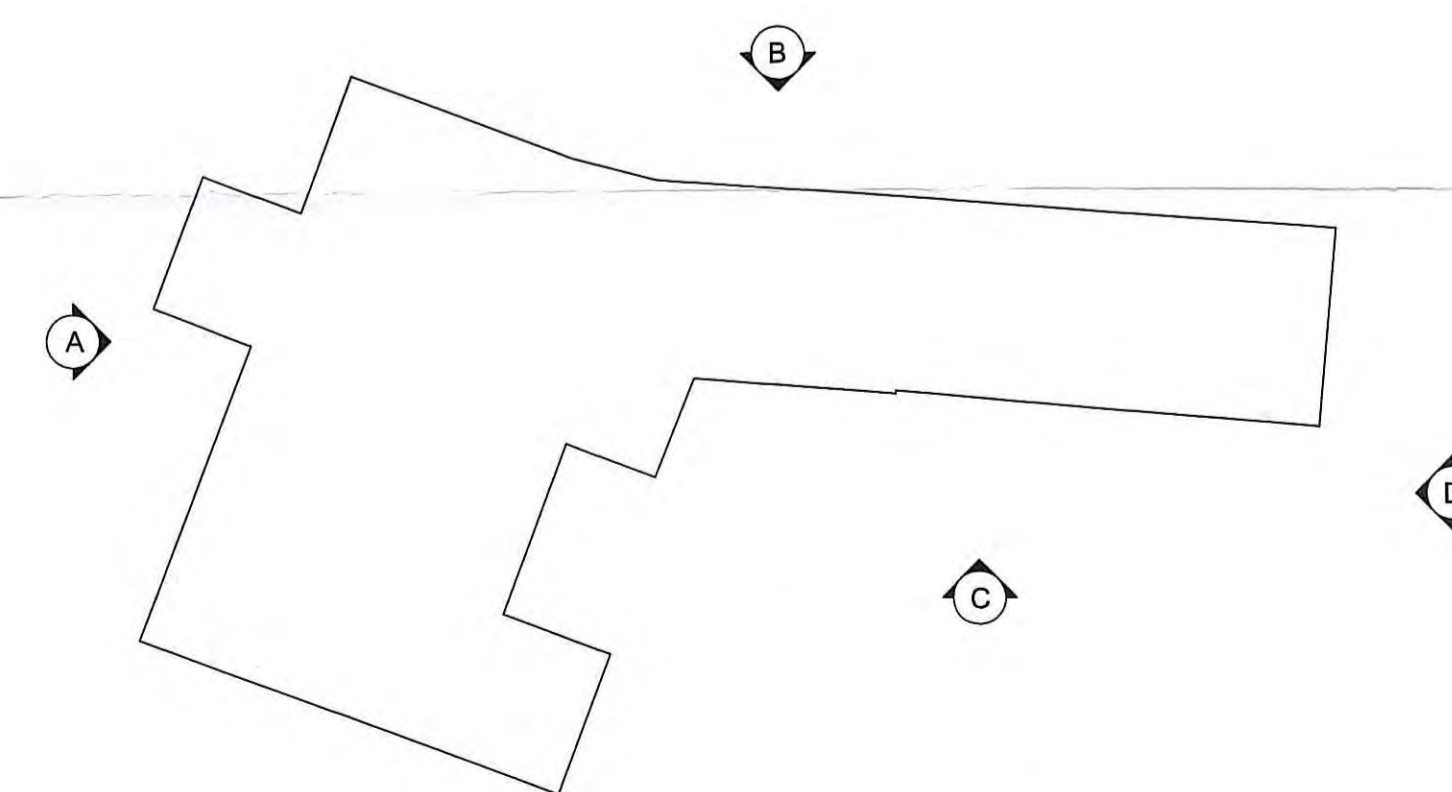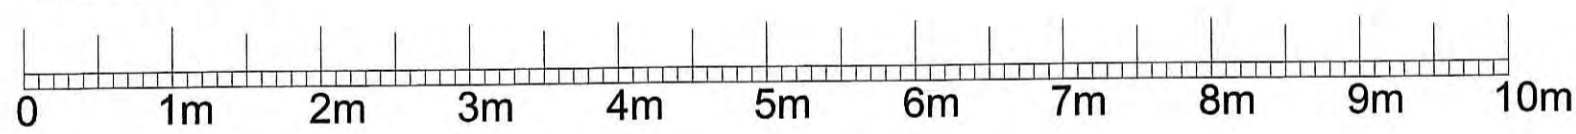

KEY PLAN


16 JULY 2016

YHA (ENGLAND & WALES) LTD	client	
YHA BOGGLE HOLE, MILL BECK FYLINGTHORPE, NORTH YORKSHIRE	project	
PROPOSED ELEVATIONS PHASE 2 WORKS	title	7 Jordan Street Manchester M1 5 2PY
YHA46	job No.	
AV201	dwg No.	
1:50 @ A1	scale	
RCO	drawn	

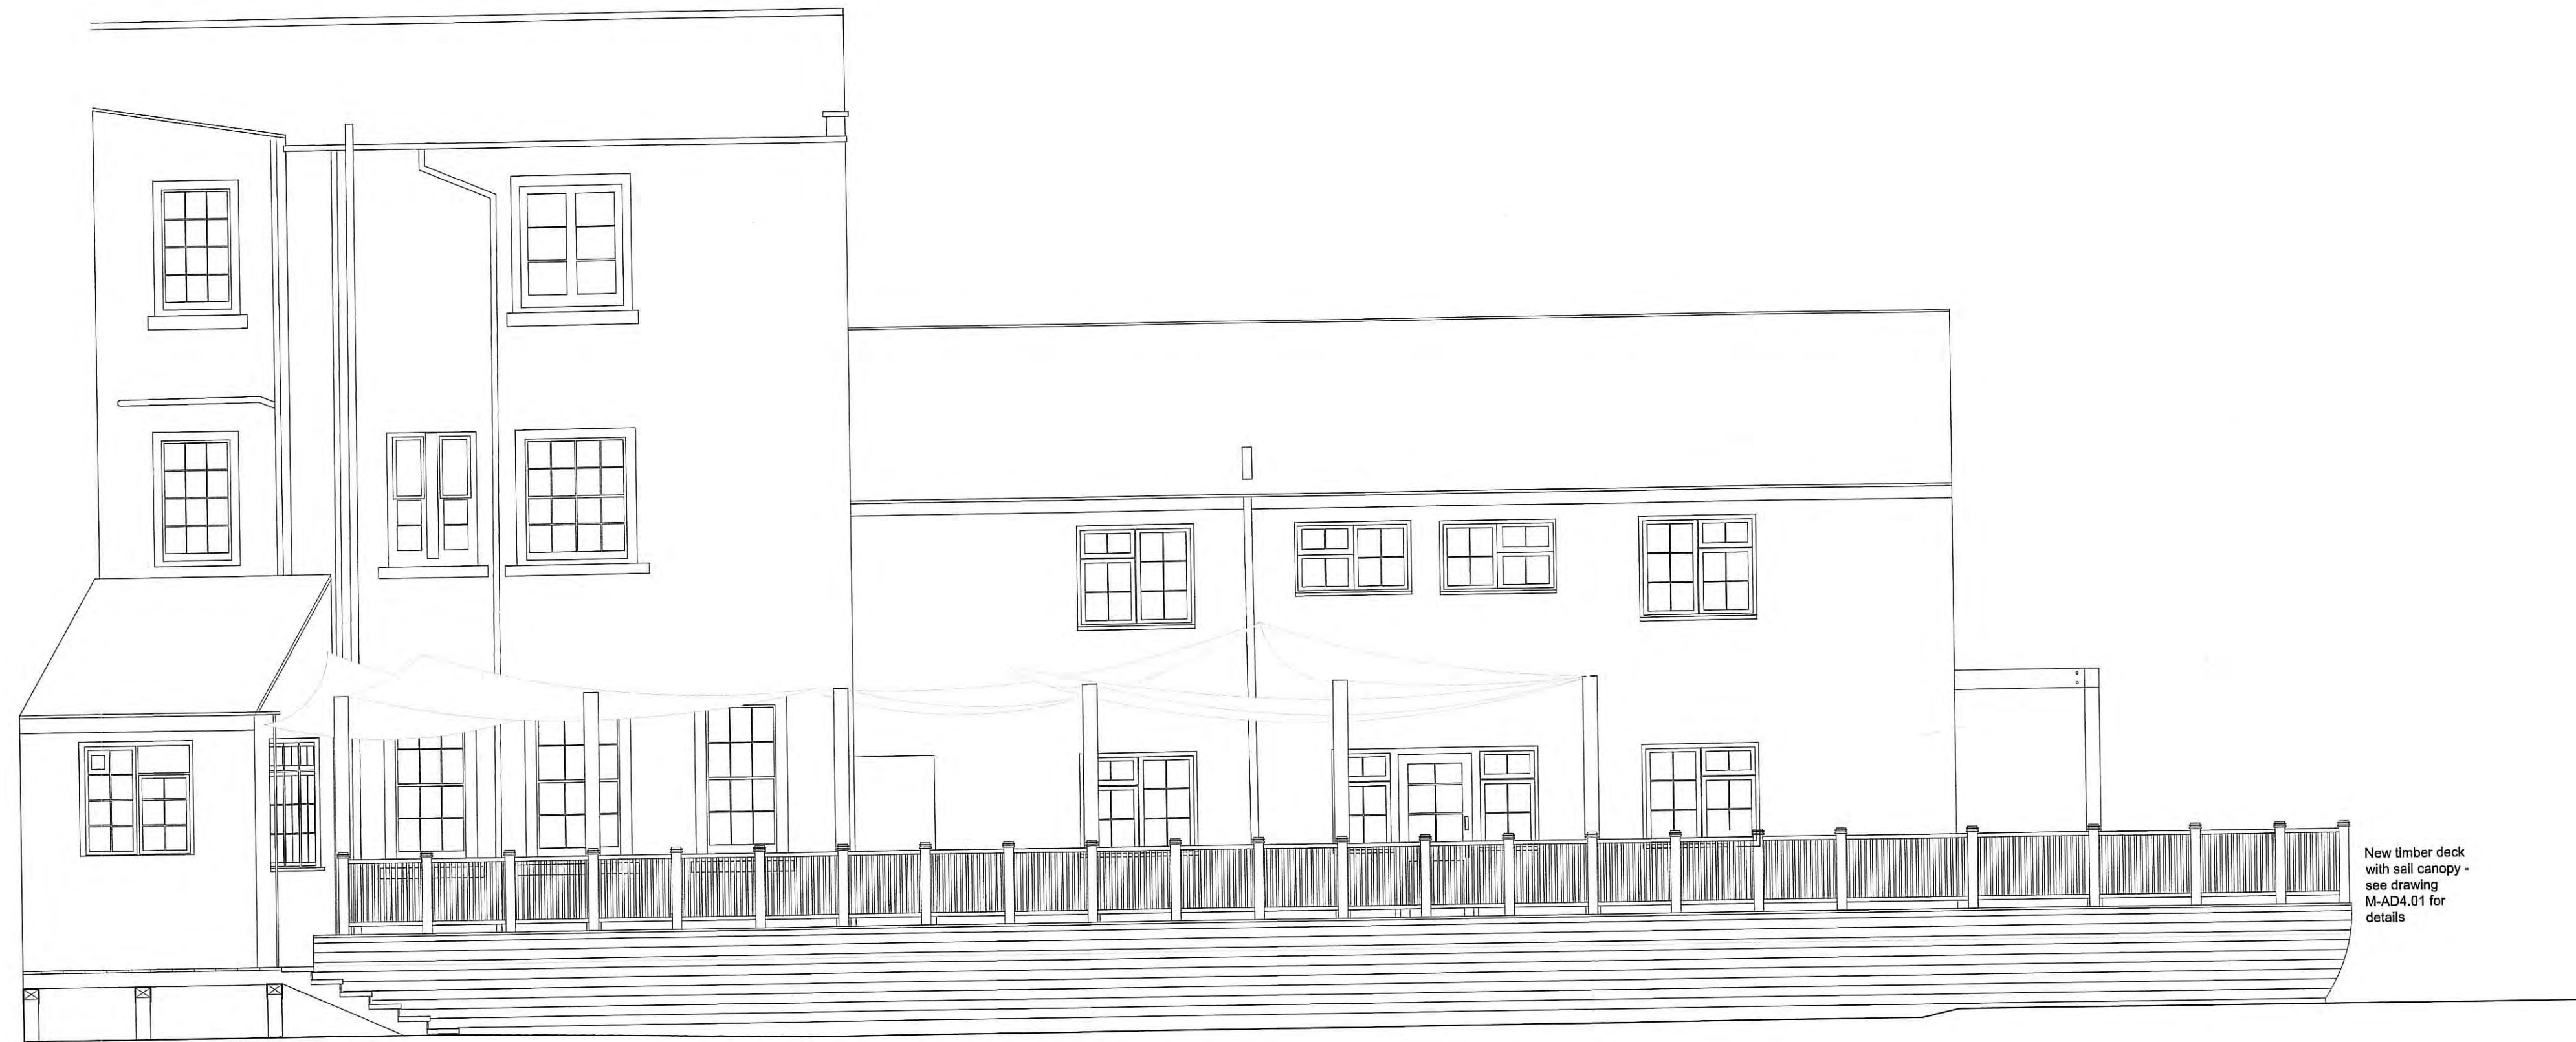

New timber deck with sail canopy - see drawing M-AD4.01 for details

Elevation C

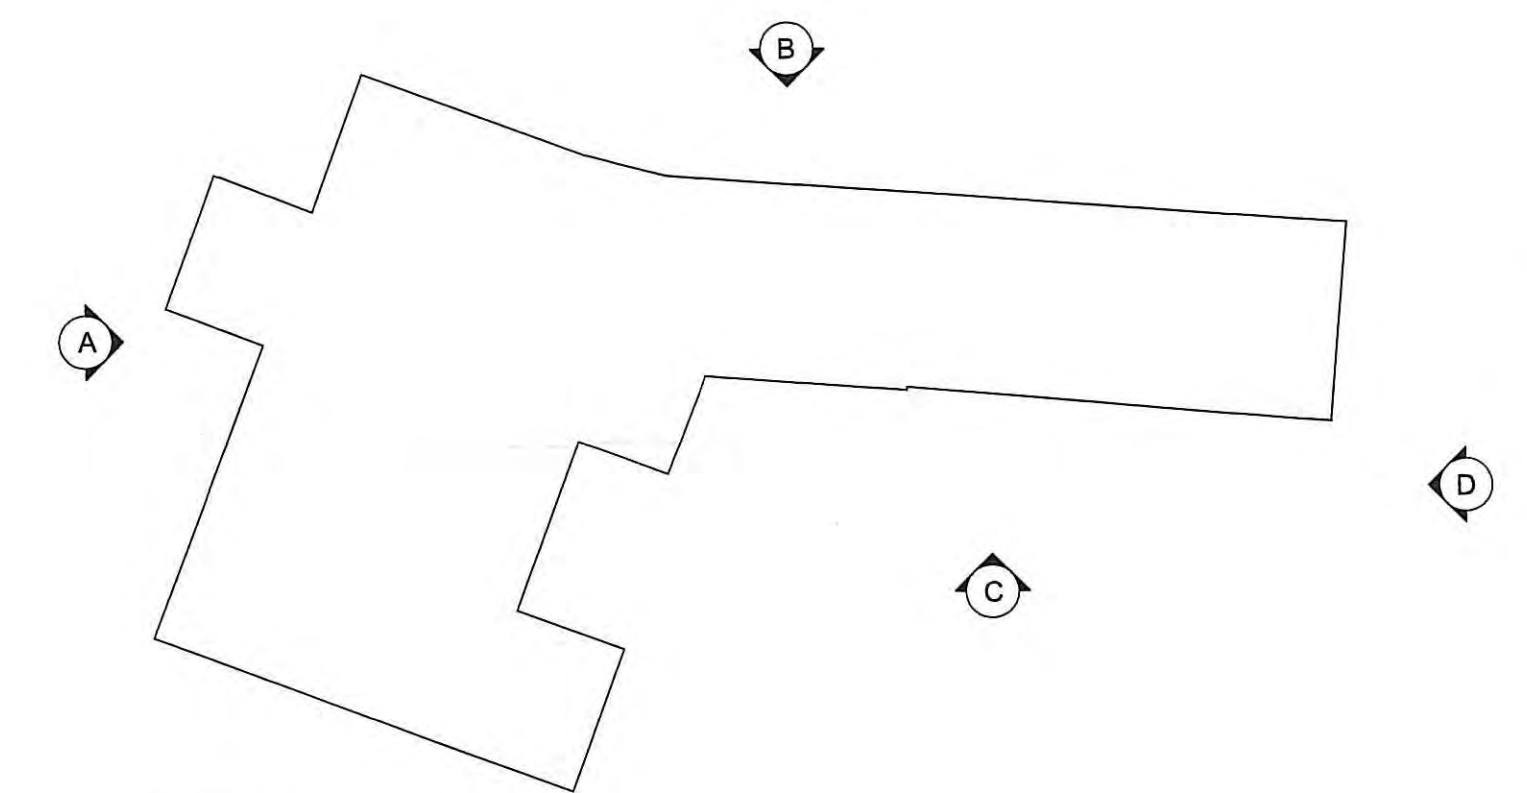

KEY PLAN



New timber double glazed window to match existing.

Window opening extended to ground level and new folding sliding doors inserted.

Timber deck extended around front of building - see drawing M-AD4.01 for details

Elevation D

16 NOV 2016

YHA (ENGLAND & WALES) LTD	client
YHA BOGGLE HOLE, MILL BECK FYLLINGTHORPE, NORTH YORKSHIRE	project
PROPOSED ELEVATIONS PHASE 2 WORKS - SHEET 2	title
YHA46	job No.
AV202	dwg No.
1:50 @ A1	scale
RCO	drawn



7 Jordan Street
Manchester
M4 1 5 APY