

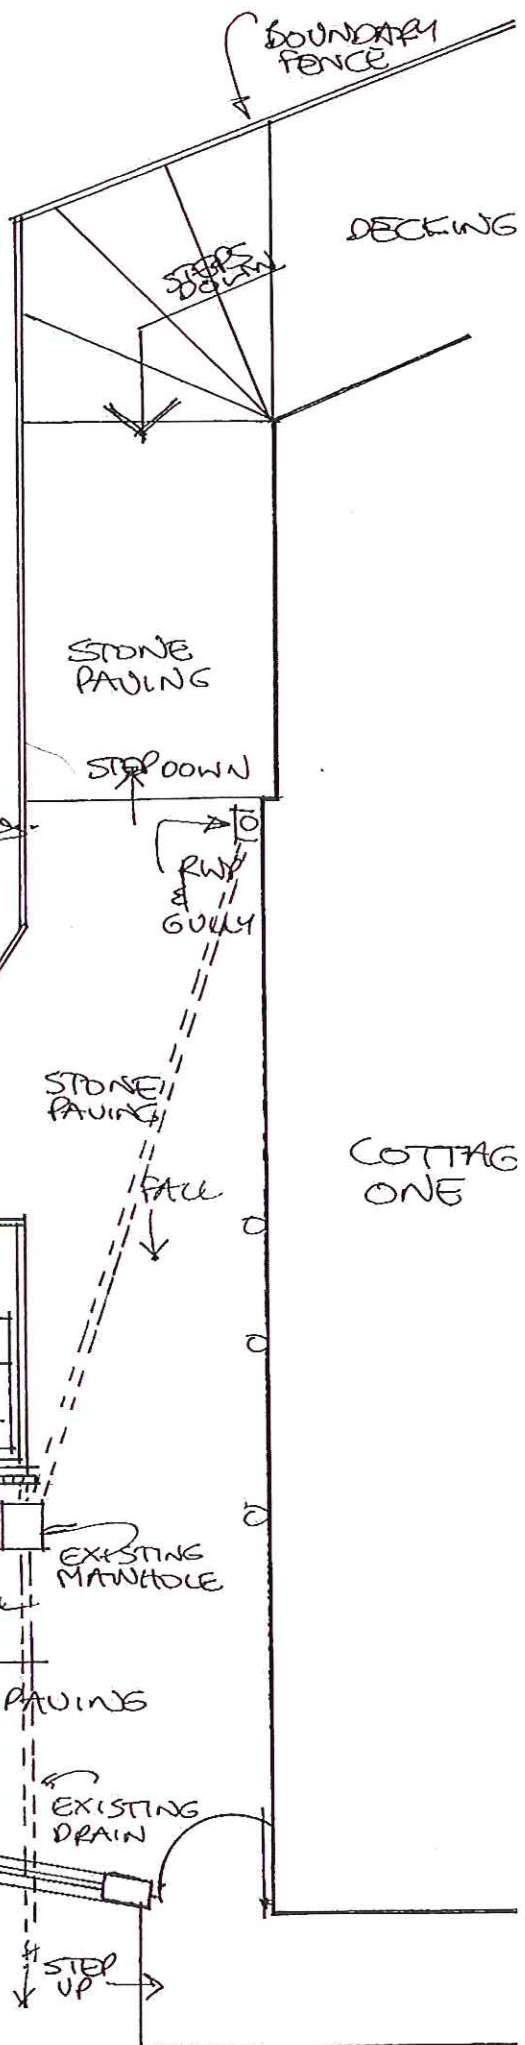


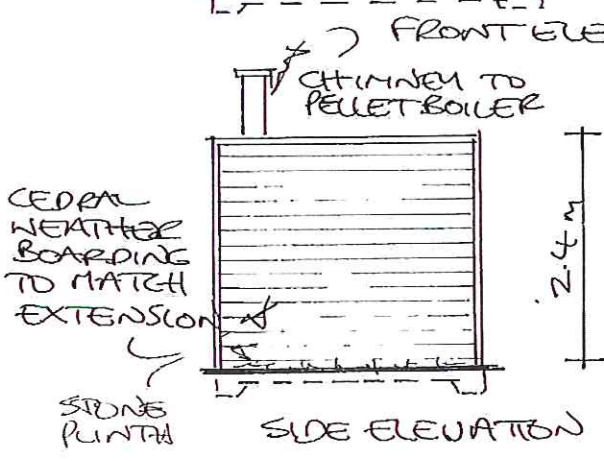

Scale 1:100


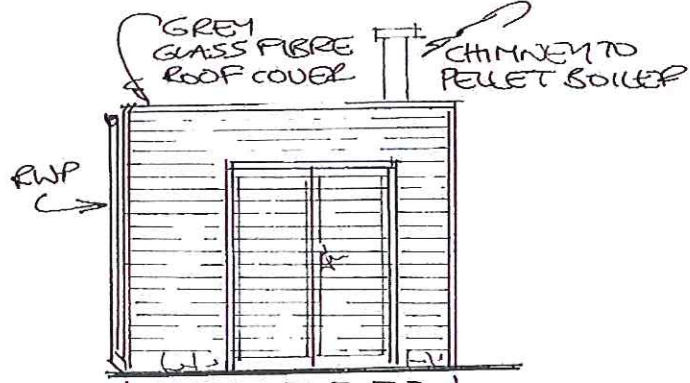


PROPOSED EXTERNAL WORKS & BOILER ROOM

COTTAGE ONE  
DUNSLEY HALL  
SCALE 1:75  
AS BUILT JAN 17

ADJACENT PROPERTY

NYMNPA  
27 FEB 2017

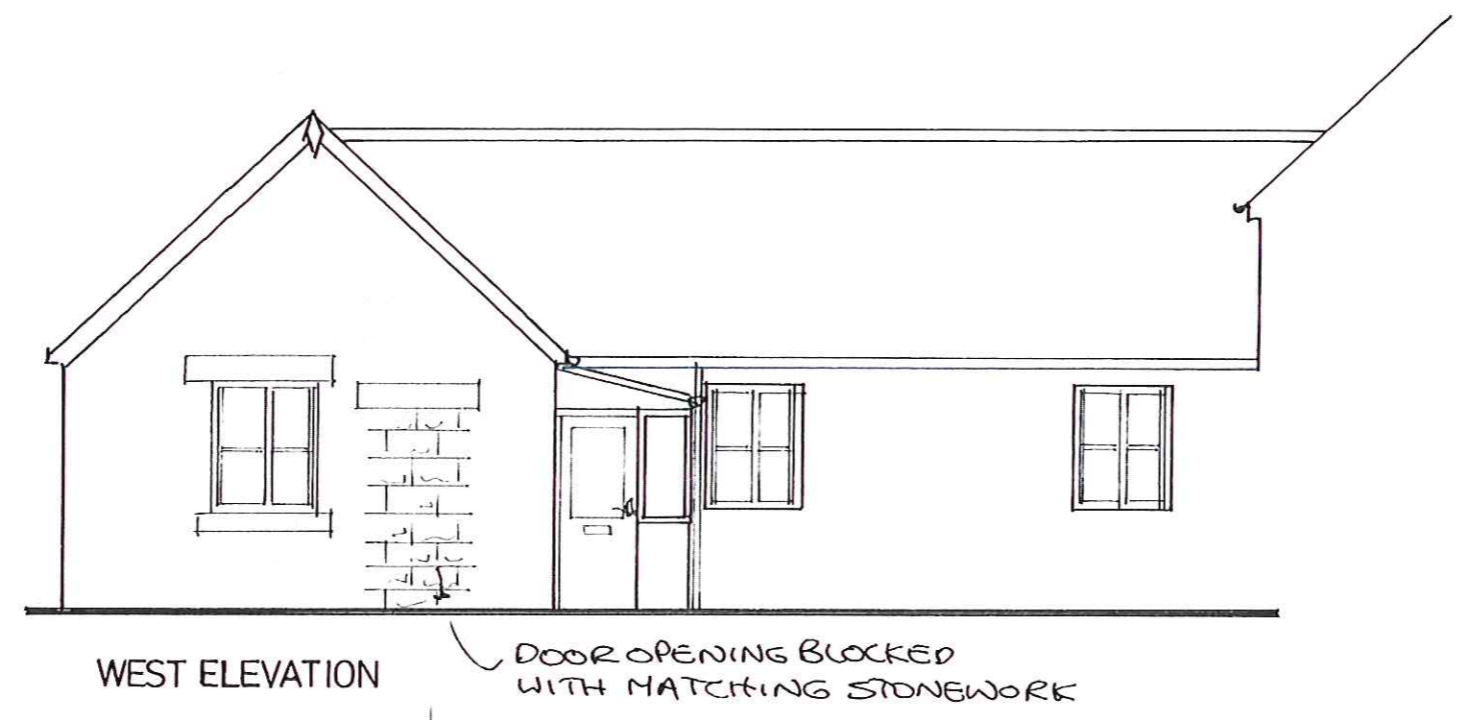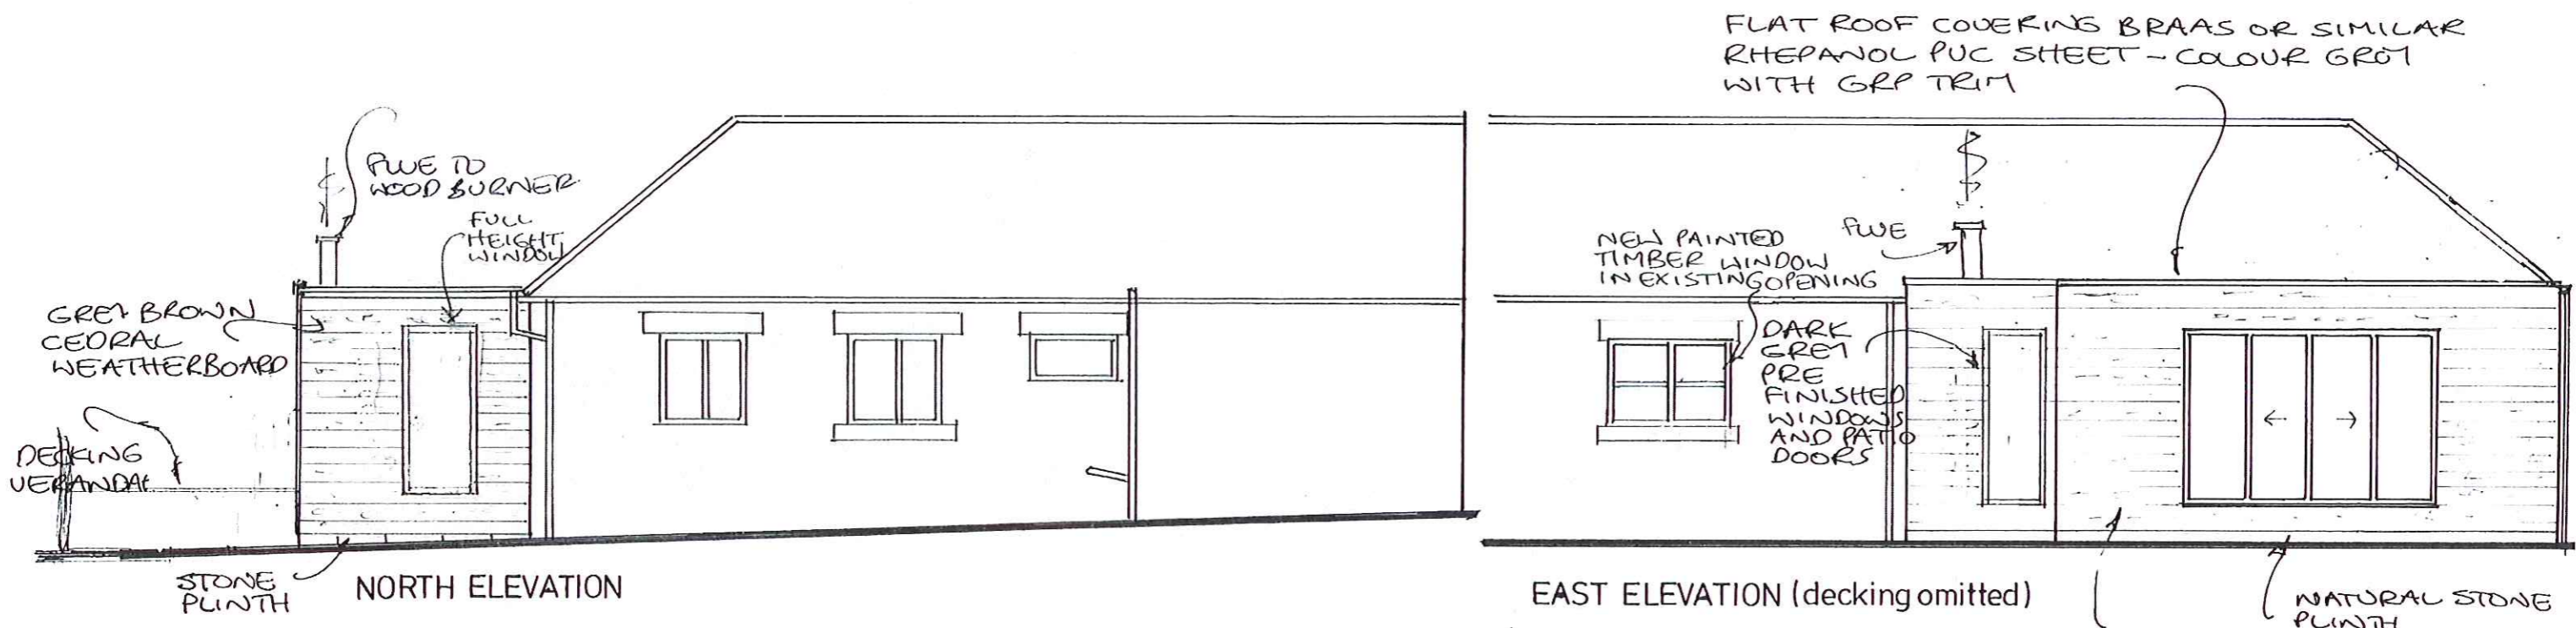

NYM/NPA  
- 6 JAN 2017

**PROPOSED ALTERATIONS AND EXTENSIONS AT COTTAGE ONE,  
DUNSLEY HALL, WHITBY**  
For Mr and Mrs I DRINKWATER

**ELEVATIONS AS PROPOSED**      **Scale 1:75**

Rev A 24.11.14 Extension window (north) changed to full height panel.  
Rev B 2.4.15 Juliet balcony omitted. Timber window replaced rooflight omitted

