



Do not scale from this drawing, only figured dimensions are to be taken from this drawing.
 The contractor must verify all dimensions on site before commencing any work or shop drawings.
 The contractor must report any discrepancies before commencing work. If this drawing exceeds the quantities taken in any way, the technician is to be informed before work is initiated.
 Work within the construction (design and management) regulations 2015 is not to start until a health & safety plan has been produced. This drawing is copyright and must not be reproduced without consent of BHD Partnership Ltd.

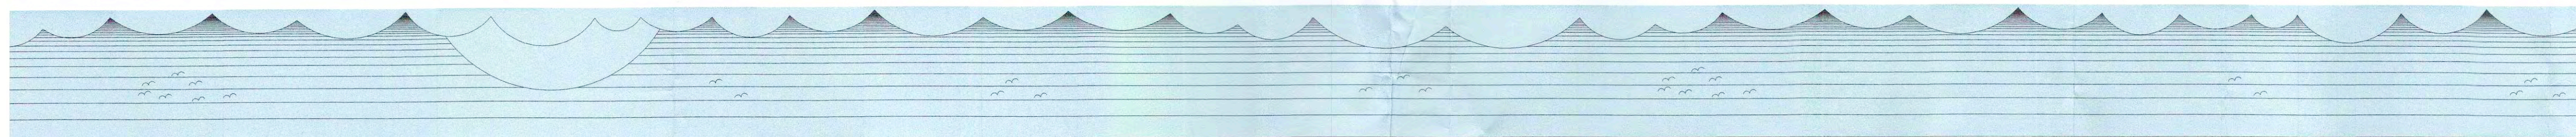


Side Elevation

Scale 1:100 @ A1

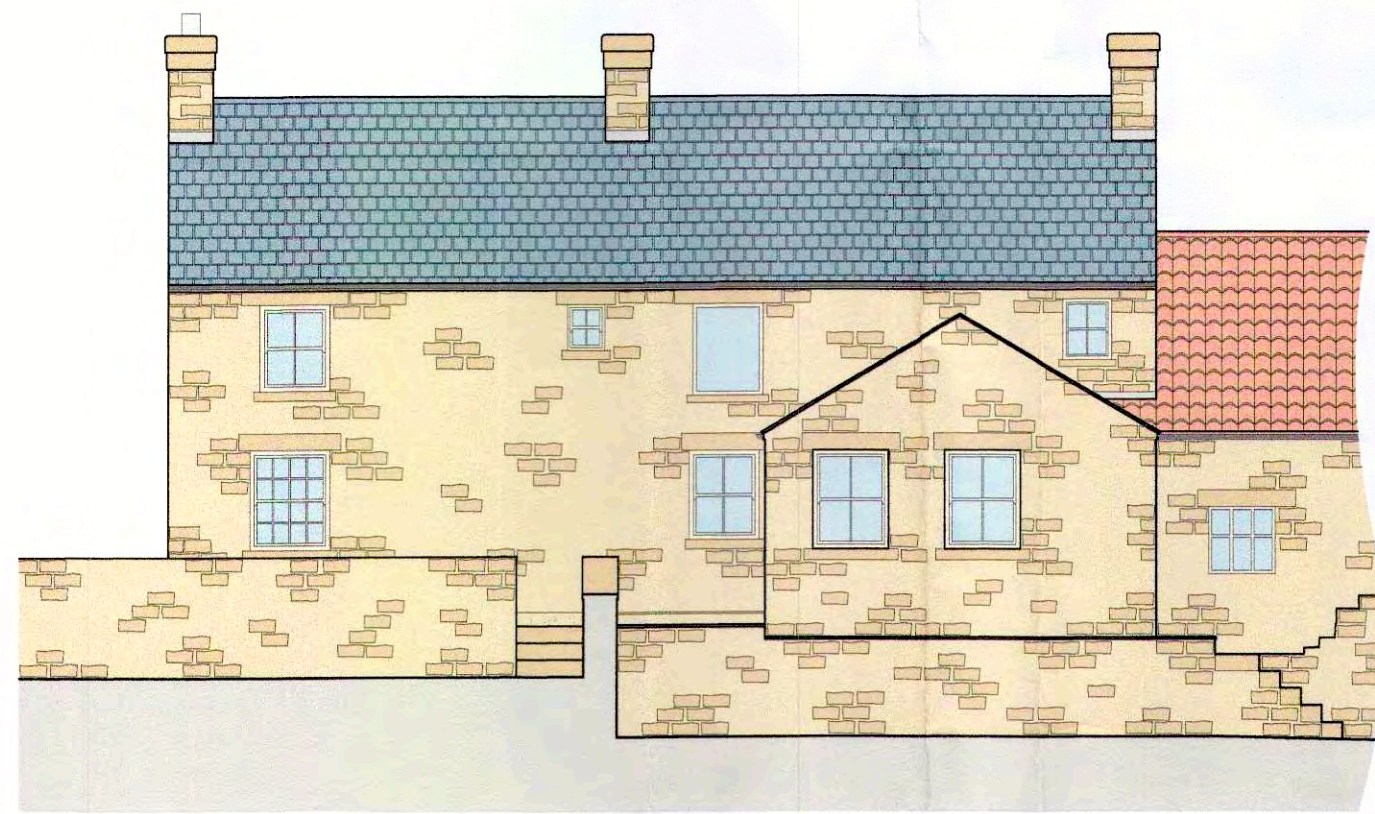


Rear Elevation

Scale 1:100 @ A1

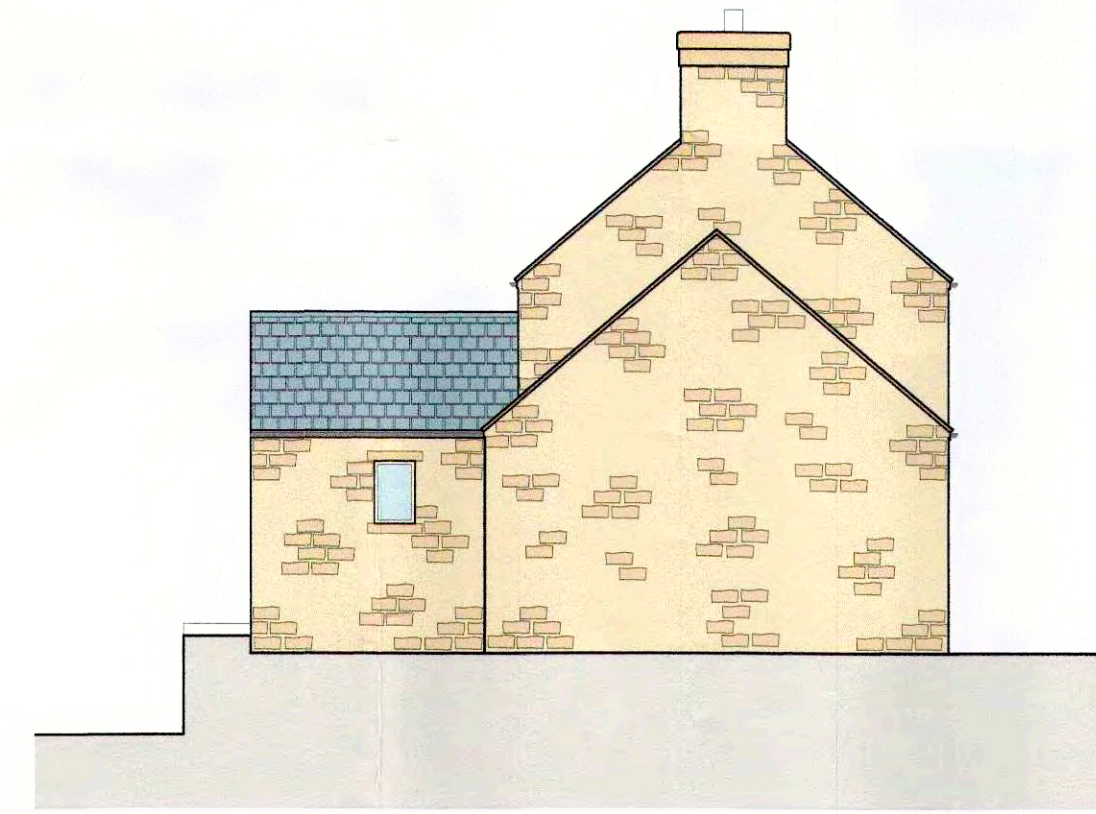

Side Elevation

Scale 1:100 @ A1

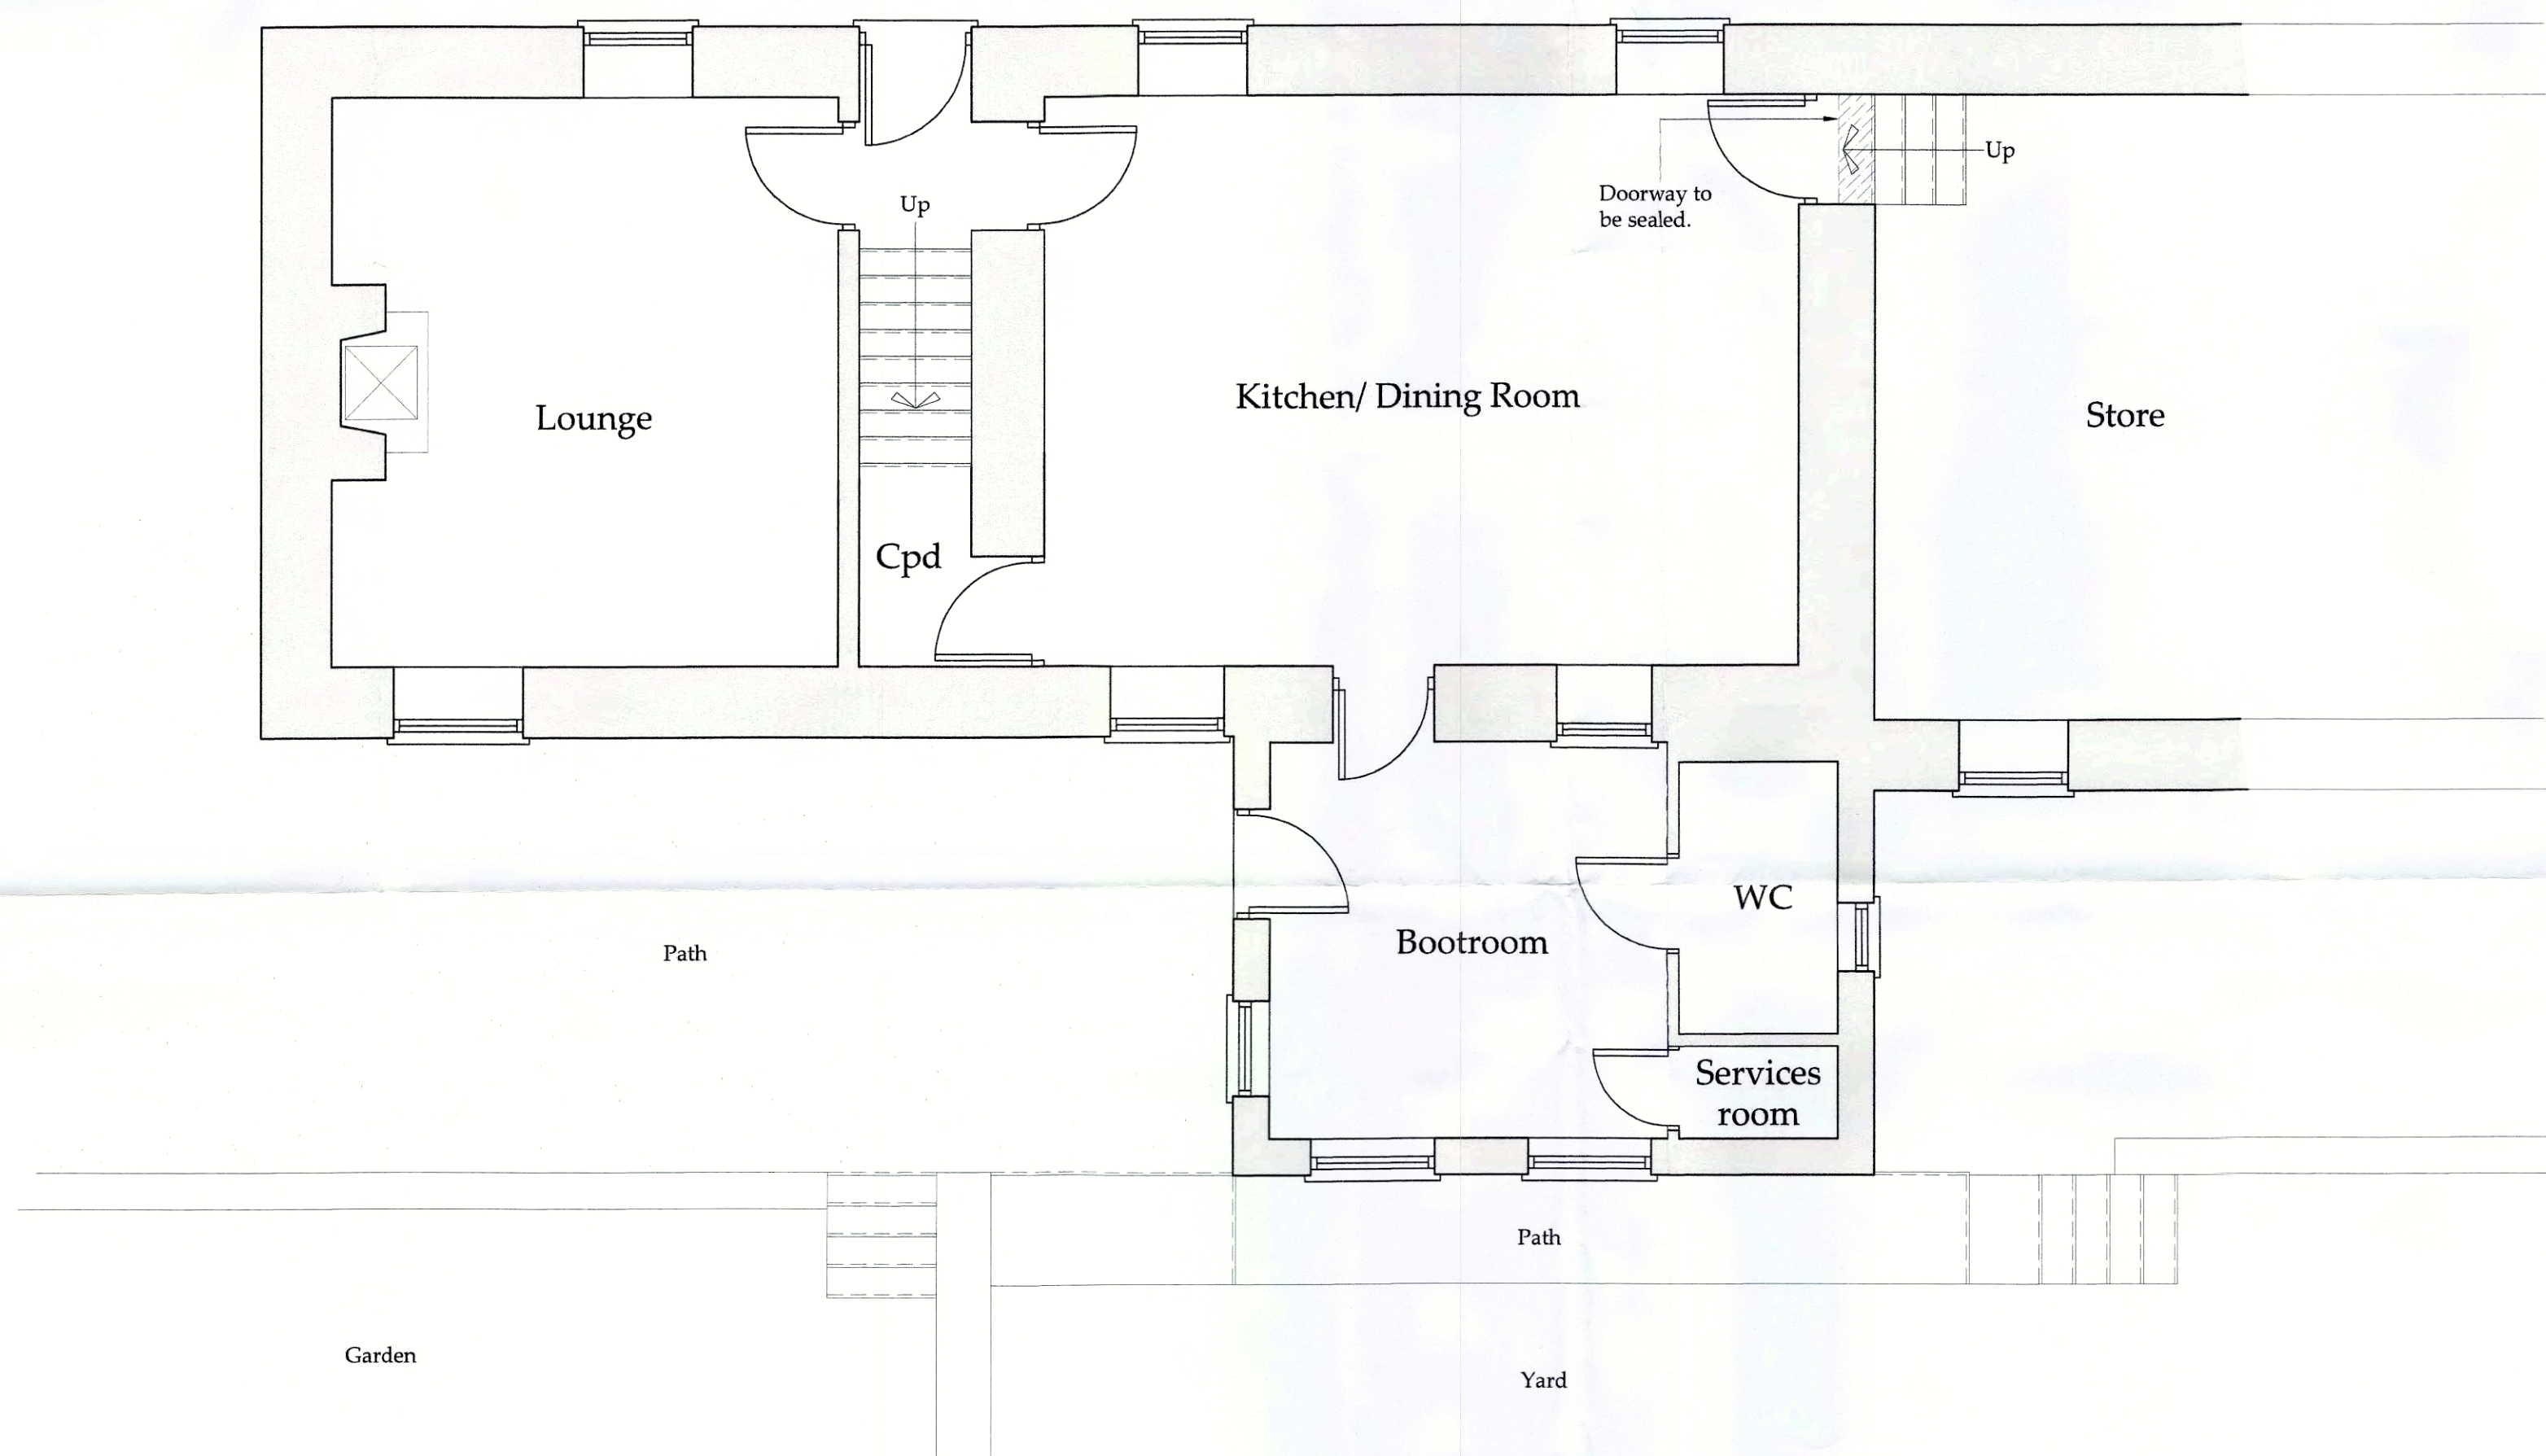

Ground Floor Plan

Scale 1:50 @ A1

REV	DATE	BY	AMENDMENT
B	25.04.17	CW	Amended to suit client
A	30.03.17	CW	Issued for approval

NYMNPA
11 MAY 2017

bhd
partnership
Architecture + Engineering

Alry Hill Manor, Waterstead Lane,
Whitby, N. Yorks. YO21 1QB

CLIENT: Mr. D. Wilson
 PROJECT: School Farm, Aislaby, Whitby.

DRAWING: As built Plans and Elevations



DRAWING STATUS: Planning

DRAWN: C. Walker
 CHECKED: T. Harrison


SCALE @ SIZE: 1:50, 1:100 @ A1
 DATE: 27.03.17

DRAWING No: D11154-03
 REV: B


Do not scale from this drawing. Only figured dimensions are to be taken from this drawing.
 The contractor must verify all dimensions on site before commencing any work or shop drawings.
 The contractor must report any discrepancies before commencing work. If this drawing exceeds the quantities taken in any way, the technician is to be informed before work is initiated.
 Work within the construction (design and management) regulations 2015 is not to start until a health & safety plan has been produced. This drawing is copyright and must not be reproduced without consent of BHD Partnership Ltd.

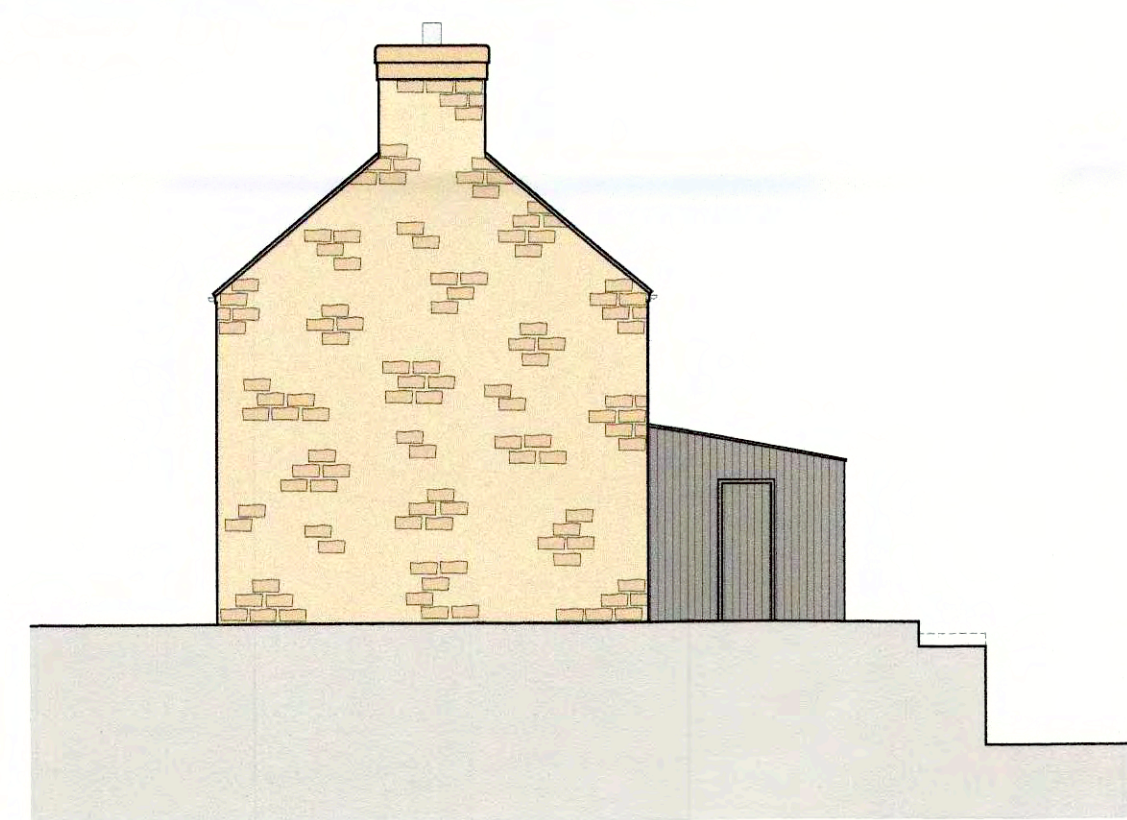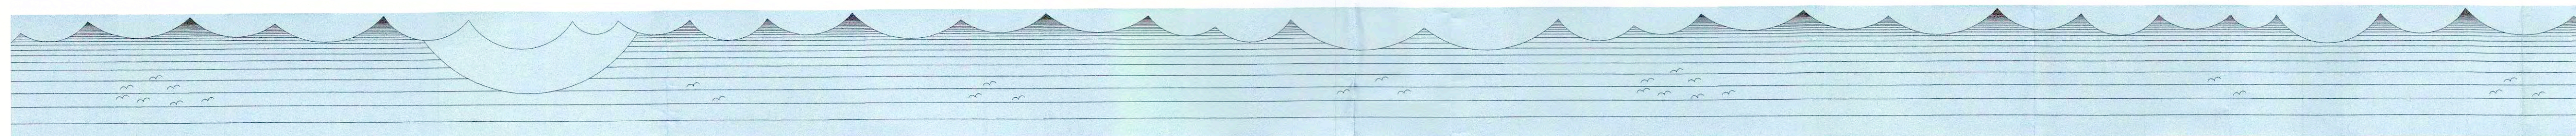


Side Elevation
 Scale 1:100 @ A1

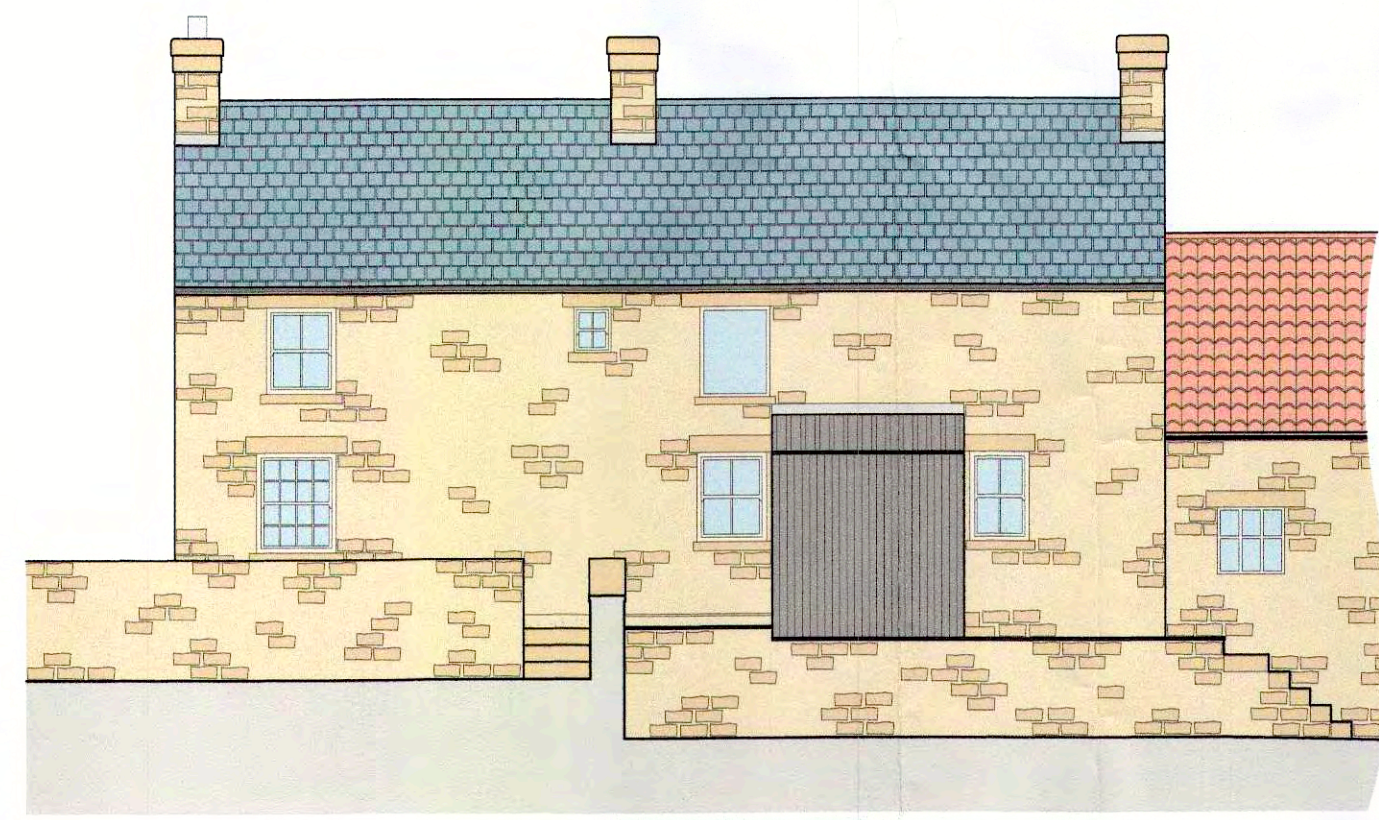

Rear Elevation
 Scale 1:100 @ A1

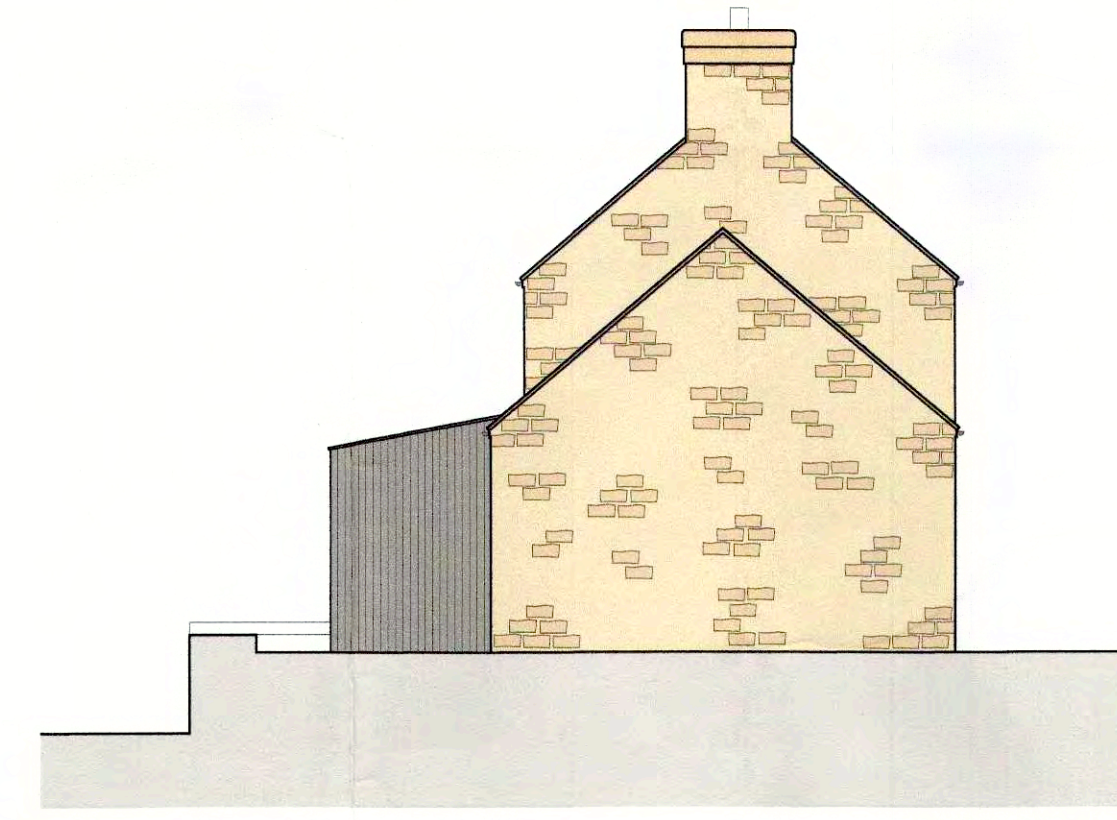

Side Elevation
 Scale 1:100 @ A1

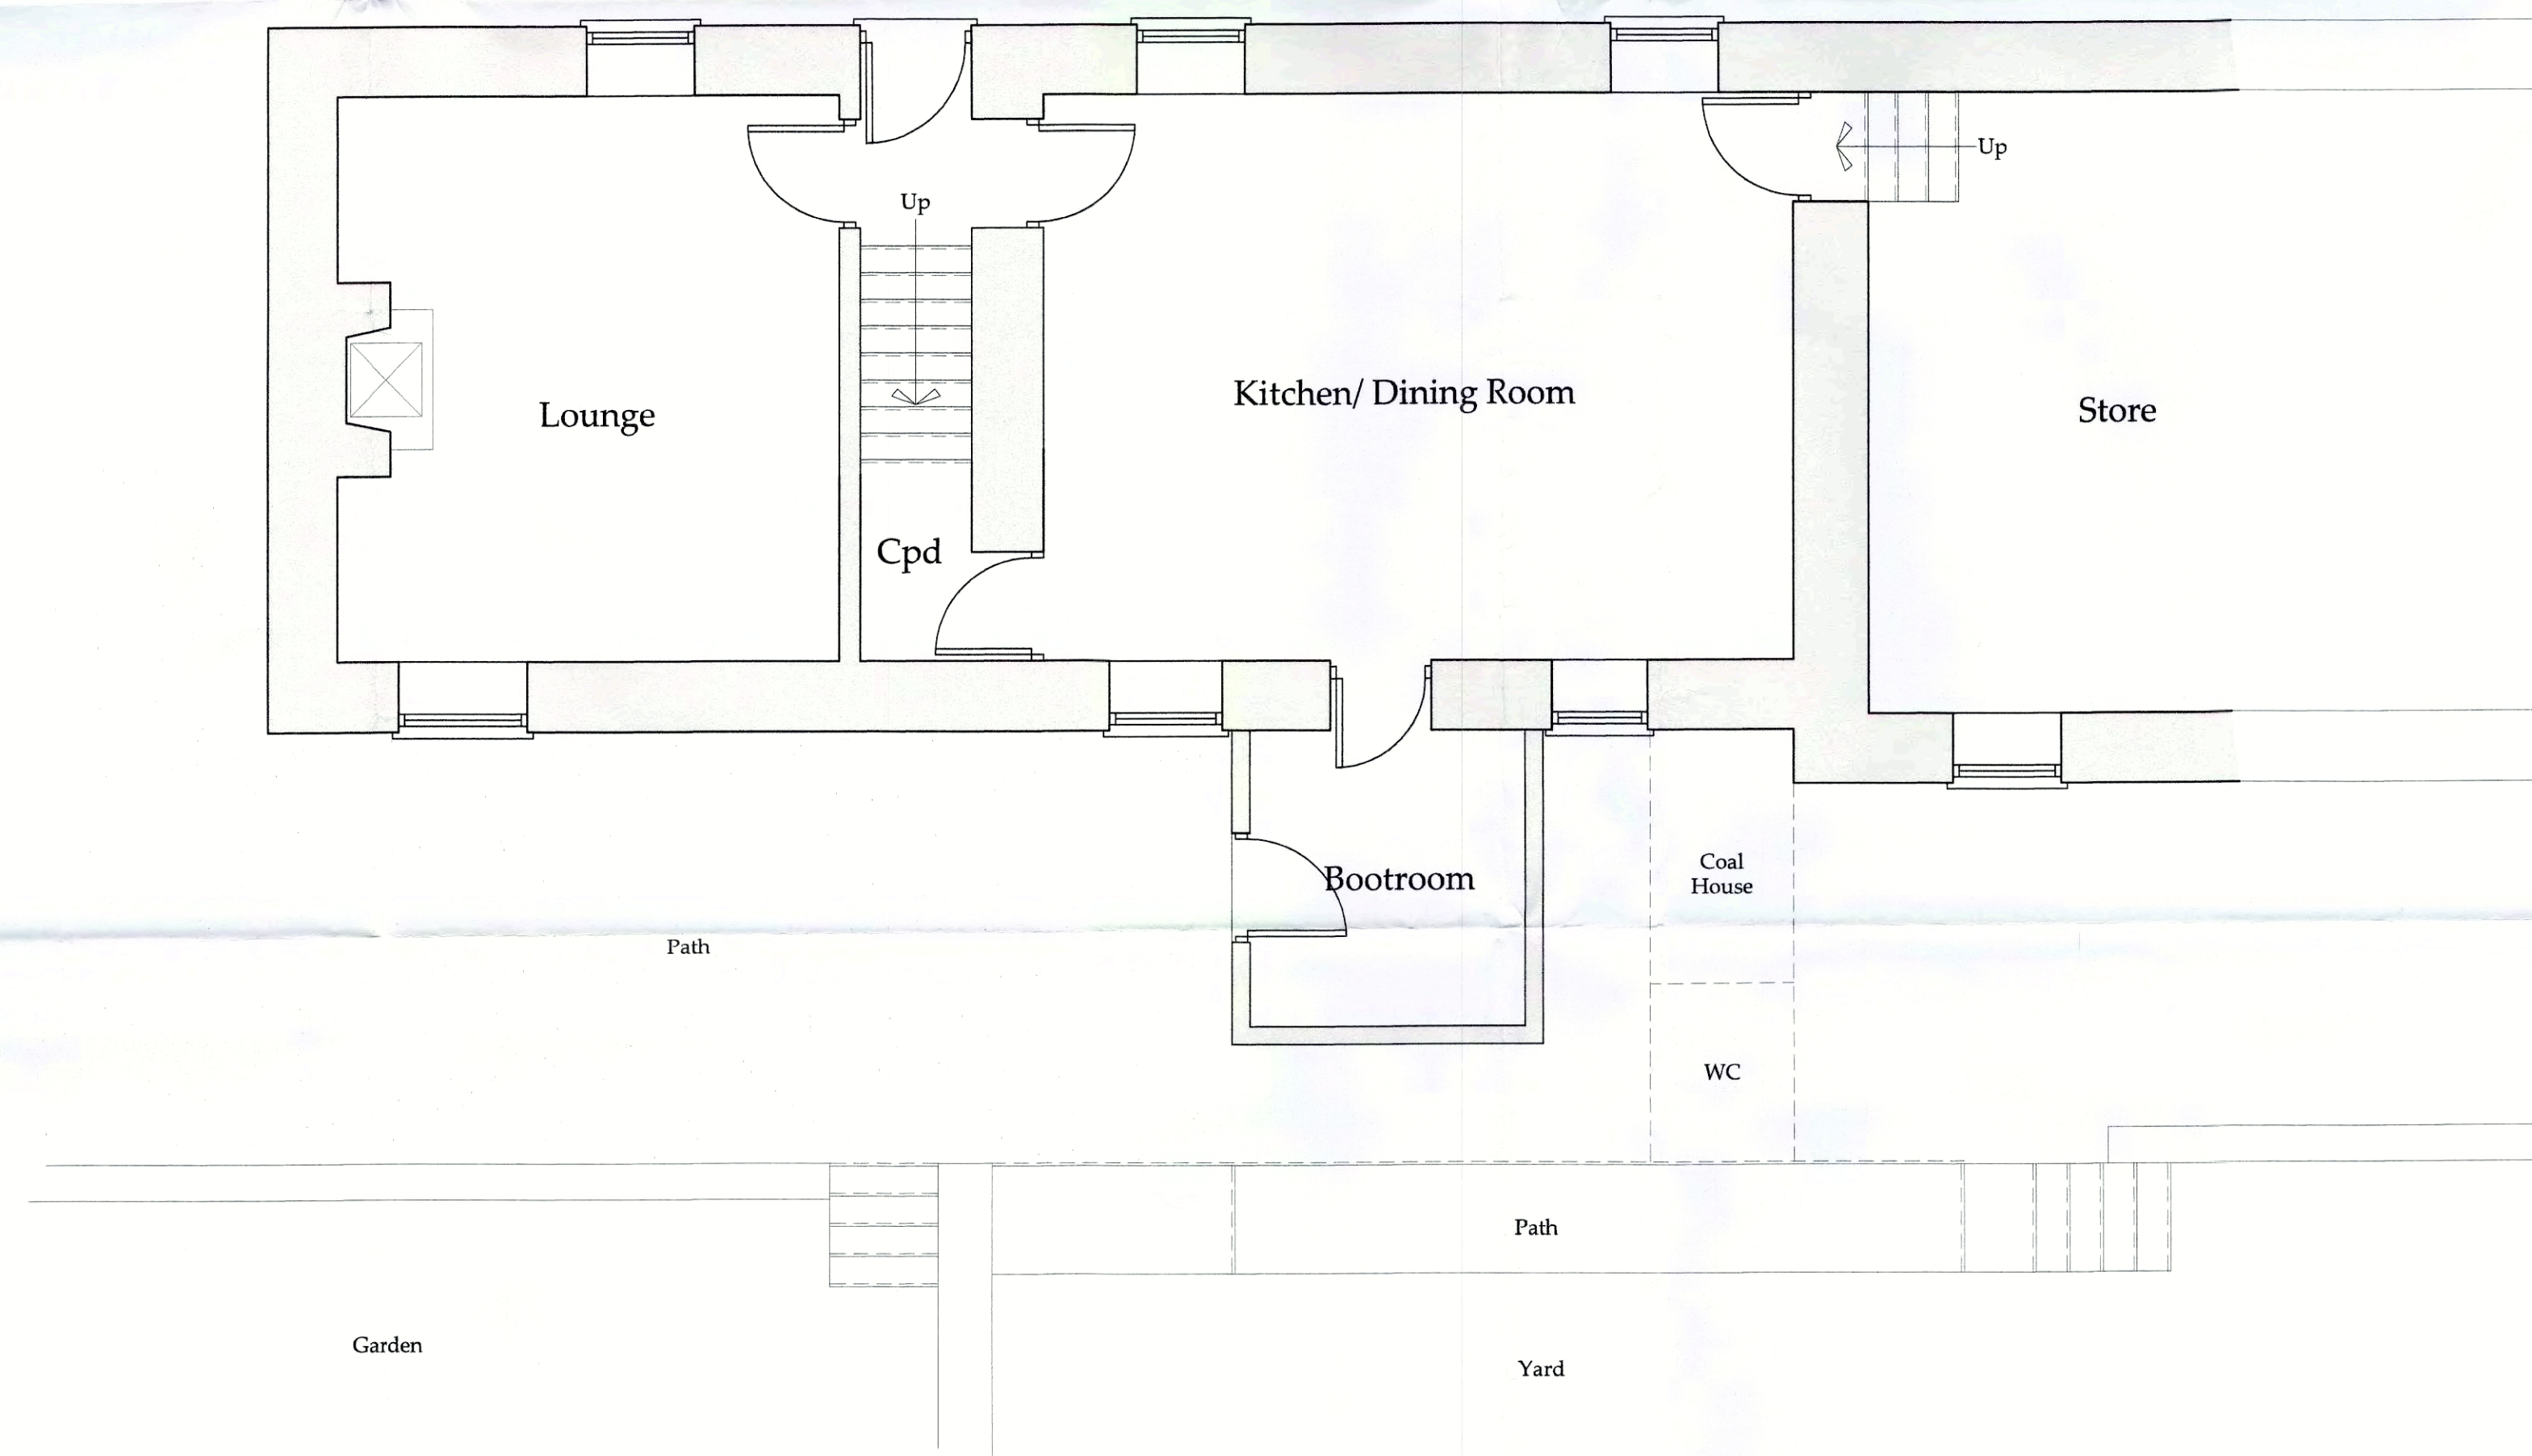

Ground Floor Plan
 Scale 1:50 @ A1

B	25.04.17	CW	Amended to suit client
A	30.03.17	CW	Issued for approval
REV	DATE	BY	AMENDMENT

NYMANIPA
 11 MAY 2017

bhd
 partnership
 Architecture + Engineering
 Airy Hill Manor, Waterstead Lane,
 Whitby, N. Yorks. YO21 1QB



CLIENT: **Mr. D. Wilson**
 PROJECT: **School Farm, Aislaby, Whitby.**

DRAWING STATUS: **Planning**
 DRAWN: **C. Walker** CHECKED: **T. Harrison**


SCALE @ SIZE: **1:50, 1:100 @ A1** DATE: **27.03.17**

DRAWING No: **D11154-02** REV: **B**

Do not scale from this drawing, only figured dimensions are to be taken from this drawing.
 The contractor must verify all dimensions on site before commencing any work or shop drawings.
 The contractor must report any discrepancies before commencing work. If this drawing exceeds the quantities taken in any way, the technician is to be informed before work is initiated.
 Work within the construction (design and management) regulations 2015 is not to start until a health & safety plan has been produced. This drawing is copyright and must not be reproduced without consent of BHD Partnership Ltd.

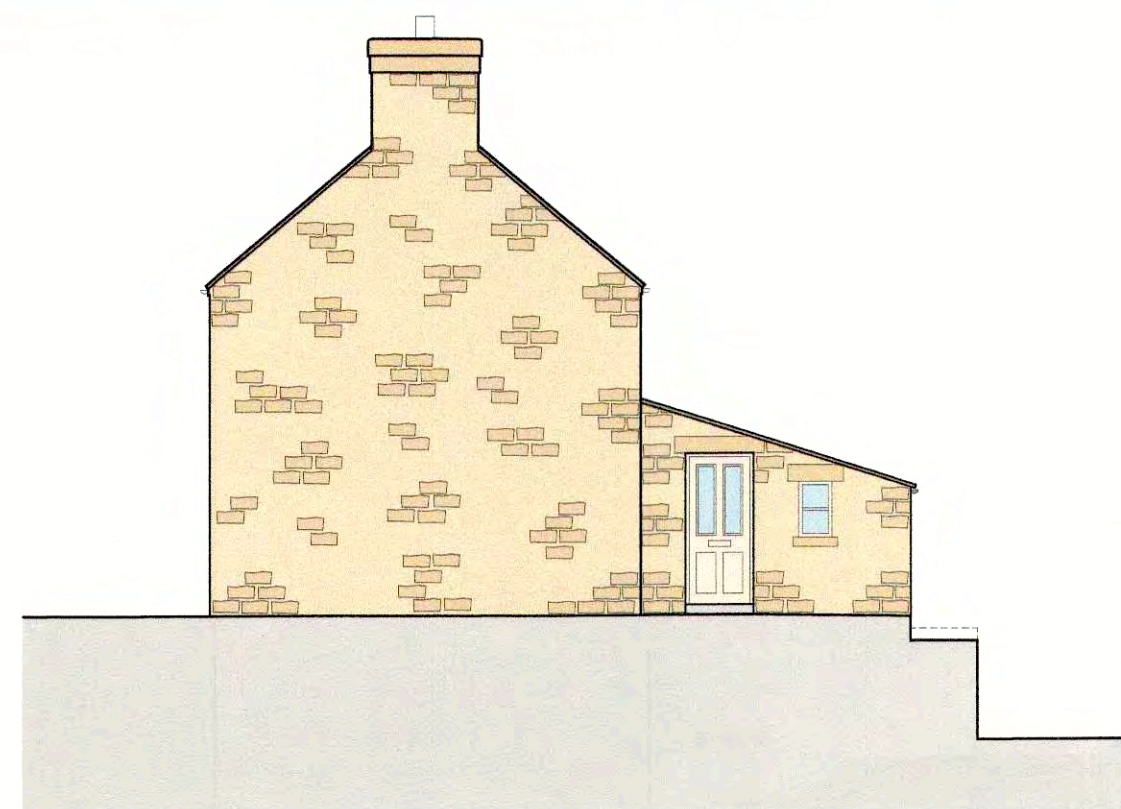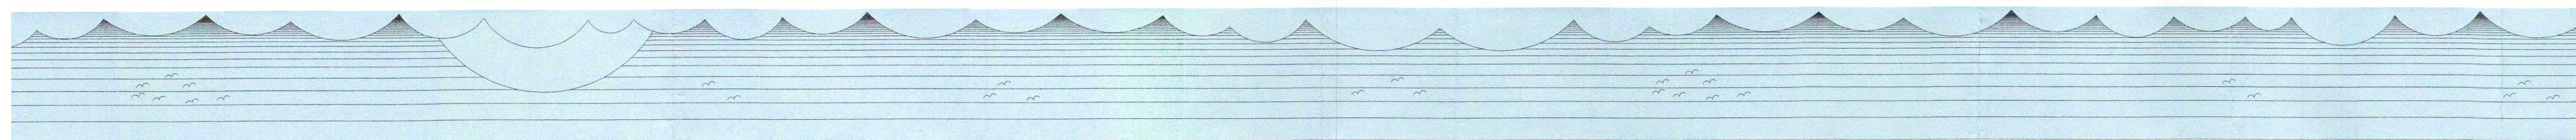


Side Elevation
 Scale 1:100 @ A1

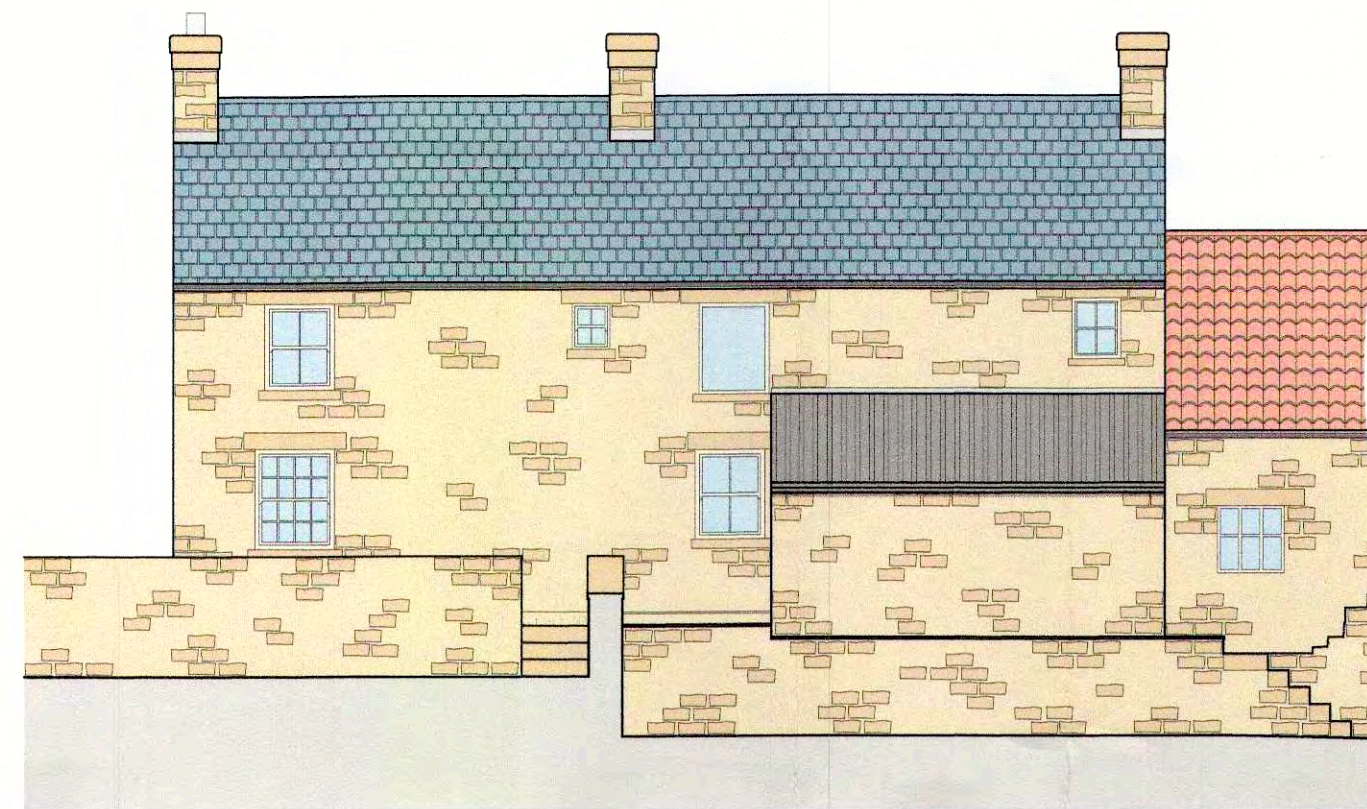

Rear Elevation
 Scale 1:100 @ A1



Side Elevation
 Scale 1:100 @ A1

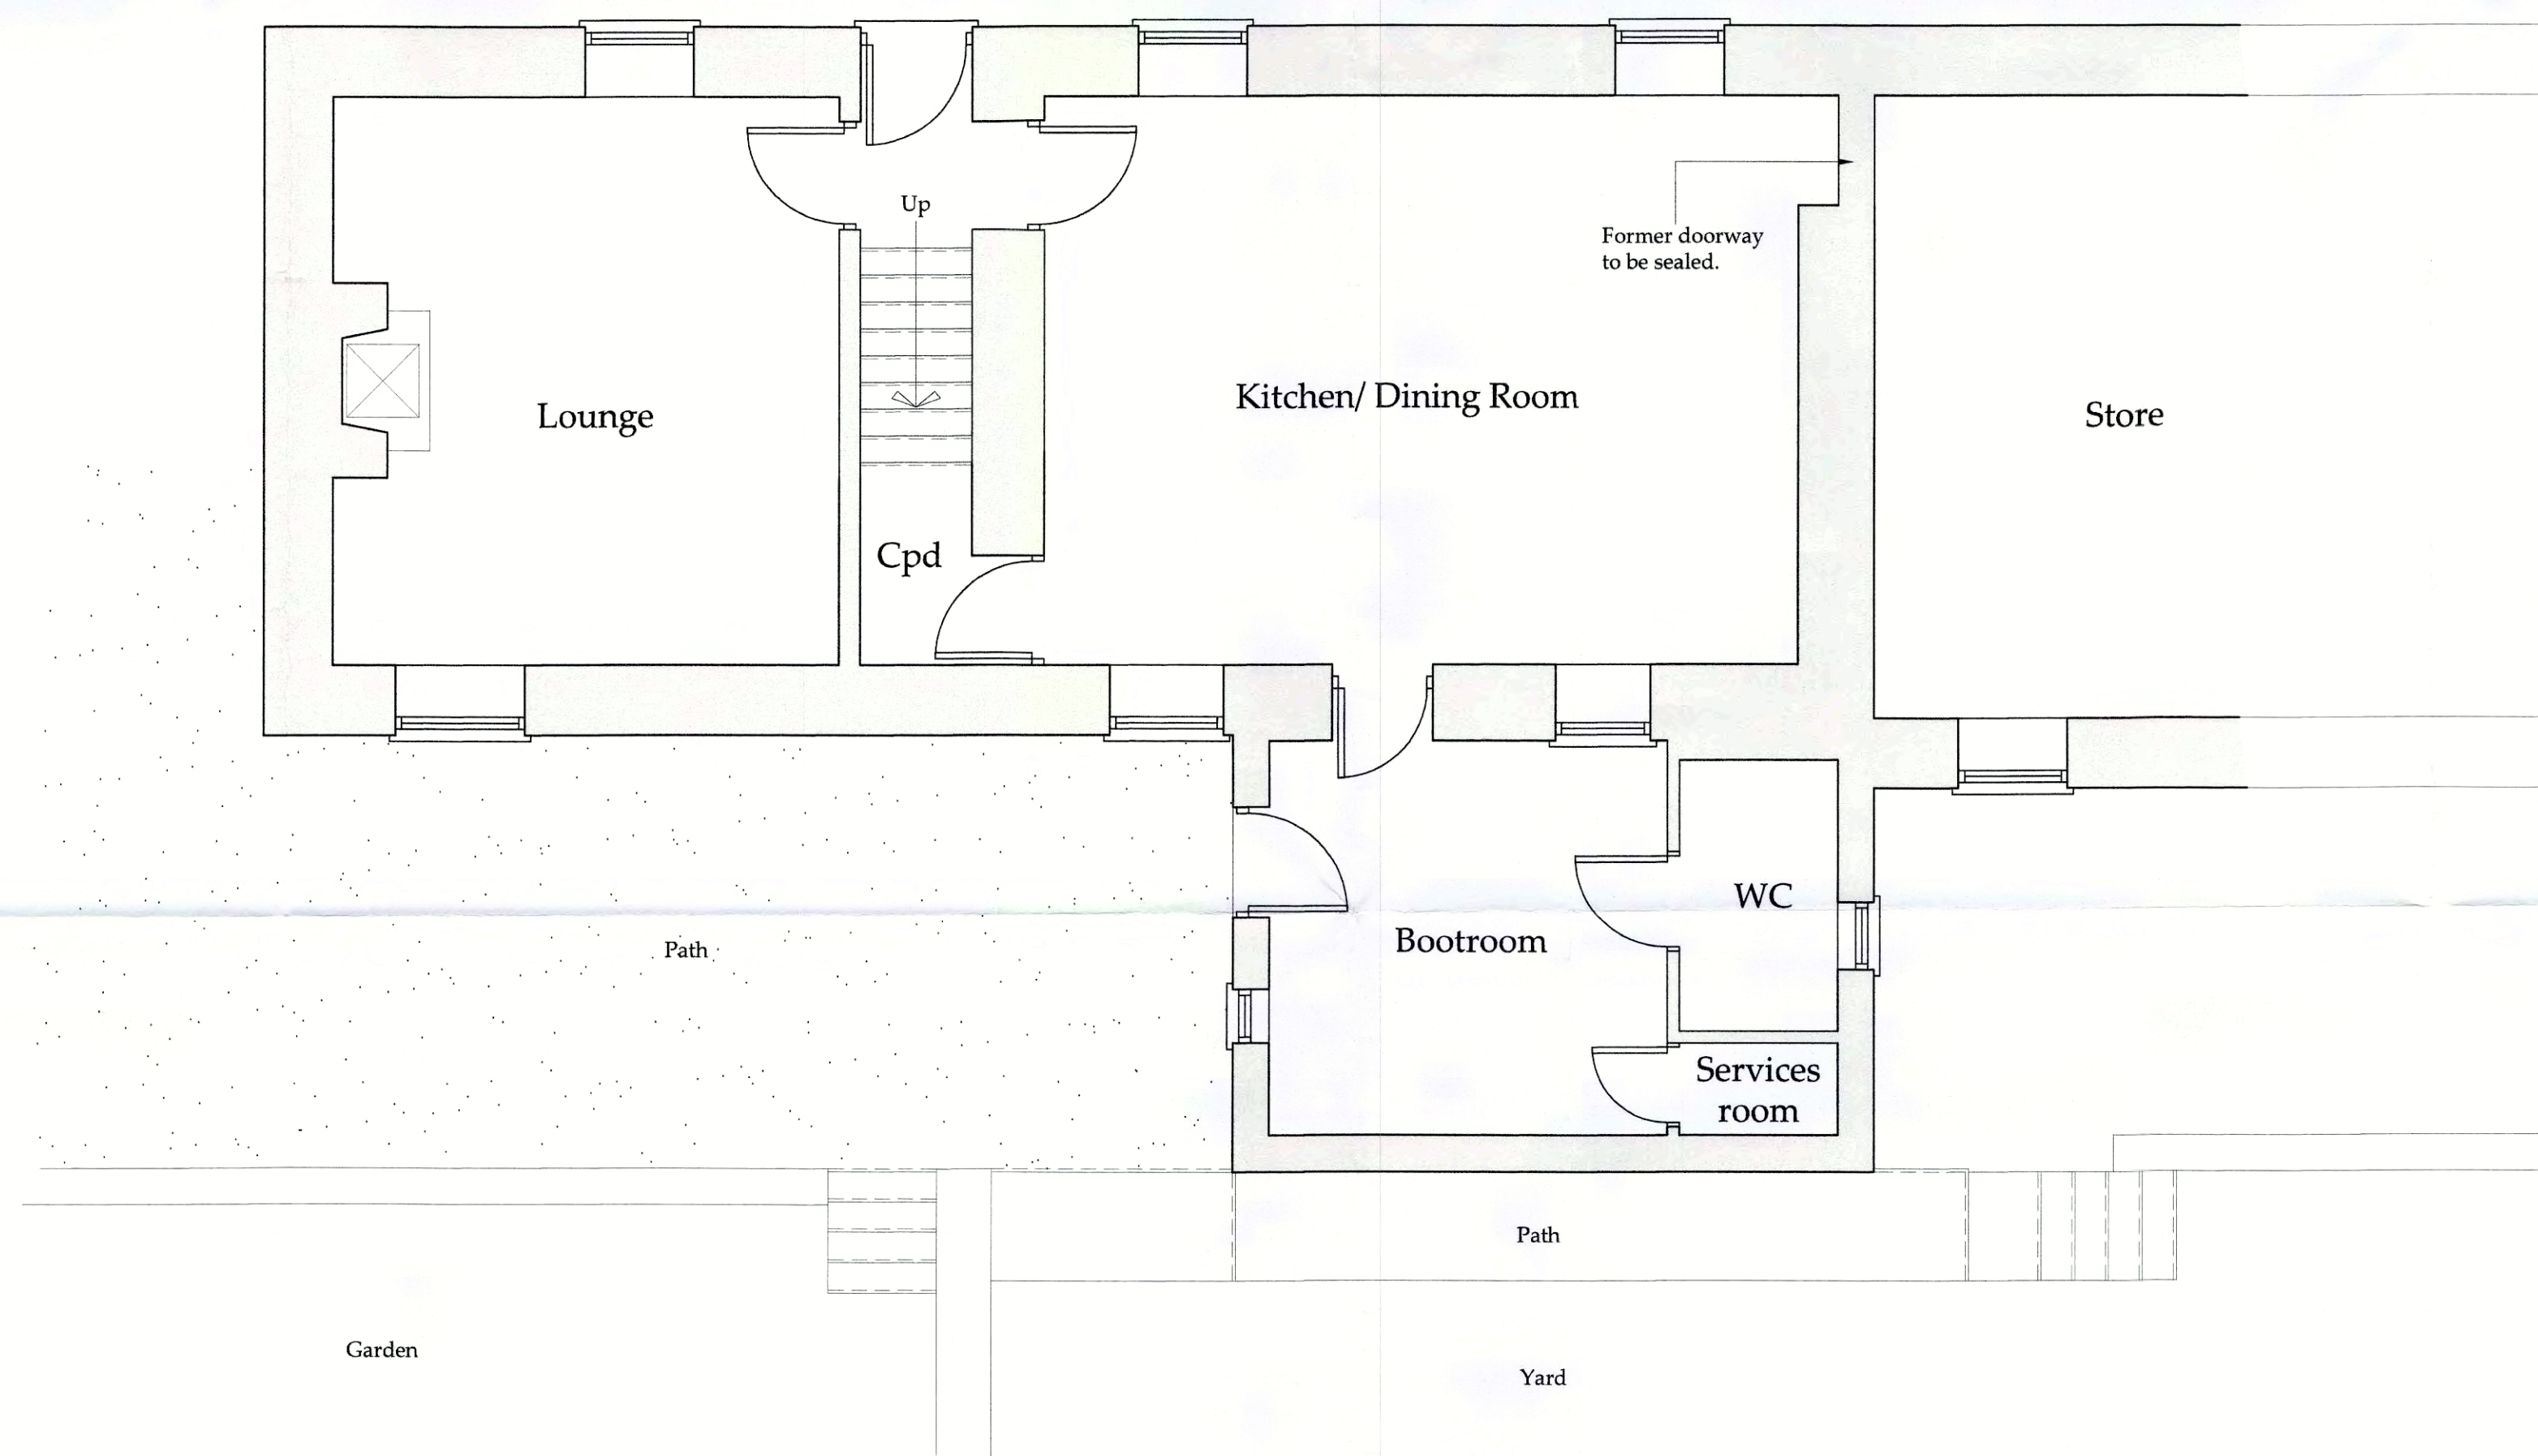

Ground Floor Plan
 Scale 1:50 @ A1

REV	DATE	BY	AMENDMENT
D	05.05.17	CW	Roof lowered to suit planners
C	03.05.17	CW	Amended to suit Planners
B	25.04.17	CW	Amended to suit client
A	30.03.17	CW	Issued for approval

NYMNP
 11 MAY 2017

bhd
 partnership
 Architecture + Engineering

Alry Hill Manor, Waterstead Lane,
 Whitby, N. Yorks. YO21 1QB.

CLIENT:	Mr. D. Wilson		
PROJECT:	School Farm, Aislaby, Whitby.		
DRAWING:	Proposed Plans and Elevations		
DRAWING STATUS:	Planning		
DRAWN:	C. Walker	CHECKED:	T. Harrison
SCALE @ SIZE:	1:50, 1:100 @ A1	DATE:	27.03.17
DRAWING No:	D11154-04	REV:	D