



**NOTE:**  
This drawing is not to be scaled. All dimensions to be checked on site.  
Discrepancies, ambiguities and/or omissions between this drawing & information  
given elsewhere must be reported immediately to this office for clarification before  
proceeding.

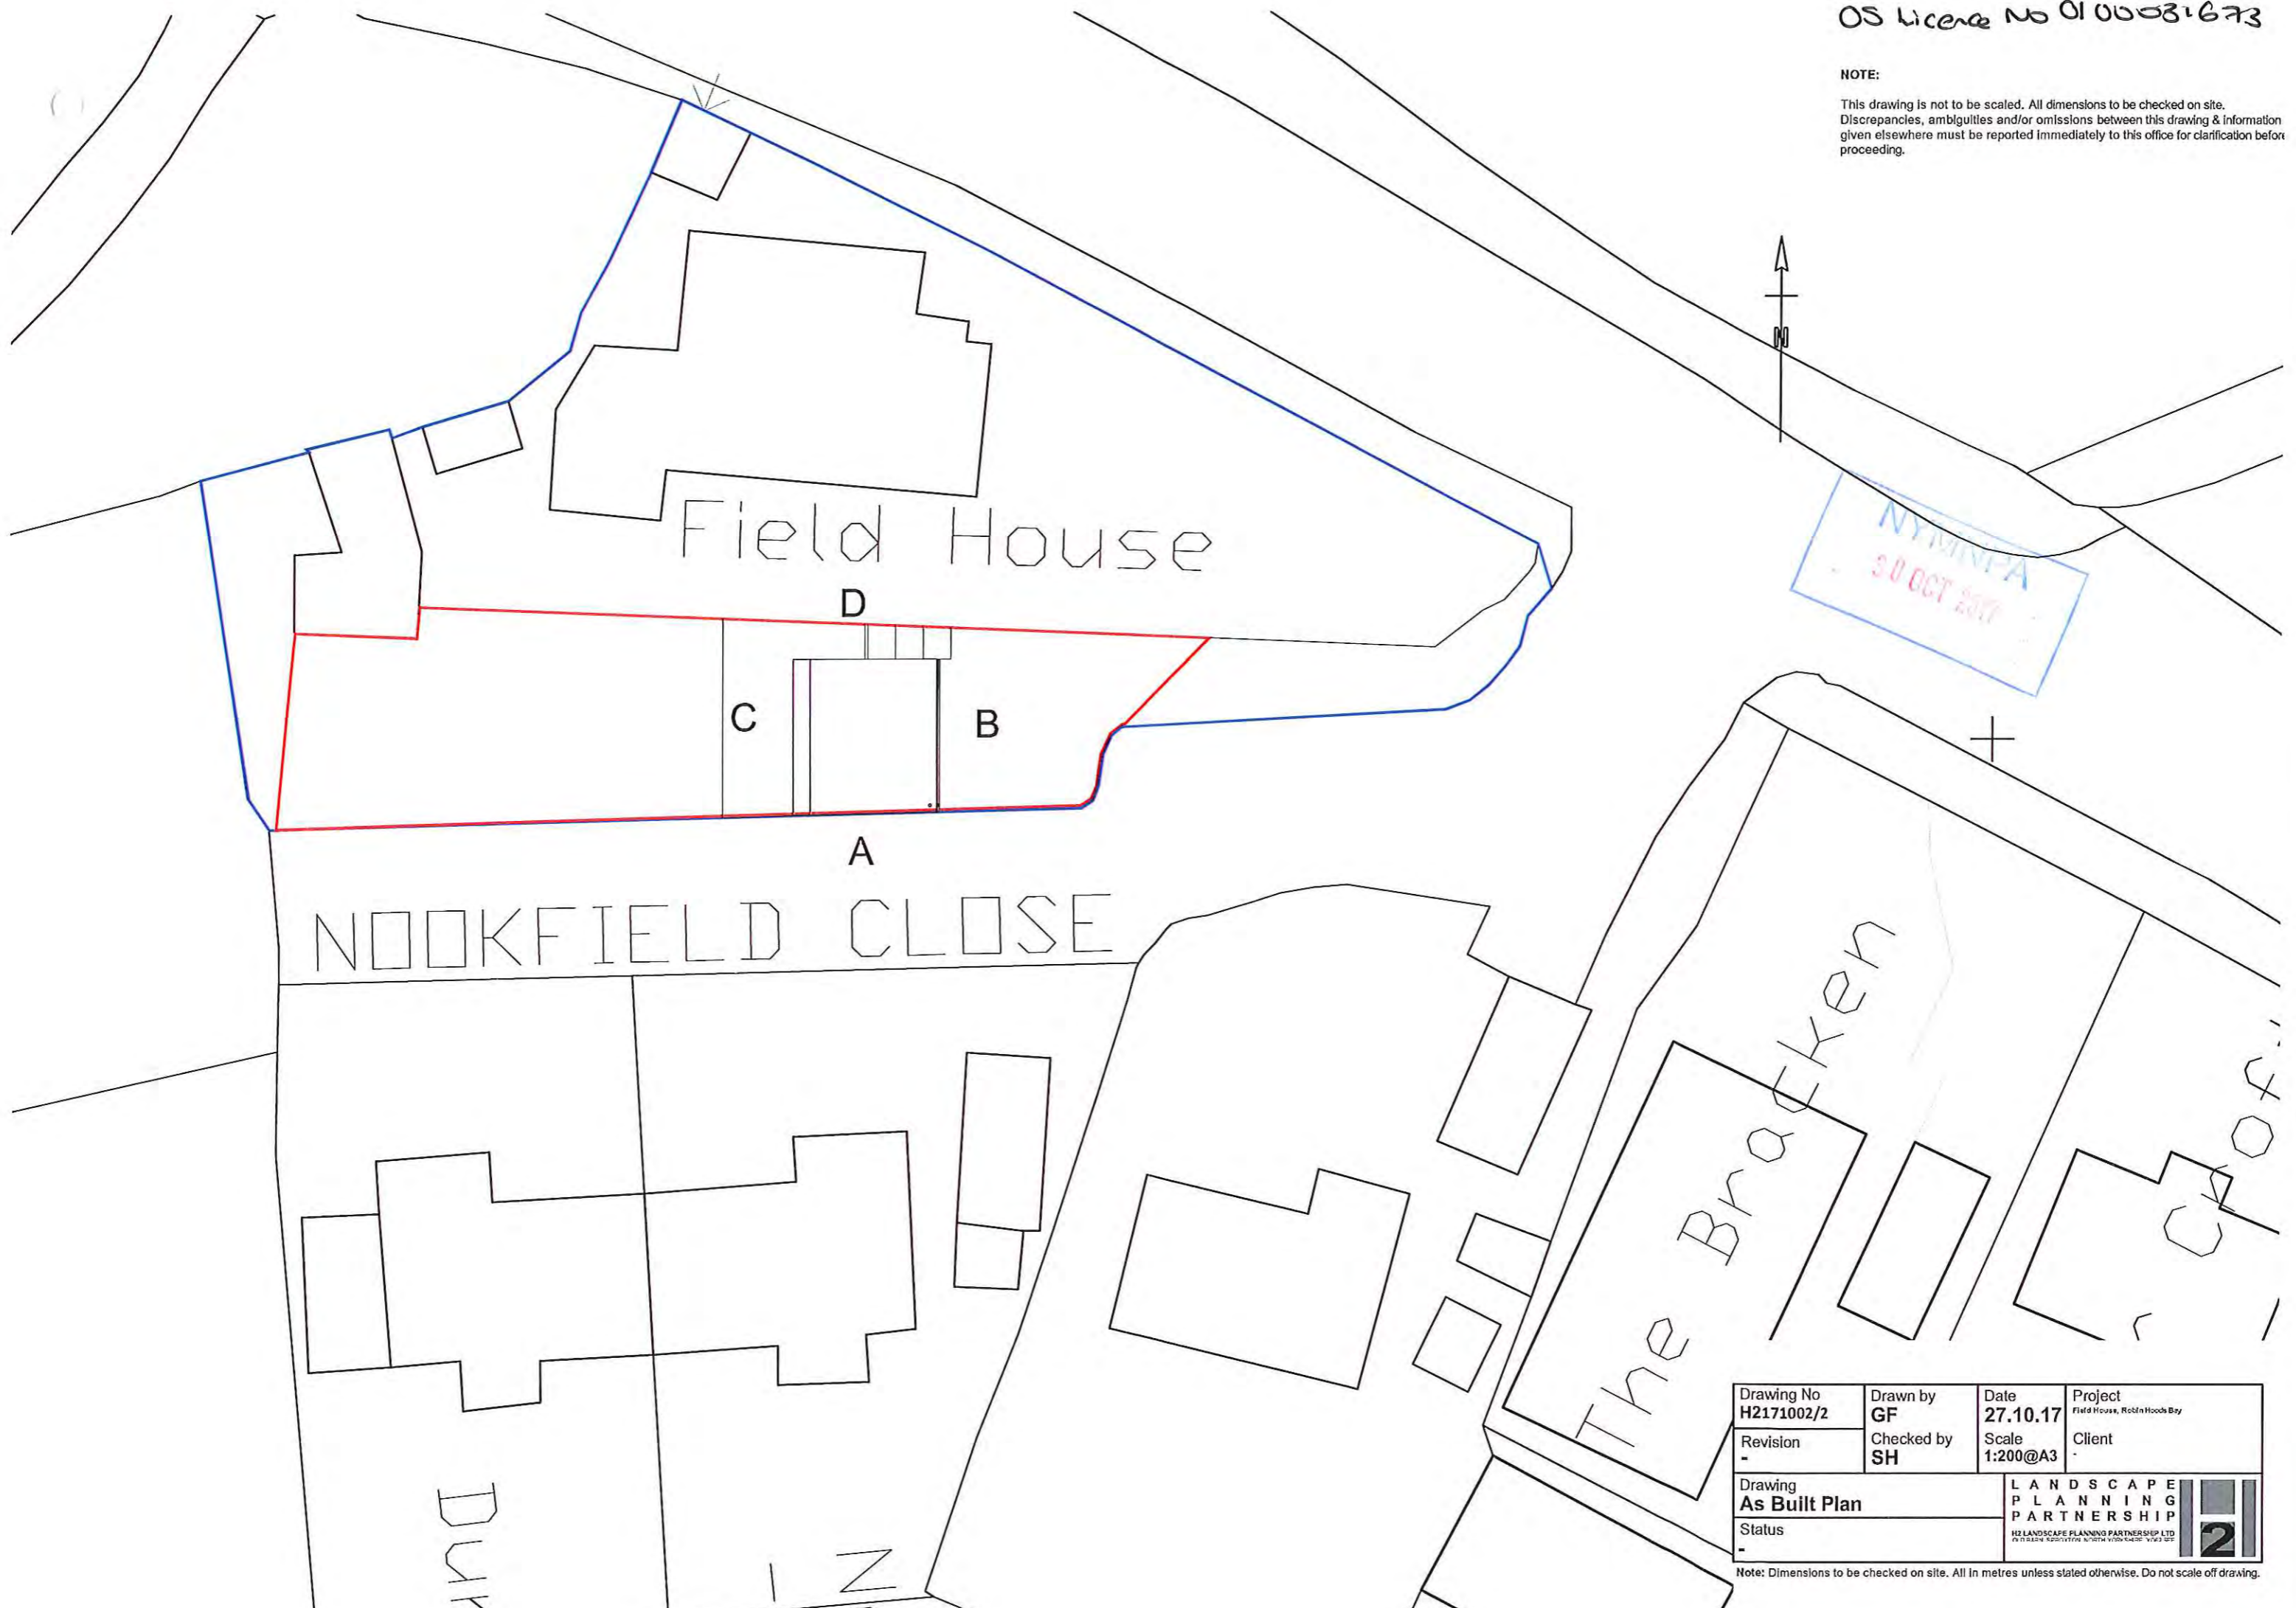

Drawing No <b>H2171002/2</b>	Drawn by <b>GF</b>	Date <b>27.10.17</b>	Project Field House, Robin Hood Bay
Revision -	Checked by <b>SH</b>	Scale <b>1:200@A3</b>	Client -
Drawing <b>As Built Plan</b>			<b>LANDSCAPE PLANNING PARTNERSHIP</b> <small>H2 LANDSCAPE PLANNING PARTNERSHIP LTD 10 THE BARN, ROBINHOOD BAY, NORTH YORKSHIRE YO21 2EE</small> 
Status -			

Note: Dimensions to be checked on site. All in metres unless stated otherwise. Do not scale off drawing.



**NOTE:**  
 This drawing is not to be scaled. All dimensions to be checked on site. Discrepancies, ambiguities and/or omissions between this drawing & information given elsewhere must be reported immediately to this office for clarification before proceeding.






NYM/NPA  
 20 OCT 2017

Drawing No <b>H2171002/1</b>	Drawn by <b>GF</b>	Date <b>27.10.17</b>	Project Field House, RobinHoods Bay
Revision -	Checked by <b>SH</b>	Scale <b>1:1250@A3</b>	Client -
Drawing <b>Location Plan</b>			<b>LANDSCAPE          PLANNING          PARTNERSHIP</b> <small>112 LANDSCAPE PLANNING PARTNERSHIP LTD          112 RAINBOW ROAD, SOUTH WOODS, WOODS BAY, SOUTH AFRICA</small>
Status -			

Note: Dimensions to be checked on site. All in metres unless stated otherwise. Do not scale off drawing.

NYMNP  
30 OCT 2017

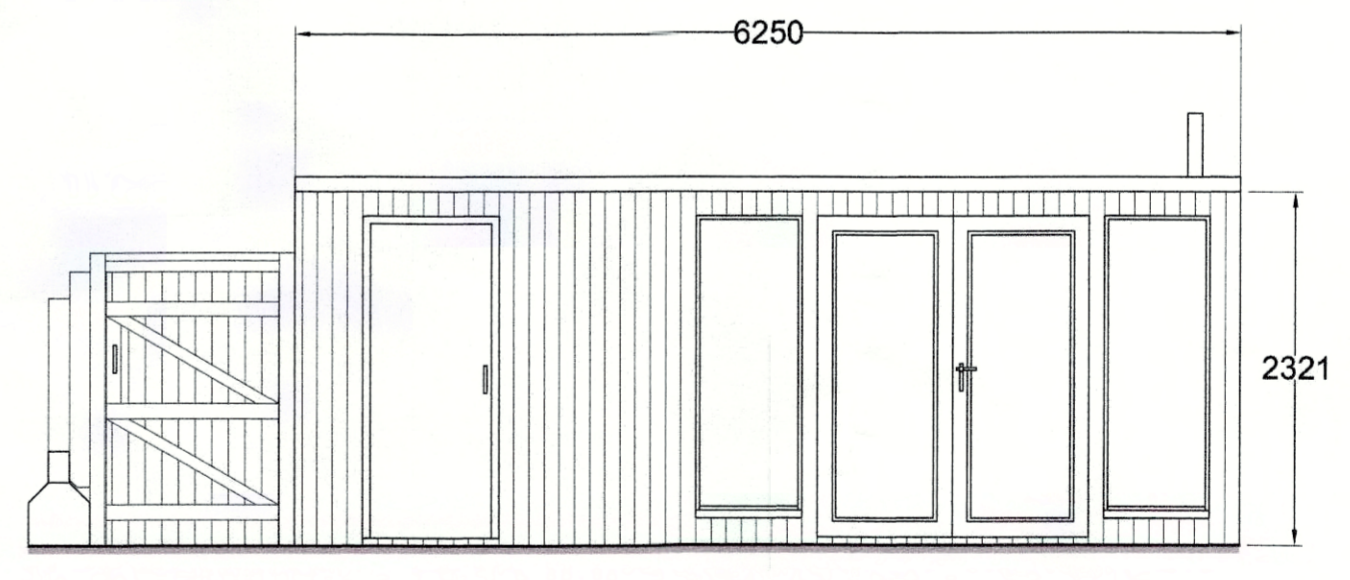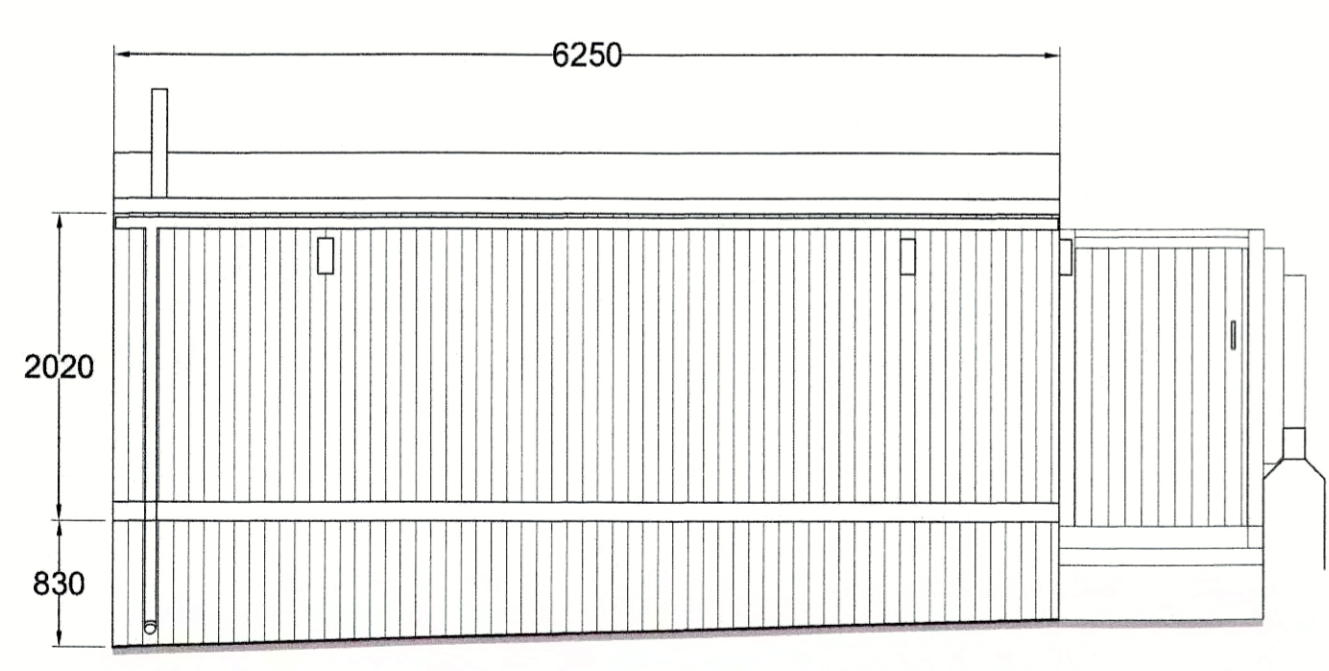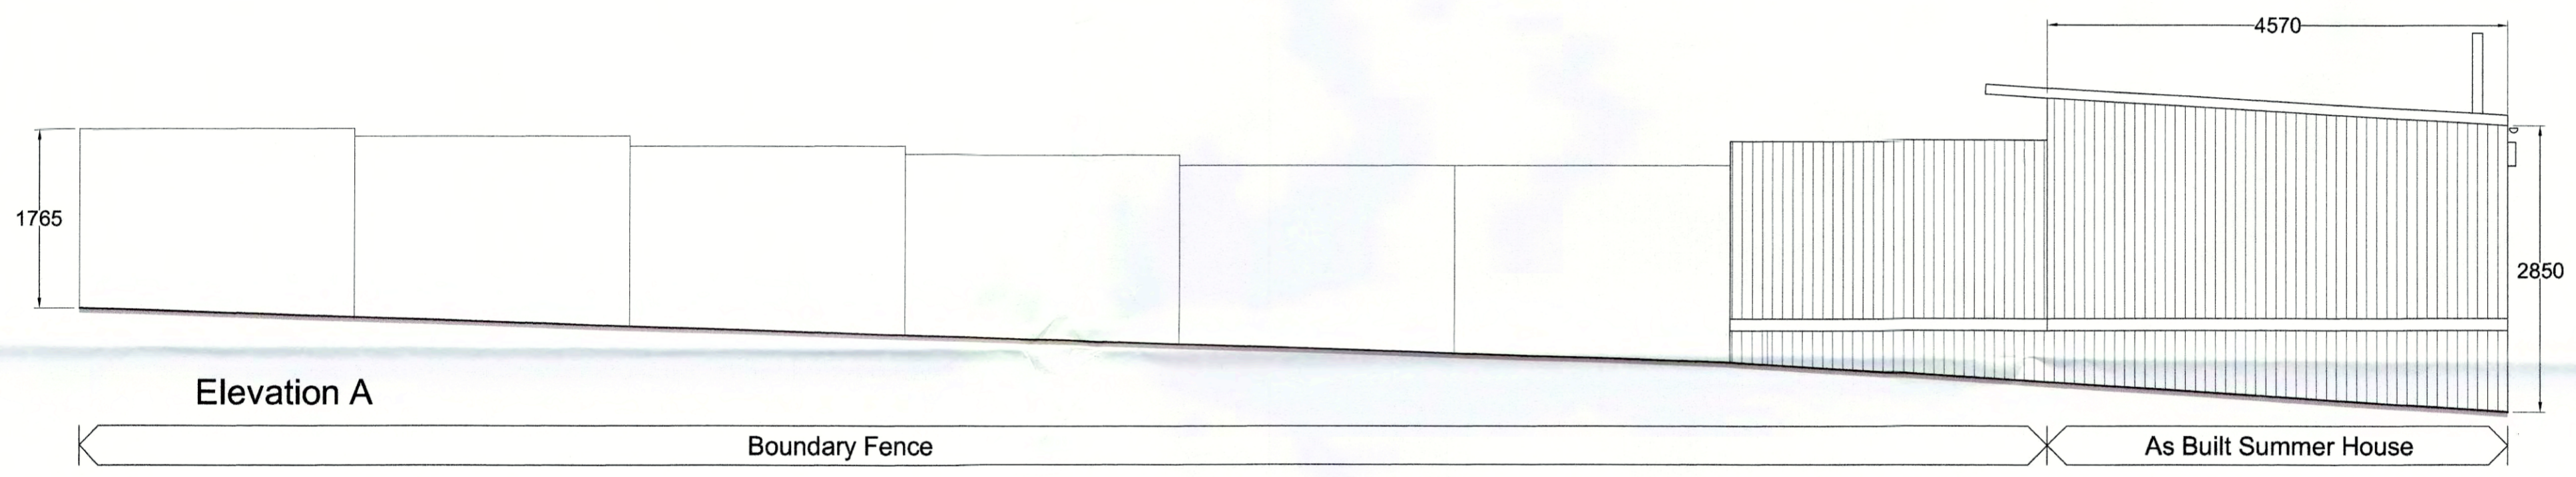

Drawing No <b>H2171002/3</b>	Drawn by <b>GF</b>	Date <b>27.10.17</b>	Project Field House, Robin Hood Day
Revision	Checked by <b>SH</b>	Scale <b>1:50@A2</b>	Client
Drawing <b>As Built Elevations</b>			LANDSCAPE PLANNING PARTNERSHIP
Status			LANDSCAPE PLANNING PARTNERSHIP LTD 111-113 SOUTH BRIDGE STREET, LONDON, E1C 7BT <b>2</b>

Note: Dimensions to be checked on site. All in metres unless stated otherwise. Do not scale off drawing.