

○ **Site Plan**
Scale 1:1250

NYMNP
28/02/2018

○ **Block Plan**
Scale 1:500

Ordnance Survey Licence No. 100002562

b h d partnership
Airy Hill Manor, Whitby, North Yorkshire, UK, YO21 1QB.


●DO NOT SCALE from this drawing. Only figured dimensions are to be taken from this drawing.
●The Contractor must verify all dimensions on site before commencing any work or shop drawings.
The Contractor must report any discrepancies before commencing work. If this drawing exceeds the quantities taken in any way, the Technician is to be informed before work is initiated.
Work within The Construction (Design and Management) Regulations 2015 is not to start until a Health & Safety Plan has been produced. This drawing is Copyright and must not be reproduced without consent of BHD Partnership Ltd

A	11.04.17	CW	Issued for approval	TRH	
REV	DATE		AMENDMENT	CHKD	APVD


CLIENT: Mr. D. Wilson		
PROJECT: School Farm, Aislaby		
A3	DRN: C. Walker	DATE: 11.04.17
SCALE:	As shown	ISSUE: Planning

DRAWING TITLE: Site Plan and Block Plan	
DRAWING NR: D11154-01	REV: A

Do not scale from this drawing, only figured dimensions are to be taken from this drawing.
 The contractor must verify all dimensions on site before commencing any work or shop drawings.
 The contractor must report any discrepancies before commencing work. If this drawing exceeds the quantities taken in any way, the technician is to be informed before work is initiated.
 Work within the construction (design and management) regulations 2015 is not to start until a health & safety plan has been produced. This drawing is copyright and must not be reproduced without consent of BHD Partnership Ltd.

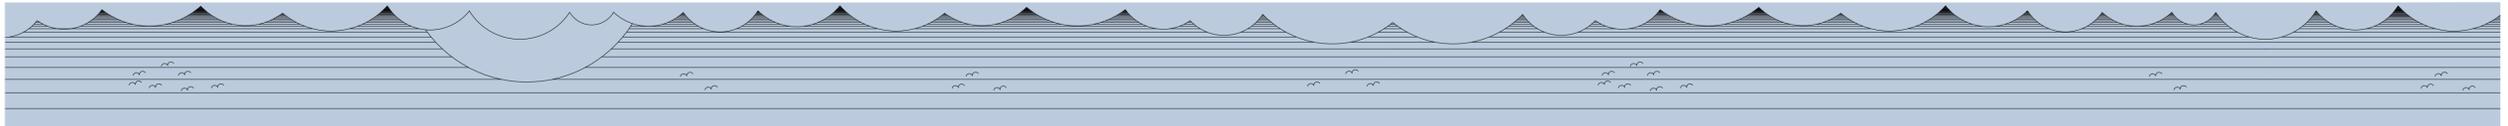

Side Elevation
 Scale 1:100 @ A1

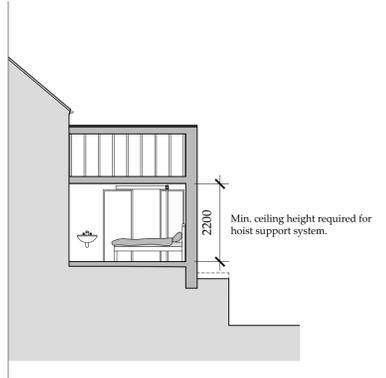


Side Section
 Scale 1:100 @ A1



Rear Elevation
 Scale 1:100 @ A1



Side Elevation
 Scale 1:100 @ A1

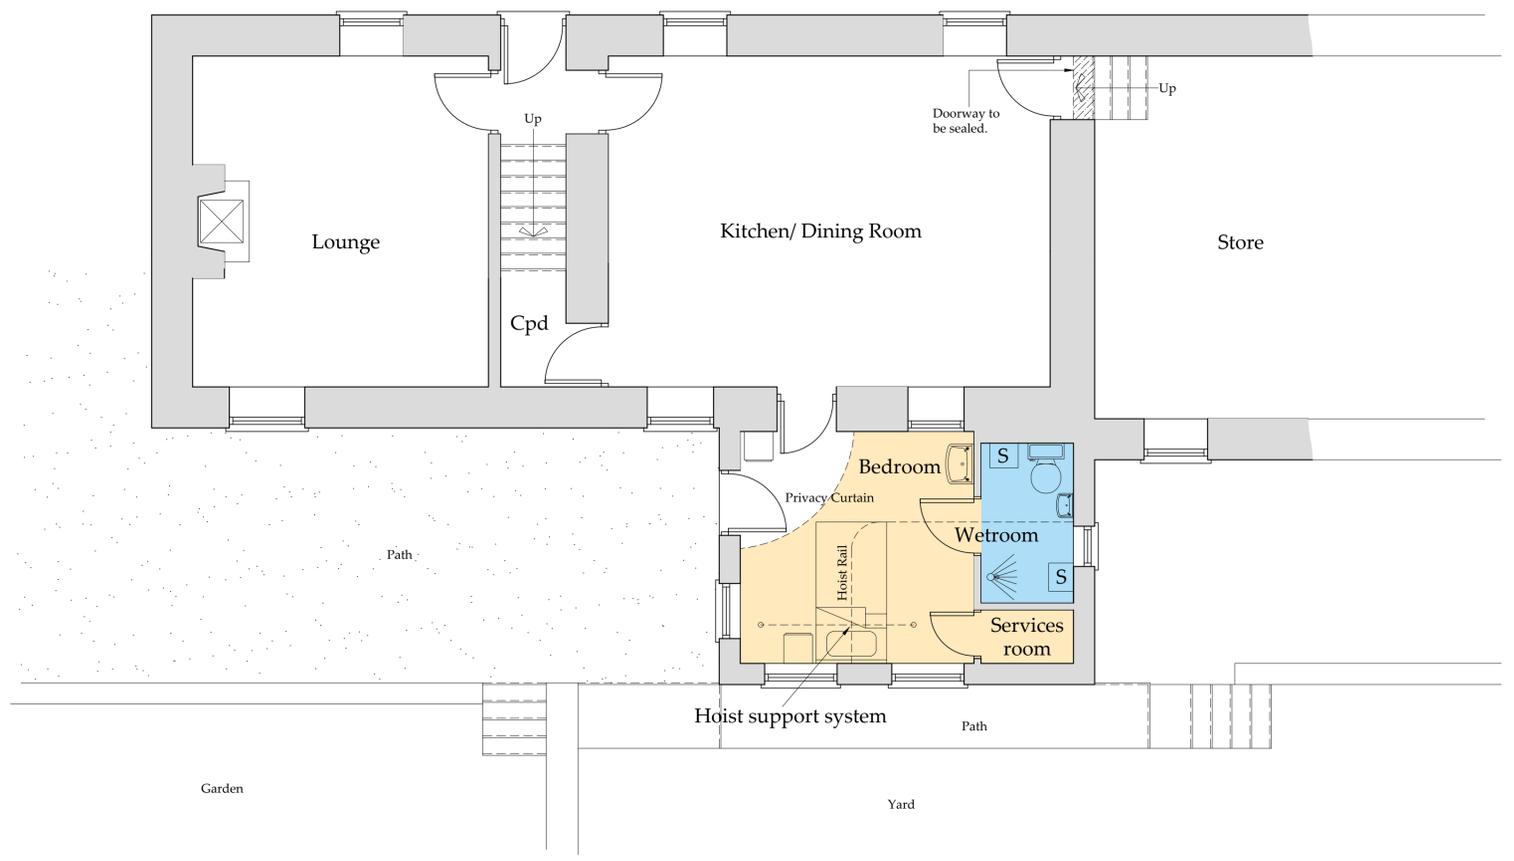

Ground Floor Plan
 Scale 1:50 @ A1

REV	DATE	BY	AMENDMENT
D	19.01.18	RB	Minor amendments
C	17.01.18	RB	Minor amendments
B	25.04.17	CW	Amended to suit client
A	30.03.17	CW	Issued for approval

bhd
 partnership
 Architecture + Engineering

Airy Hill Manor, Waterstead Lane,
 Whitby, N. Yorks. YO21 1QB.

CLIENT: **Mr. D. Wilson**

PROJECT: **School Farm, Aislaby, Whitby.**

Drawing: **As built Plans and Elevations**


DRAWING STATUS: **Planning**

DRAWN: **C. Walker** CHECKED: **T. Harrison**


SCALE @ SIZE: **1:50, 1:100 @ A1** DATE: **27.03.17**

DRAWING No: **D11154-03** REV: **D**

Do not scale from this drawing, only figured dimensions are to be taken from this drawing.
 The contractor must verify all dimensions on site before commencing any work or shop drawings.
 The contractor must report any discrepancies before commencing work. If this drawing exceeds the quantities taken in any way, the technician is to be informed before work is initiated.
 Work within the construction (design and management) regulations 2015 is not to start until a health & safety plan has been produced. This drawing is copyright and must not be reproduced without consent of BHD Partnership Ltd.

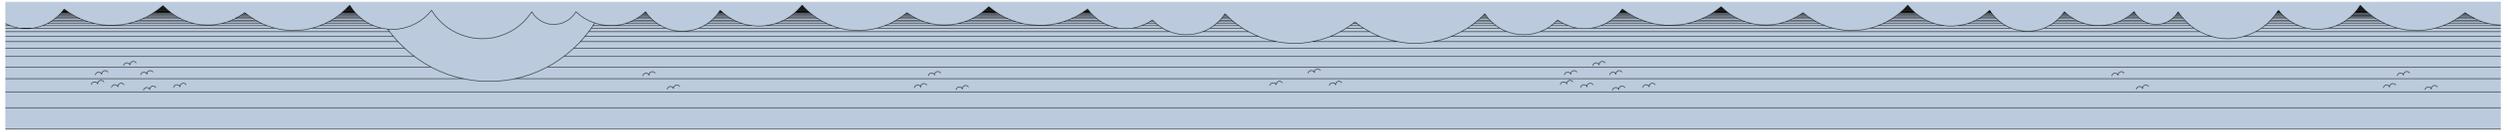


Side Elevation
 Scale 1:100 @ A1

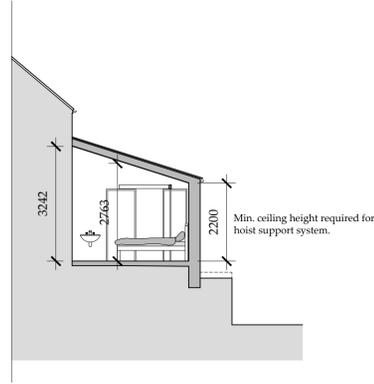


Side Section
 Scale 1:100 @ A1



Rear Elevation
 Scale 1:100 @ A1

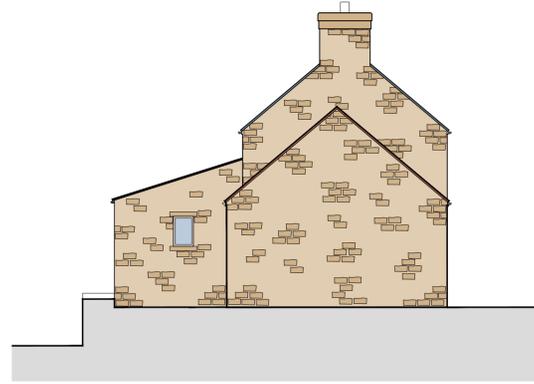

Side Elevation
 Scale 1:100 @ A1

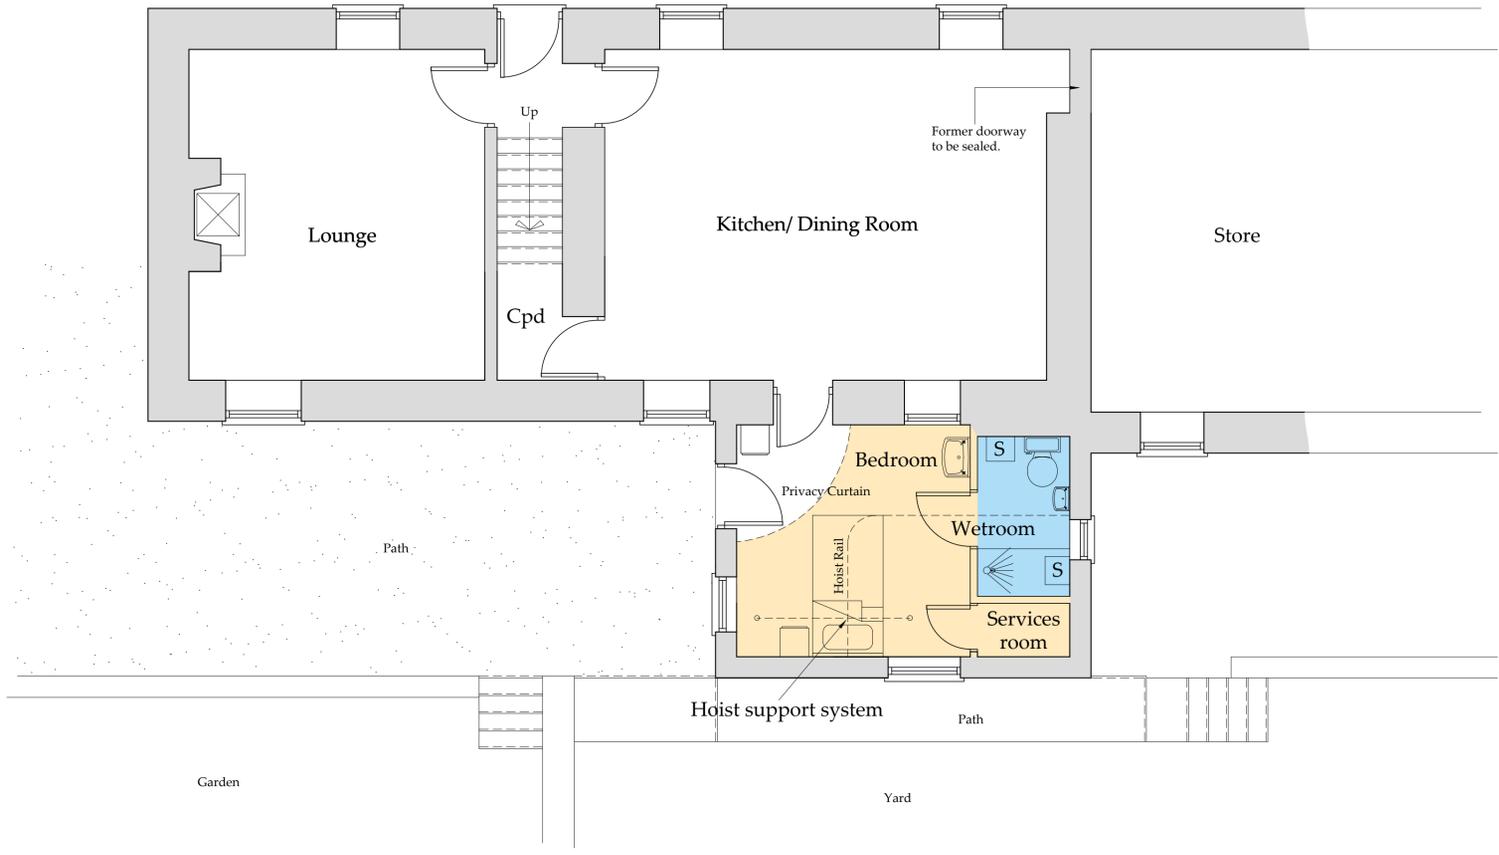

Ground Floor Plan
 Scale 1:50 @ A1

REV	DATE	BY	AMENDMENT
D	28.02.18	RB	Removal of first floor window
C	14.02.18	RB	Minor amendments
B	19.01.18	RB	Minor amendment
A	17.01.18	RB	Issued for approval

bhd
 partnership
 Architecture + Engineering

Airy Hill Manor, Waterstead Lane,
 Whitby, N. Yorks. YO21 1QB.

CLIENT:	Mr. D. Wilson		
PROJECT:	School Farm, Aislaby, Whitby.		
DRAWING STATUS:	Planning		
DRAWN:	R. Braithwaite	CHECKED:	T. Harrison
SCALE @ SIZE:	1:50, 1:100 @ A1	DATE:	17.01.18
DRAWING No:	D11154-09	REV:	D