
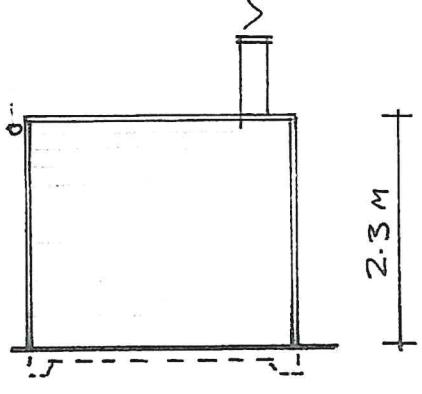
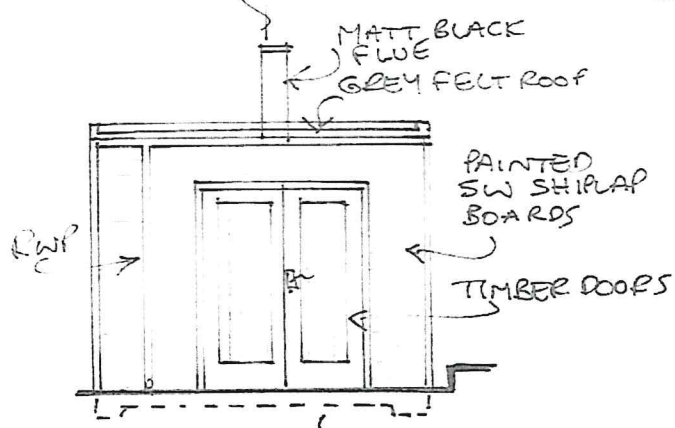


AS APPROVED

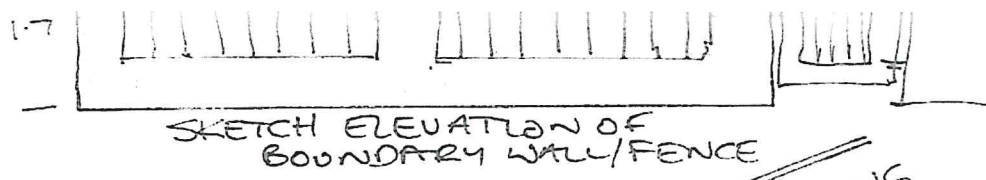


SIDE ELEVATION

NYMNP
24 APR 2020

ADJACENT PROPERTY

2.5M

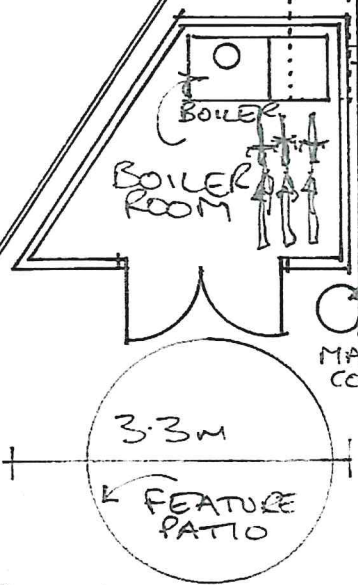

1.7m fence with stone dado and columns



EXTENS

INSULATED PIPEWORK UNDERGROUND TO HO

COTTAGE ONE

GATE ACCESS



AS APPROVED

Rev A Boundary fence/wall added
24.11


PROPOSED BOILER HOUSE
COTTAGE ONE DUNSLEY HALL
PLAN AND ELEVATIONS Scale 1:75

As proposed

SKETCH ELEVATION GARDEN FENCE (WALL Scale 1:100

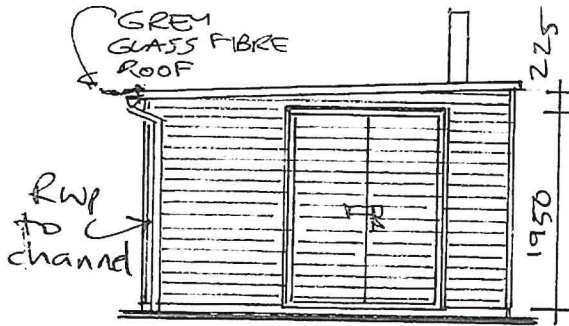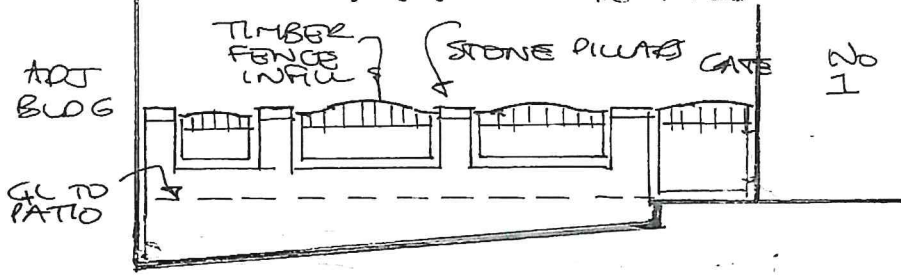


FRONT ELEVATION

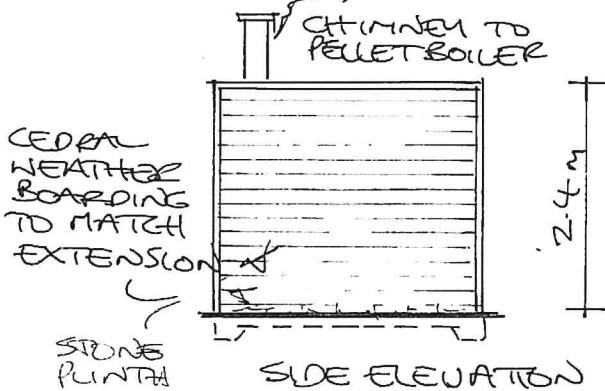

SIDE ELEVATION

NYMIRPA
24 APR 2017

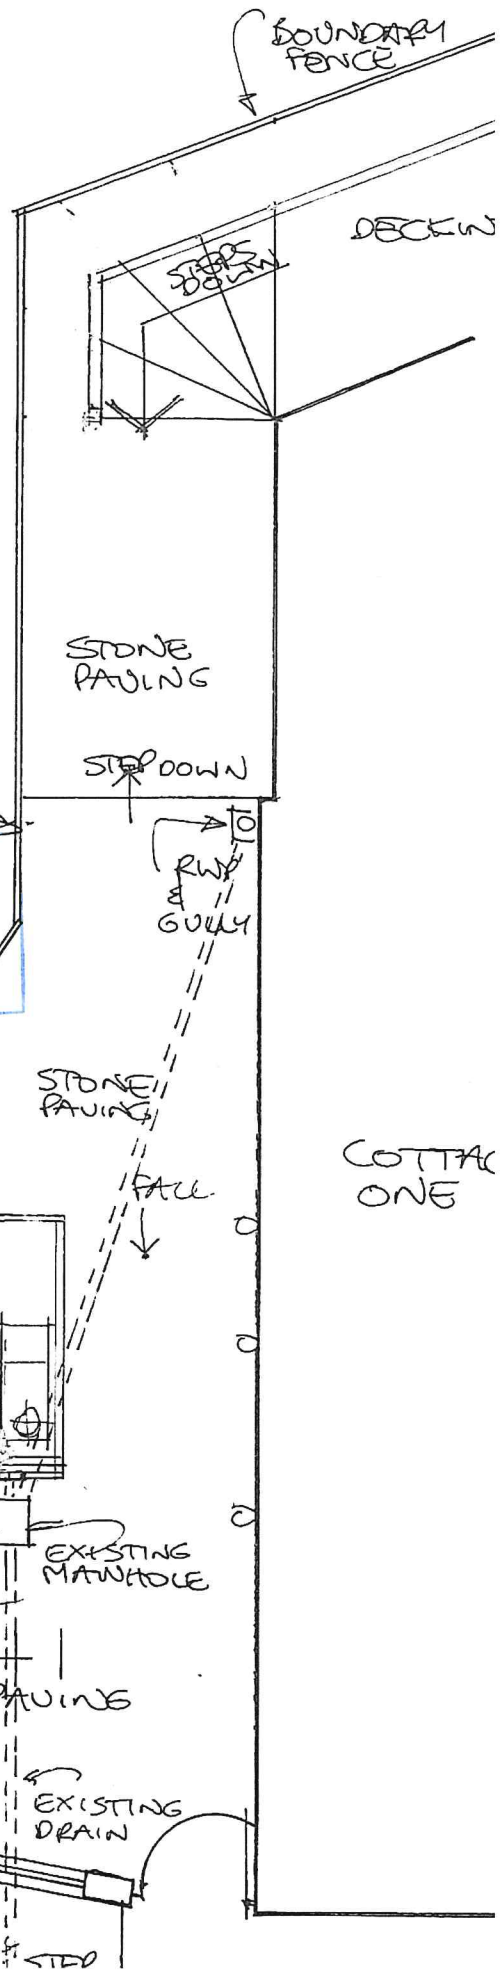

PROPOSED EXTERNAL WORKS & BOILER ROOM

COTTAGE ONE
DUNSLEY HALL
SCALE 1:75
AS BUILT JAN 17
AND PROPOSED

ADJACENT PROPERTY

1.4 m PILLARS WITH TIMBER FENCE INFILL

