




North
Yorkshire
Police

30.9.08

Hilary Saunders
Senior Area Planning Officer
North Yorks National park authority
The Old Vicarage
Bondgate
Helmsley
York
YO62 5BP

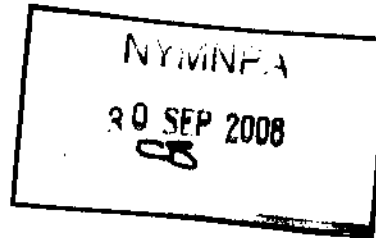

Proposed Security Fencing, Ravenscar Mast Site, Ravenscar

Dear Hilary


Following our telephone conversation, please find enclosed our revised plan showing the new proposed position of our security fence at the Ravenscar Mast Site.

I hope you will agree that the erection of the fence in this new position will not cause any disruption to the existing Scheduled Ancient Monument (Green Dyke) which runs adjacent to the mast site.

Please add these drawings to the existing planning application (Ref:NYM/2008/0417/NEW), replacing the original Proposed Plans.

If you require any other information please don't hesitate to contact me.

Yours sincerely
For North Yorkshire Police



Simon Nozedar
Surveyor
Properties & Facilities
Mobile:07980686492
simon.nozedar@northyorkshire.pnn.uk

AMENDED

Notes



NY
90 SEP 2008

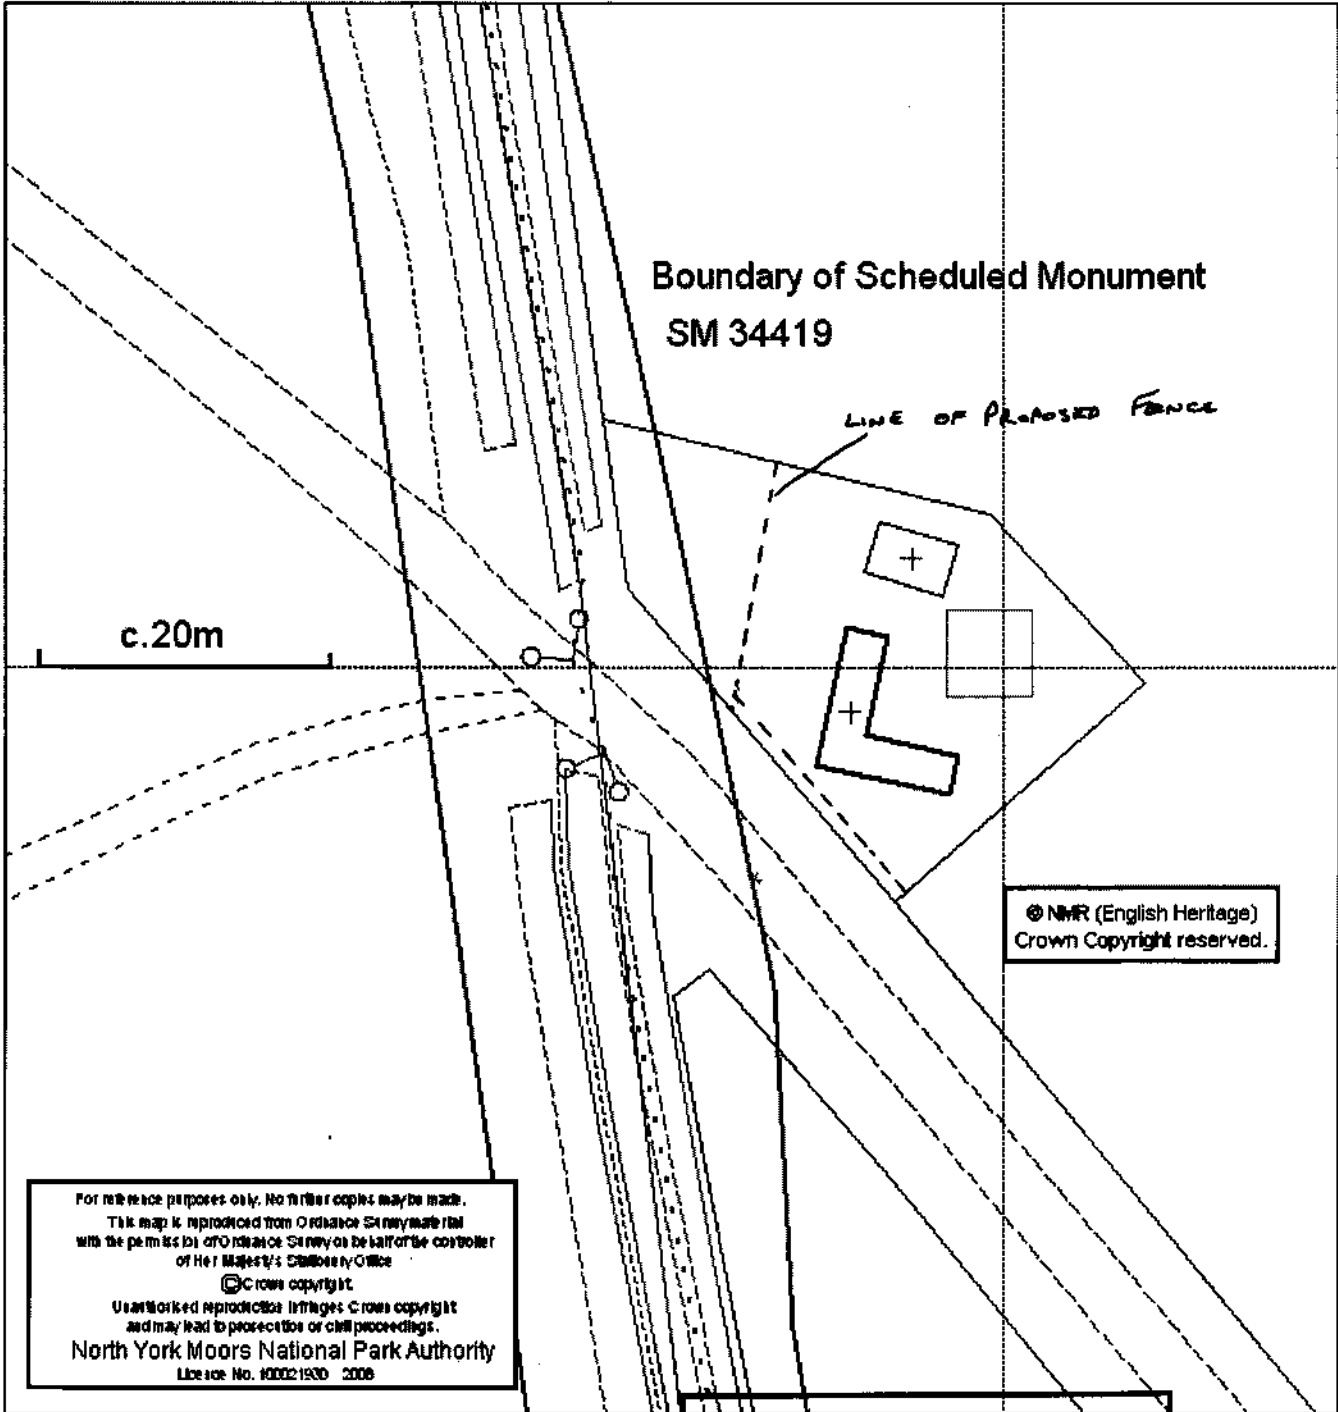

AMENDED


Notes

Notes:
 ©copyright. All rights reserved, this drawing must not be reproduced without the permission of Summers-Inman.
 Dimensions must not be scaled from this drawing.
 All dimensions are to be checked on site and discrepancies are to be referred to this office.

AMENDED

Notes

NYMNPA
 24 SEP 2008

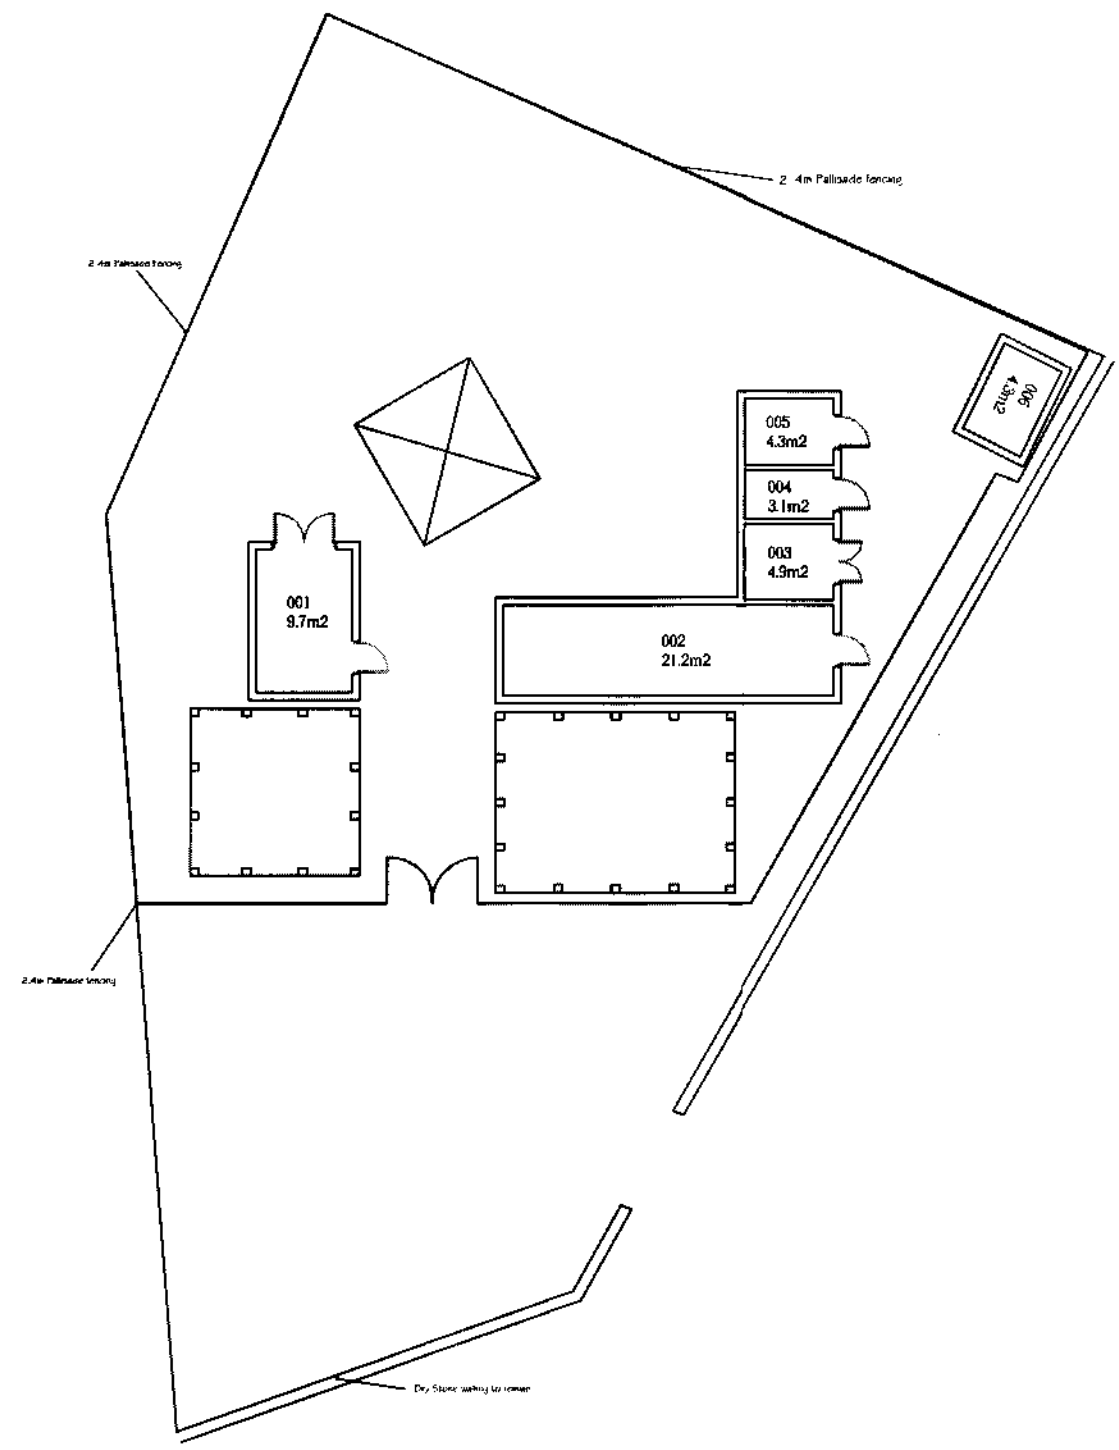

Drawn	JL	Date	10.08.07	Checked	ARW
Rev	Date	Description			
A	11.01.08	Inclusion of site boundary			
F	29.01.08	Summers Inman sign off			

Status INFORMATION

Summers Inman
 Construction & Property Consultants

62 The Drive Gosforth, Newcastle upon Tyne, NE3 4AR
 Tel: 0191 254 1121 Fax: 0191 255 3540
 Email: enquiries@summers-inman.co.uk
 Web Site: www.summers-inman.co.uk

Client NORTH YORKSHIRE POLICE

Project RAVENSCAR MAST

Title PROPOSED FLOOR PLAN
 (revision 1)

Scale	1/200	Sht.	A3
Dwg. No.	NE07055/B/1/79	Rev.	F