


JOB No.	/
DATE	11 OCT 2007
REPLIED	
COPY TO	DATE

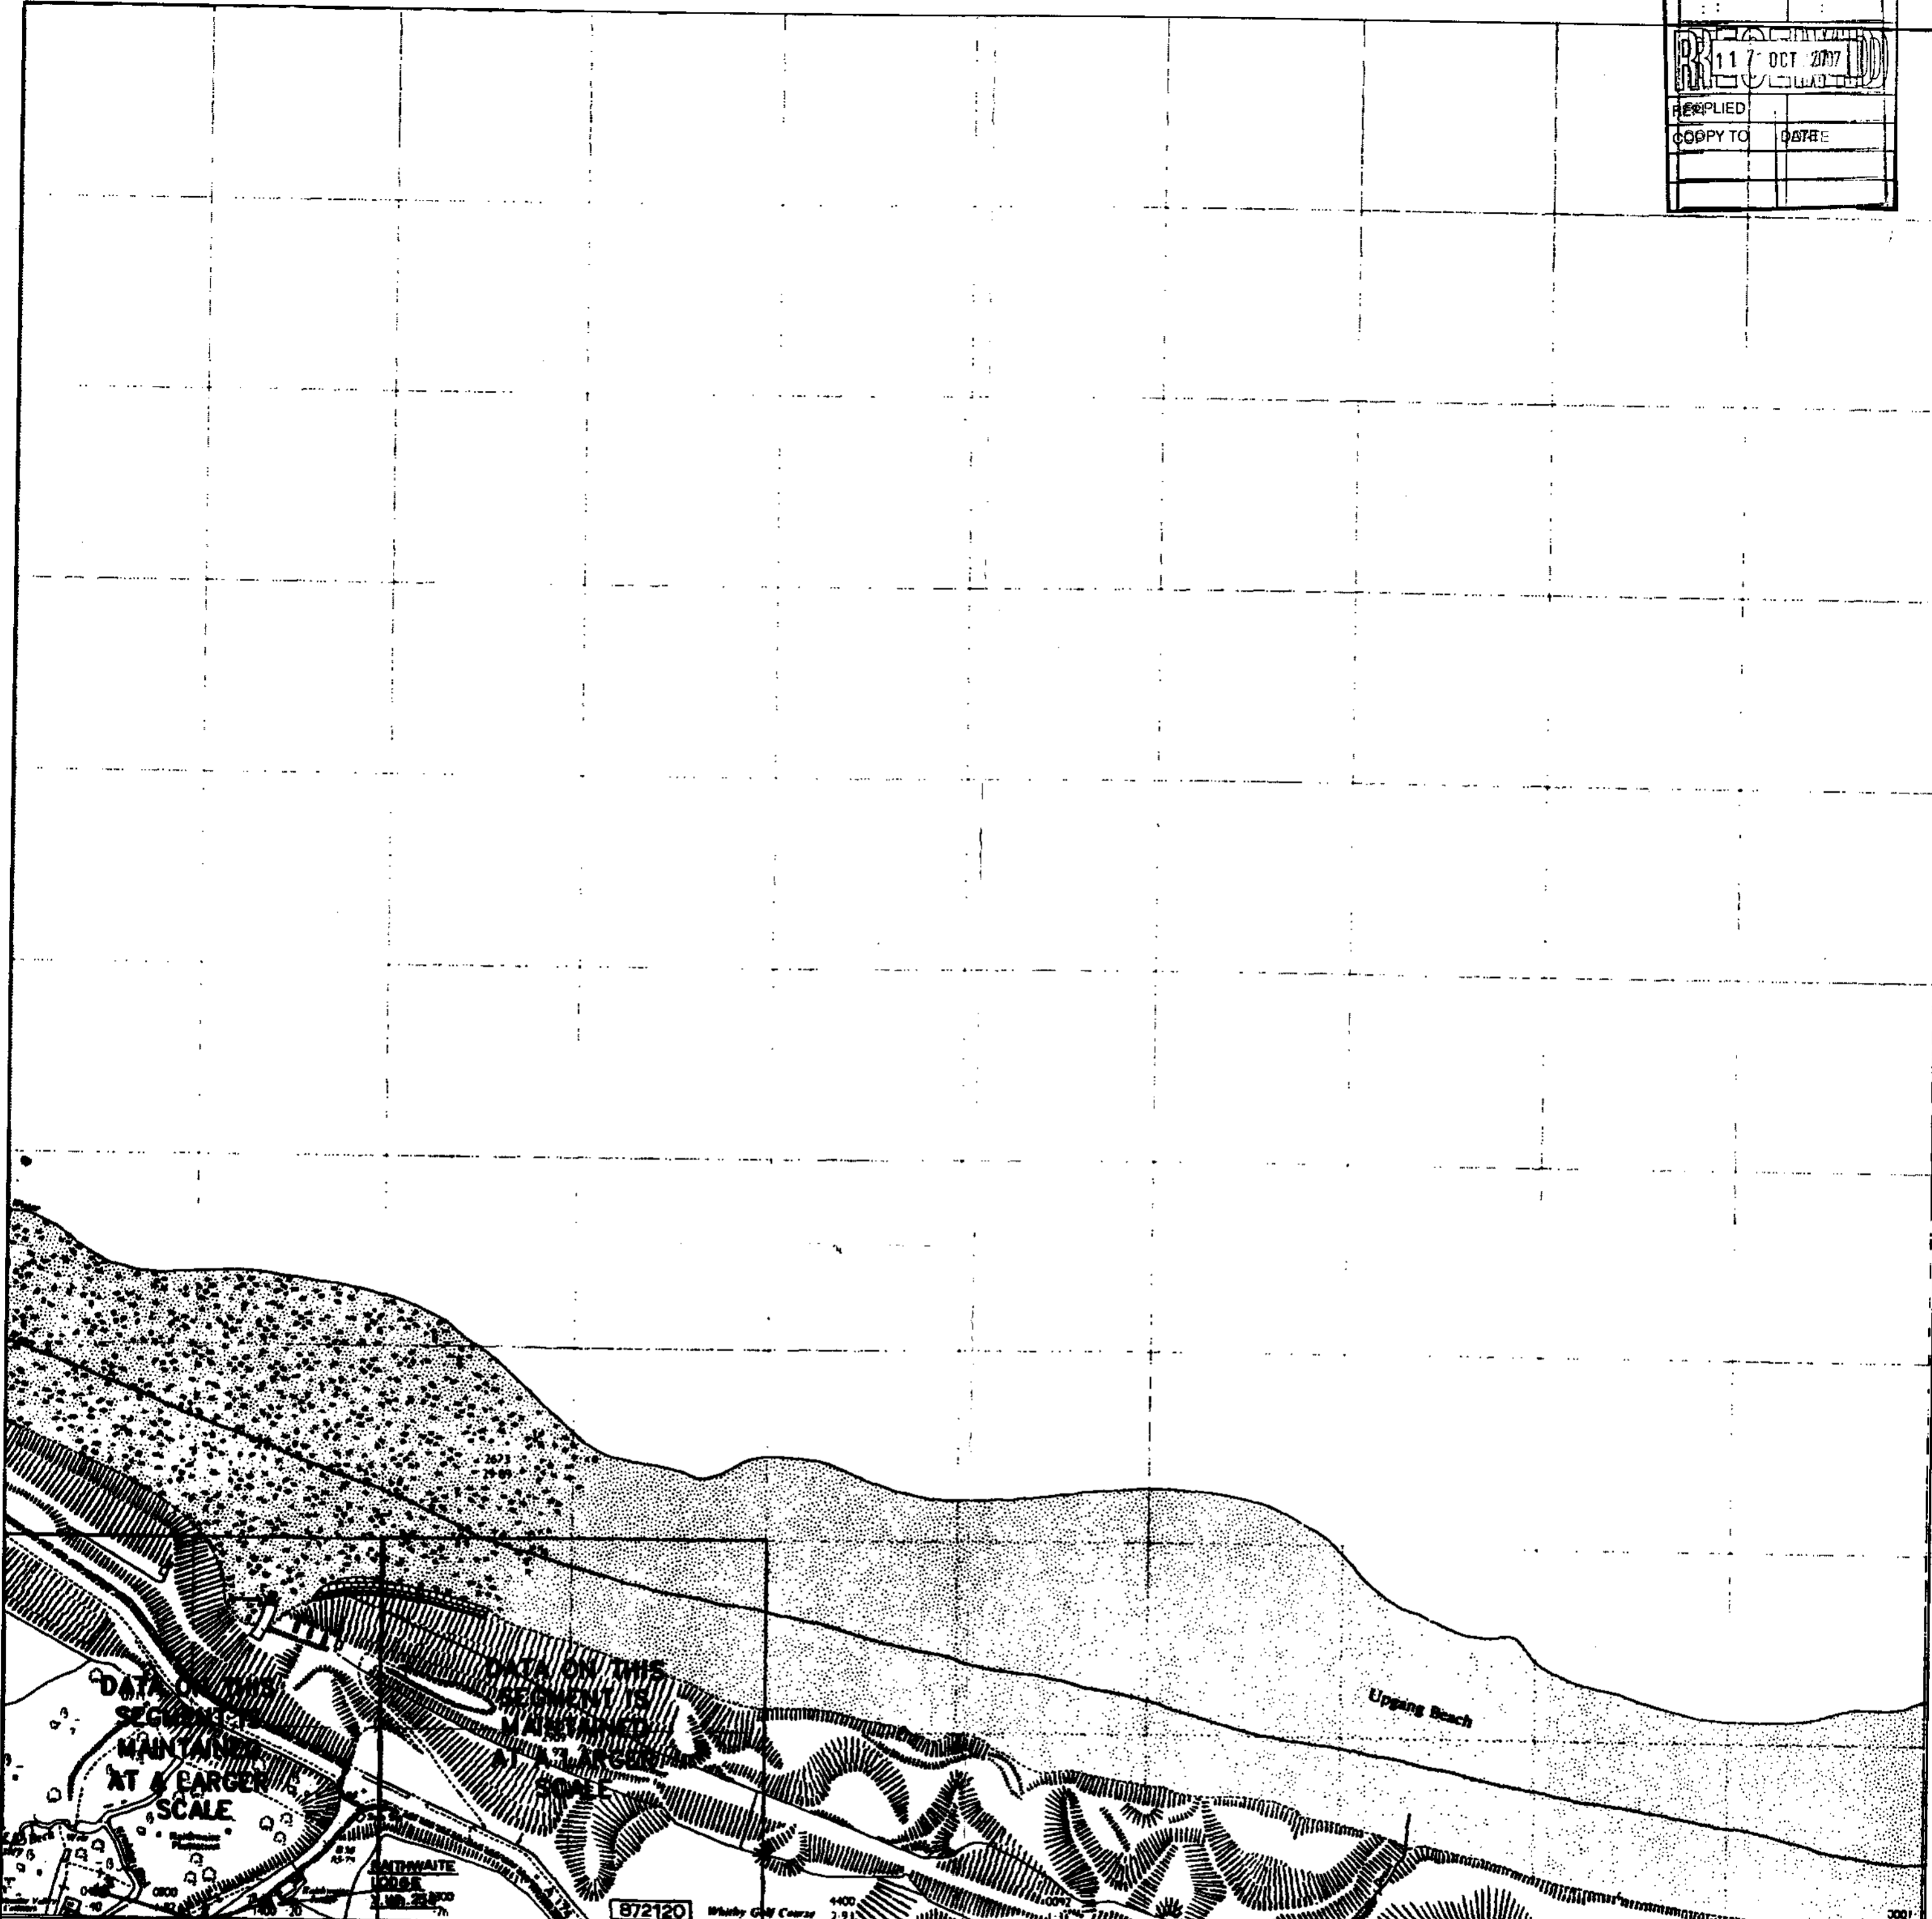

Scale: 1:2500
 Map: NZ8712:TIF
 Date: 16 Oct 2007

Dig Safety

1. Use Plans
2. Use Cable Locator
3. Hand Dig To Confirm

Based upon or Reproduced from the Ordnance Survey Map with the sanction of HM Stationery Office. CROWN COPYRIGHT RESERVED. Unauthorised reproduction infringes Crown Copyright. NEDL, Loyds Court, 78, Gray Street, Newcastle Upon Tyne, NE1 6AF

ELECTRIC CABLES AND/OR OVERHEAD LINE INFORMATION SHOWN ON THE RECORD PLANS ARE TO BE USED IN ACCORDANCE WITH THE HEALTH & SAFETY EXECUTIVE'S BOOKLET HS(G)47, 'AVOIDING DANGER FROM UNDERGROUND SERVICES', AND GUIDANCE NOTE GS 6, 'AVOIDANCE OF DANGER FROM OVERHEAD ELECTRIC LINES'. THE RECORD PLANS DO NOT ALWAYS SHOW SERVICE CABLES FROM NEDL'S MAINS TO ADJOINING OR CROSS ROAD PROPERTIES. PLANS DO NOT SHOW LOCAL AUTHORITY OWNED PUBLIC LIGHTING OR SIGN CABLES. THE INFORMATION IS PROVIDED AS A SERVICE BY NEDL AND DOES NOT IMPART ANY LEGAL OBLIGATION ON THEIR PART. PERSONS USING IT ARE REMINDED OF THEIR RESPONSIBILITY TO EXECUTE WORKS SAFELY TO AVOID DAMAGING NEDL'S APPARATUS. FURTHER ADVICE OR ASSISTANCE IS AVAILABLE FROM THE RECORDS INFORMATION CENTRE ON 0870 1600910. IN AN EMERGENCY OR OUTSIDE NORMAL WORKING HOURS CONTACT OUR CUSTOMER INFORMATION CENTRE ON 0845 0702703. CABLE DEPTHS SHOWN WERE CORRECT AT THE TIME CABLES WERE LAID HOWEVER ALTERATIONS TO GROUND LEVELS OR CABLE DISPOSITION MAY HAVE TAKEN PLACE

NYMinrA
 27 OCT 2008