


PLEASE COMPLETE OVERLEAF


ADDITIONAL AMENDMENTS

- Amended layout of buildings/outside areas
- Additional background information
- Amended design
- Revised access arrangements
- Change of description of proposed development - as indicated on the previous page
- Change in site boundaries
- Other (as specified below)

NYMNDPA
15 NOV 2010

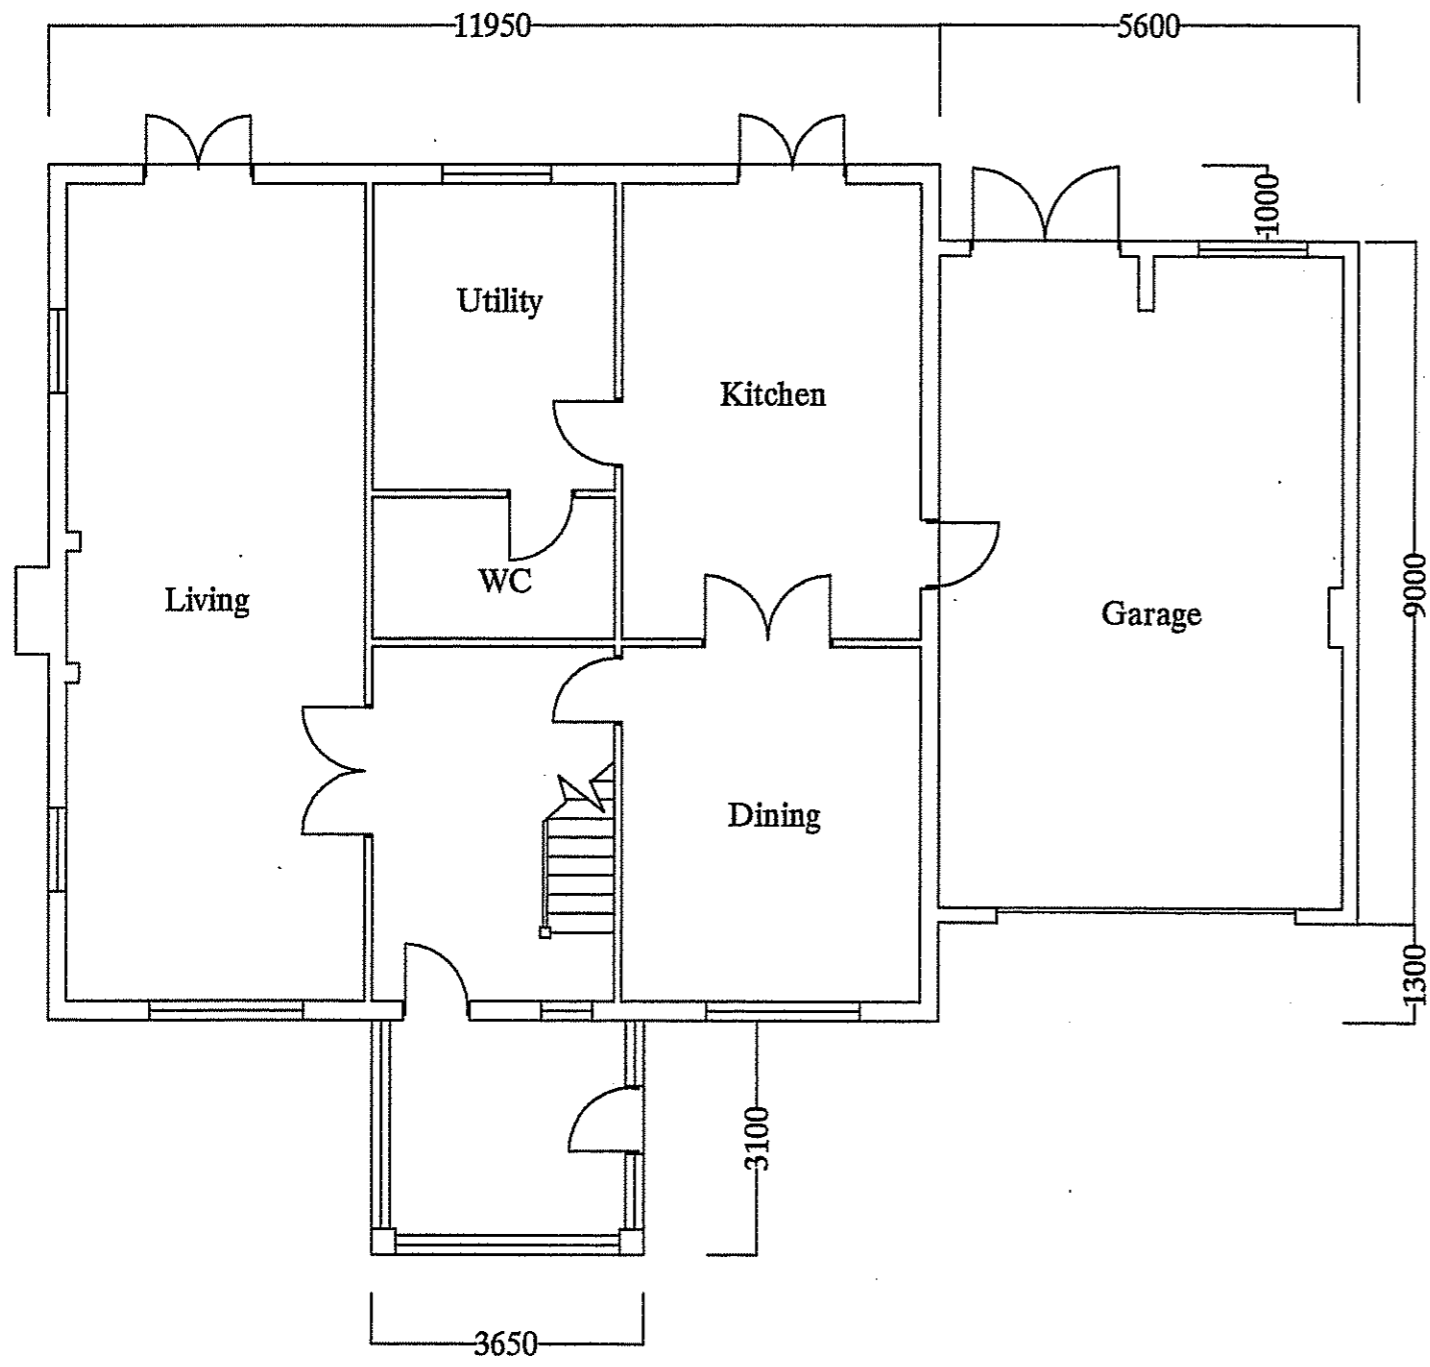

Ground Floor Layout

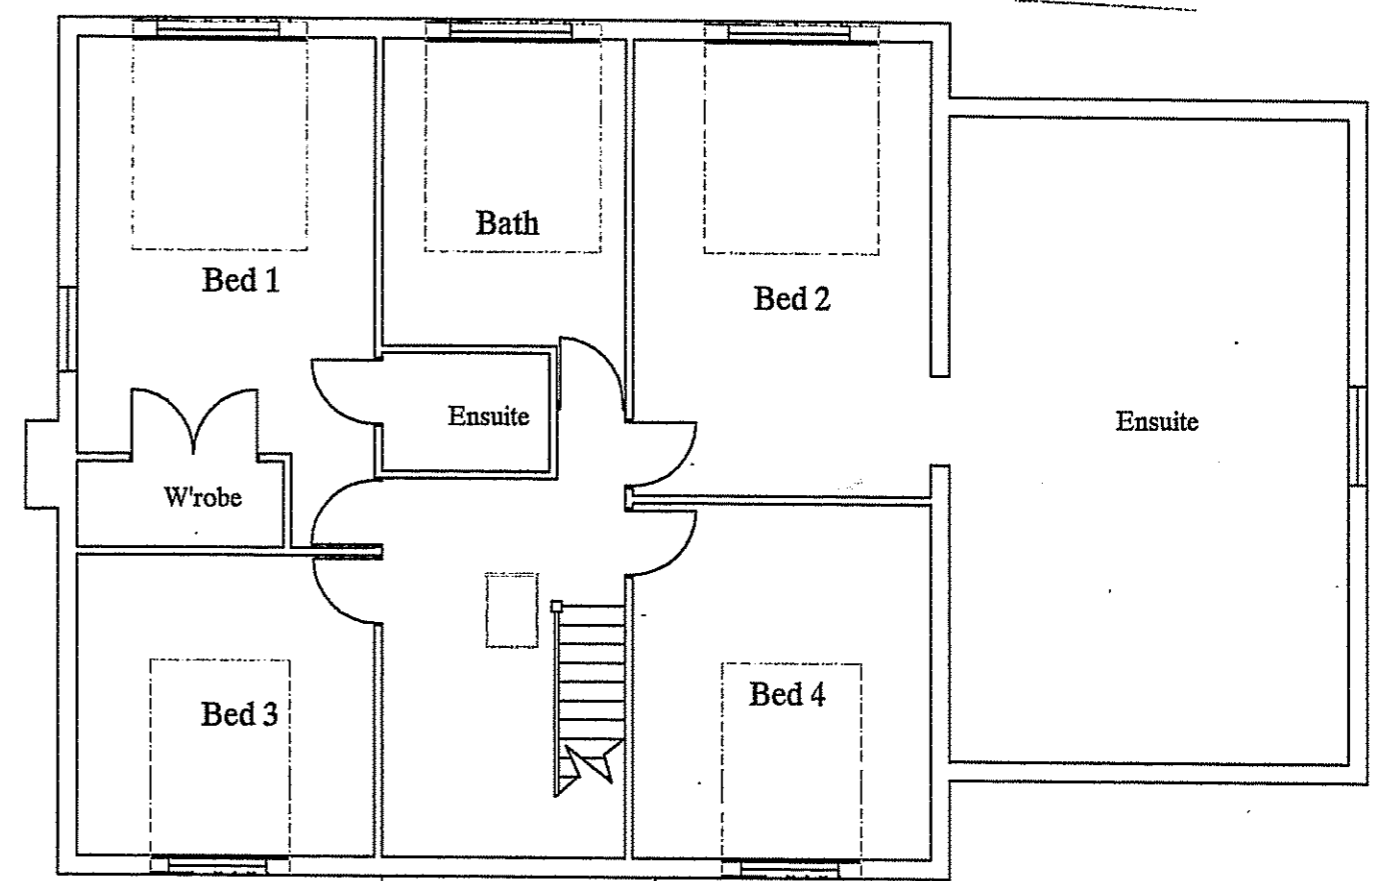


First Floor Layout

- REV N 10:10:10 Scheme amended to 'as built'
- REV M 01:08:10 Non-Material amendment
- REV L 01:03:10 Scheme amended as NYMNDPA letter 23:02:10
- REV K 05:02:10 Minor scheme rev as per JB/PM meeting 03:02:10
- REV J 28:01:10 Scheme amended to clients dwg
- REV H 18:01:10 Roof configuration altered
- REV G 16:12:09 Layout changed by client request
- REV F 18:10:09 Roof Pitch revised
- REV E 18:07:09 Roof / Conservatory revised
- REV D 10:07:09 General Revision
- REV C 09:07:09 General Revision
- REV B 24:05:09 Revised per NYMNDPA comments
- REV A 07:05:09 Revised per NYMNDPA comments


AMENDED

Notes

<p>Mr & Mrs Bingham 111 Hackness Road Scarborough North Yorkshire</p>	<p>Proposed Layout</p> <p>Scale: 1:100 Date: 03:04:09 Drawing no: THREE</p> <p style="font-size: 0.8em;">Do Not Scale From Drawing</p>
---	---

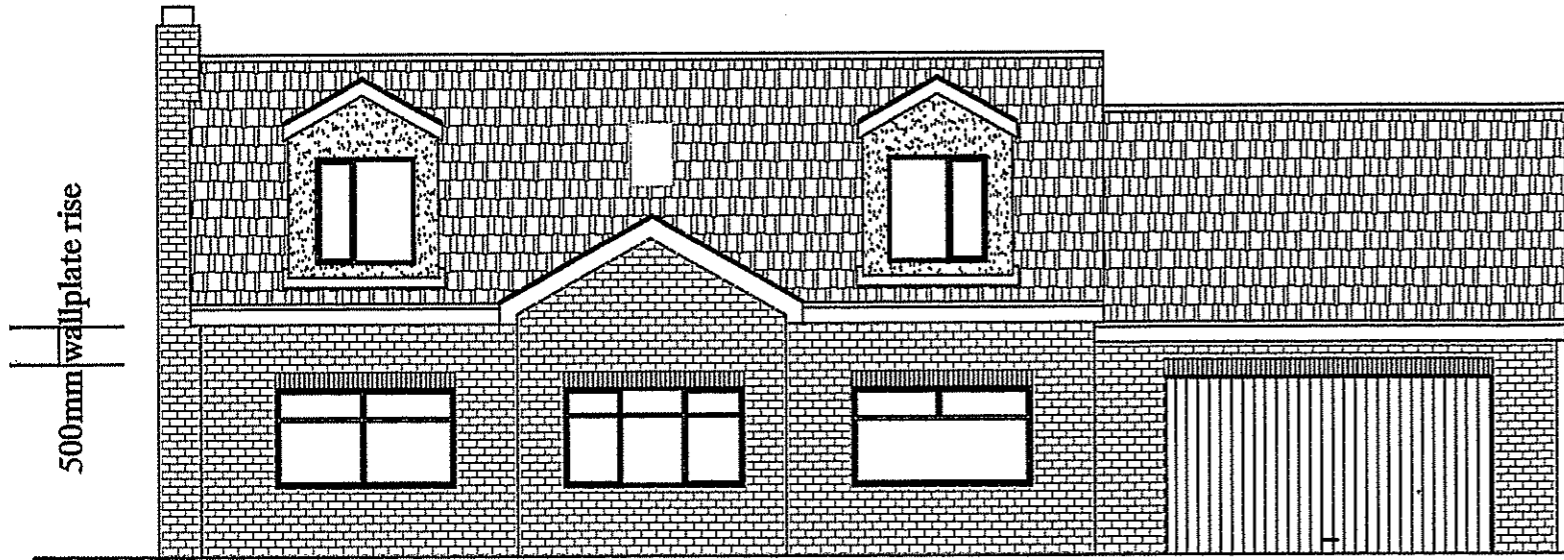

Front Elevation

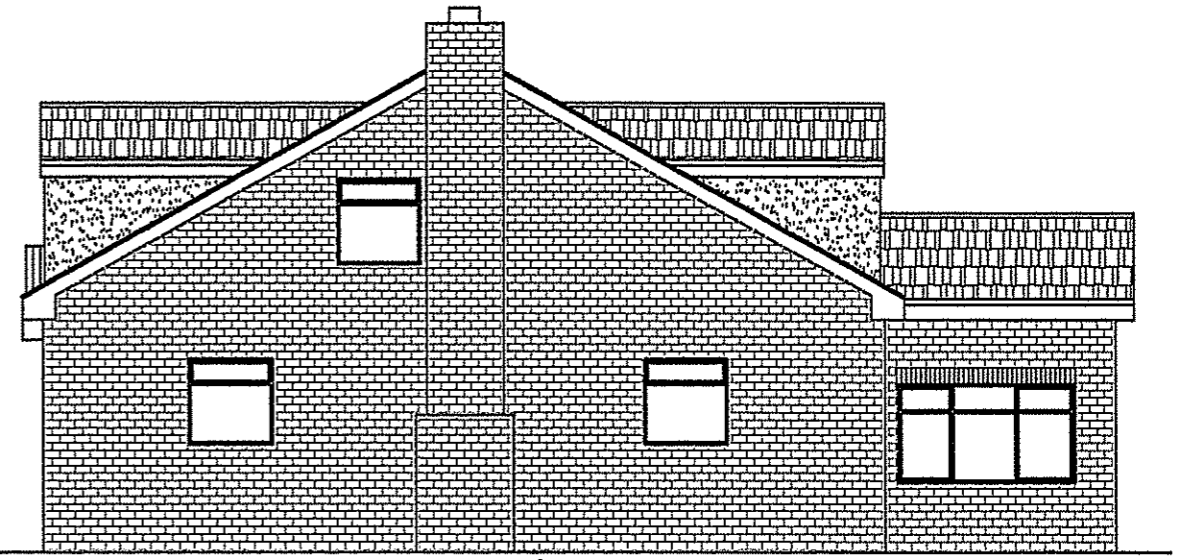


Side Elevation

NYMNP
15 NOV 2010



Rear Elevation

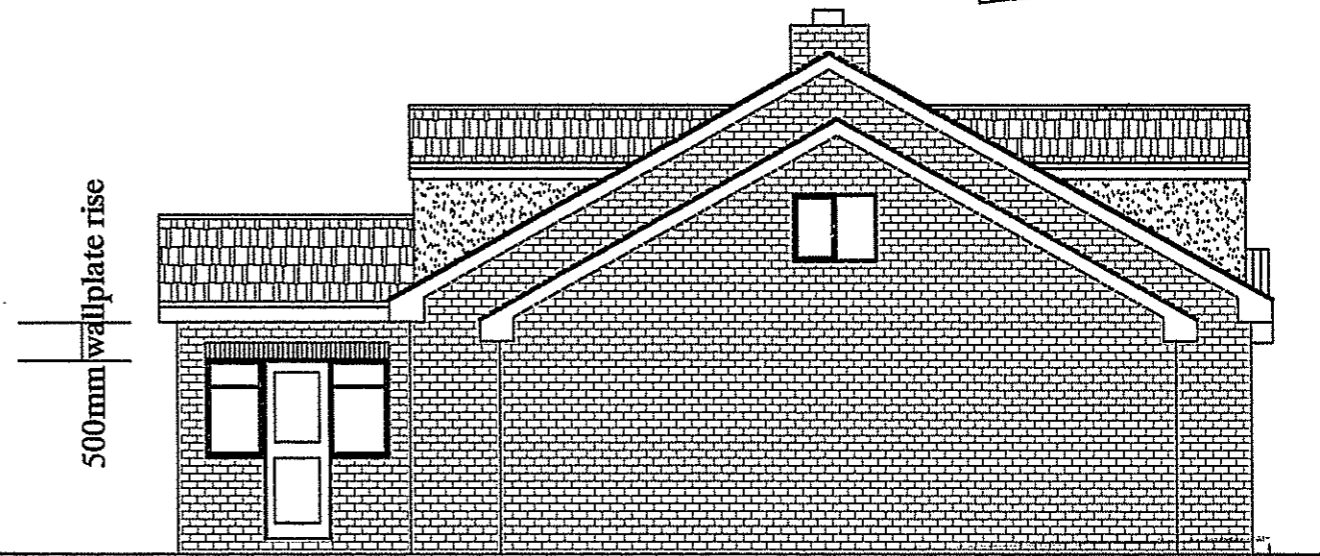

Side Elevation

Existing brick to be re-used
where possible.
extension

Roof to match existing
Upvc windows & doors

- REV N 10:10:10 Scheme amended to 'as built'
- REV M 01:08:10 Non-Material amendment
- REV L 24:06:10 Balcony Revised as Mr Bingham/Mrs Saunders Discussion
- REV K 01:03:10 Scheme amended as NYMNP letter 23:02:10
- REV J 05:02:10 Minor scheme rev as per JB/PM meeting 03:02:10

- REV H 28:01:10 Scheme amended to clients dwg
- REV G 18:01:10 Roof configuration altered
- REV F 18:10:09 Roof Pitch revised
- REV E 18:07:09 Roof / Conservatory revised
- REV D 10:07:09 General Revision
- REV C 09:07:09 General Revision
- REV B 24:05:09 Revised per NYMNP comments
- REV A 07:05:09 Revised per NYMNP comments

AMENDED

Notes

Mr & Mrs Bingham 111 Hackness Road Scalby Scarborough North Yorkshire	Proposed Elevations Scale 1:100 Date: 04:04:09 Drawing no: FOUR Do Not Scale From Drawing
---	---