
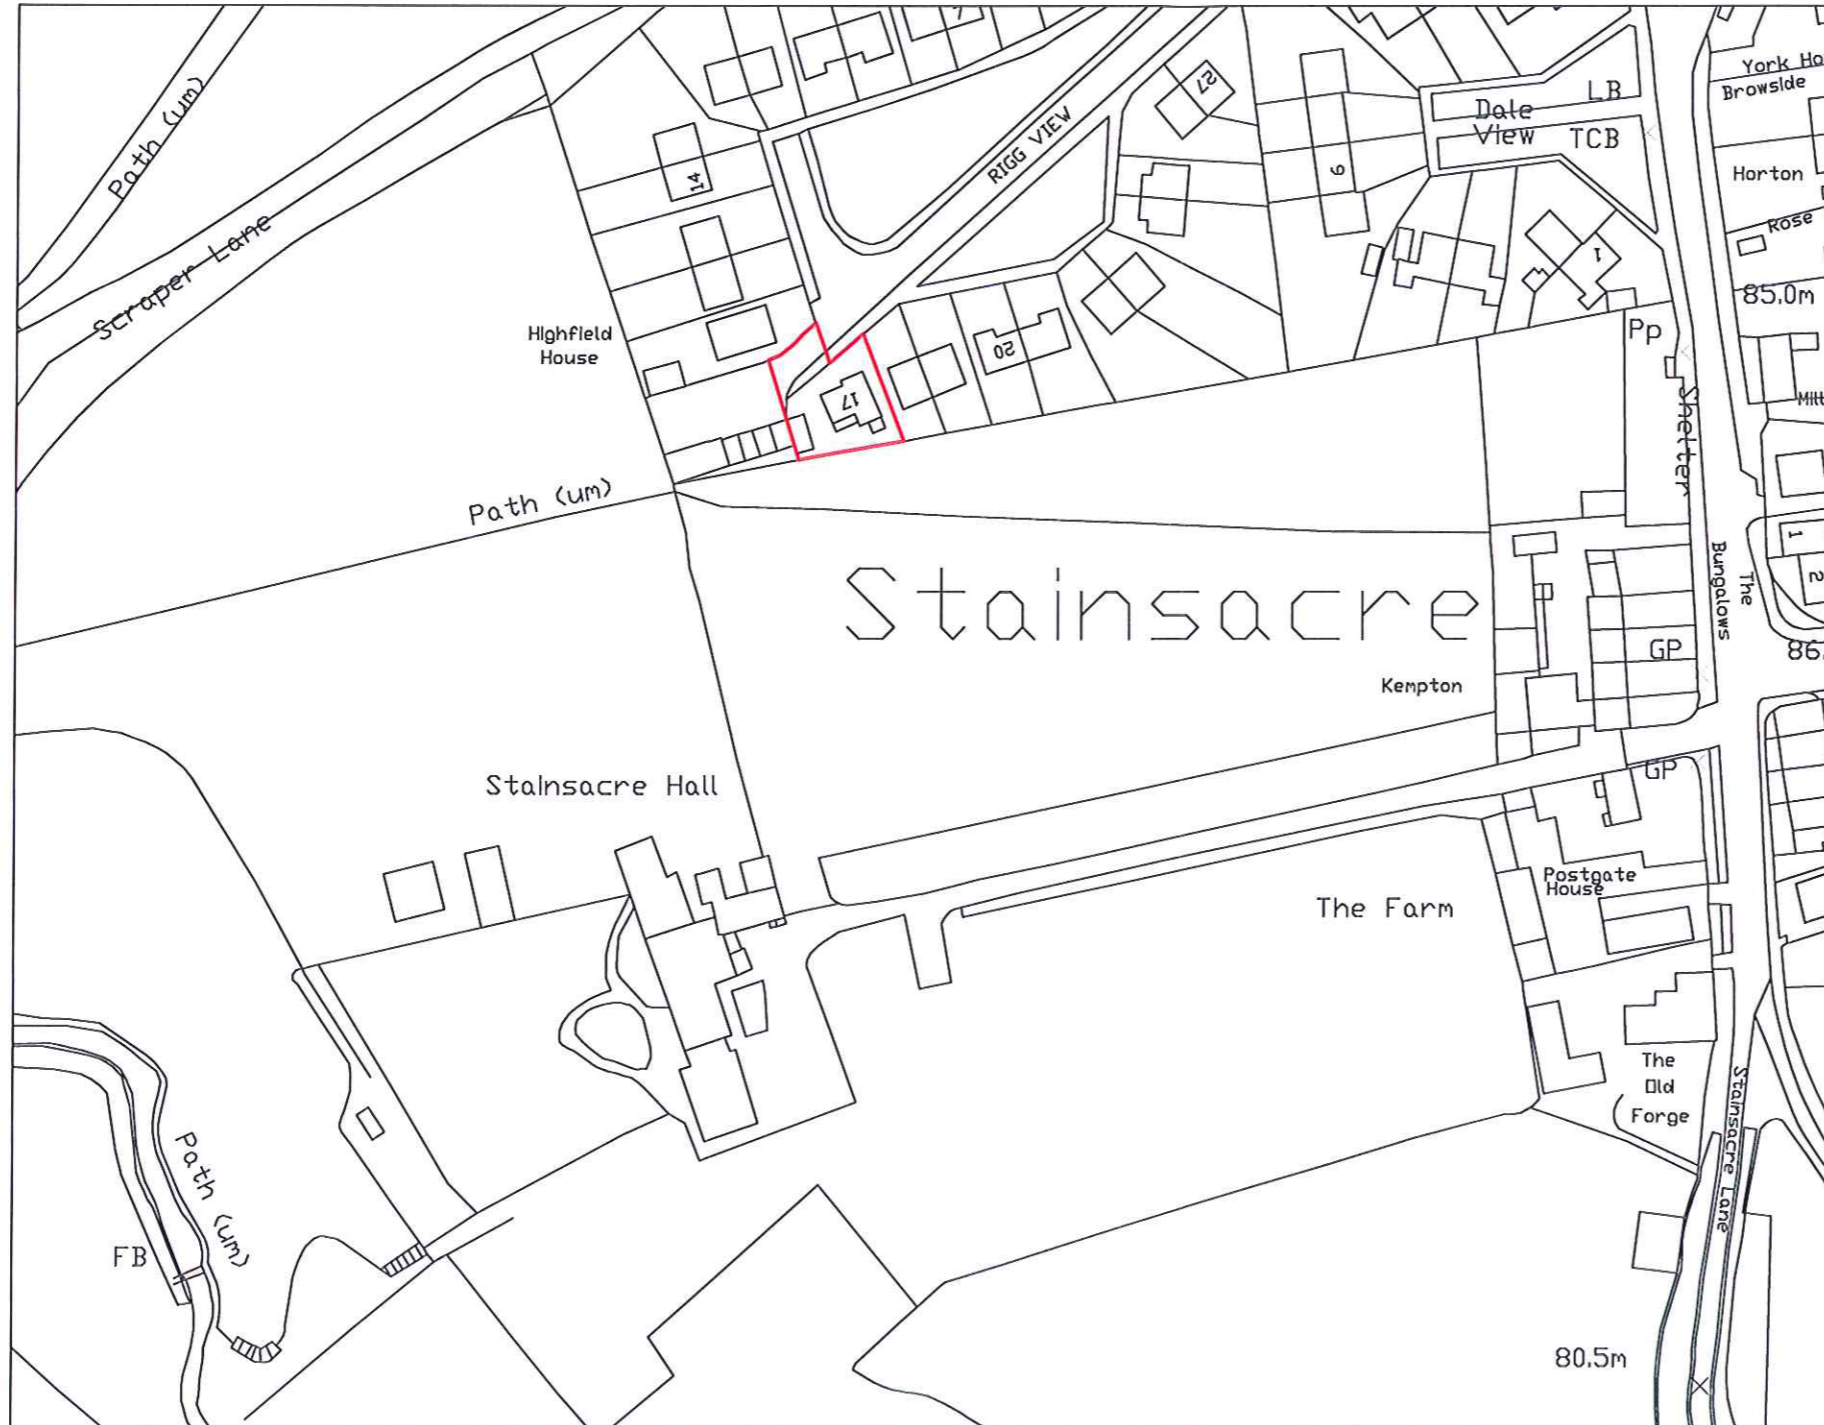


Amendments

- Amended layout of buildings/outside areas
- Additional background information
- Amended design
- Revised access arrangements
- Change of description of proposed development
- Change in site boundaries
- Other (as specified below)

AMENDED

Notes
Revised red line to show access to Highway.

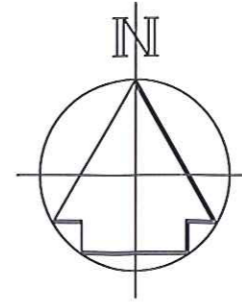

Notes

1.



Rev.	Description	Date	Chk.
A	Red line altered to NYMNP requirements	15.10.2012	LS

Bell Snoxell Building Consultants Ltd

Bell Snoxell Building Consultants Ltd
Barclays Bank House
Baxtergate
Whitby
North Yorkshire
YO21 1BW

Project: 17 Rigg View
Stainsacre
Whitby

Client: Mr and Mrs McConnell

Drawing: Location Plan

Date: July 2012 Scale@A3: 1:1250
Drawn By: LJS Check By: N/A Approved By: CI

Drawing Status: **Planning**
Job. no. Dwg. no. Rev.
1002 001 A

A01. These notes are intended to augment drawings and specifications. Where conflict of requirements exists the order of precedence shall be as shown in the specification. Otherwise the strictest provision shall govern.
A02. This drawing to be read in conjunction with all other relevant drawings.
A03. Drawings not to be scaled. All dimensions to be checked on site by the contractor. Any discrepancies to be notified to the surveyor and further instructions obtained before work is commenced.
No part of this drawing may be reproduced, stored in a retrieval system or transmitted in any form or by any means without prior permission in writing from Bell-Snoxell Associates Ltd.