


Amendments

- Amended layout of buildings/outside areas
- Additional background information
- Amended design
- Revised access arrangements
- Change of description of proposed development
- Change in site boundaries
- Other (as specified below)

✓ Amended Red Line

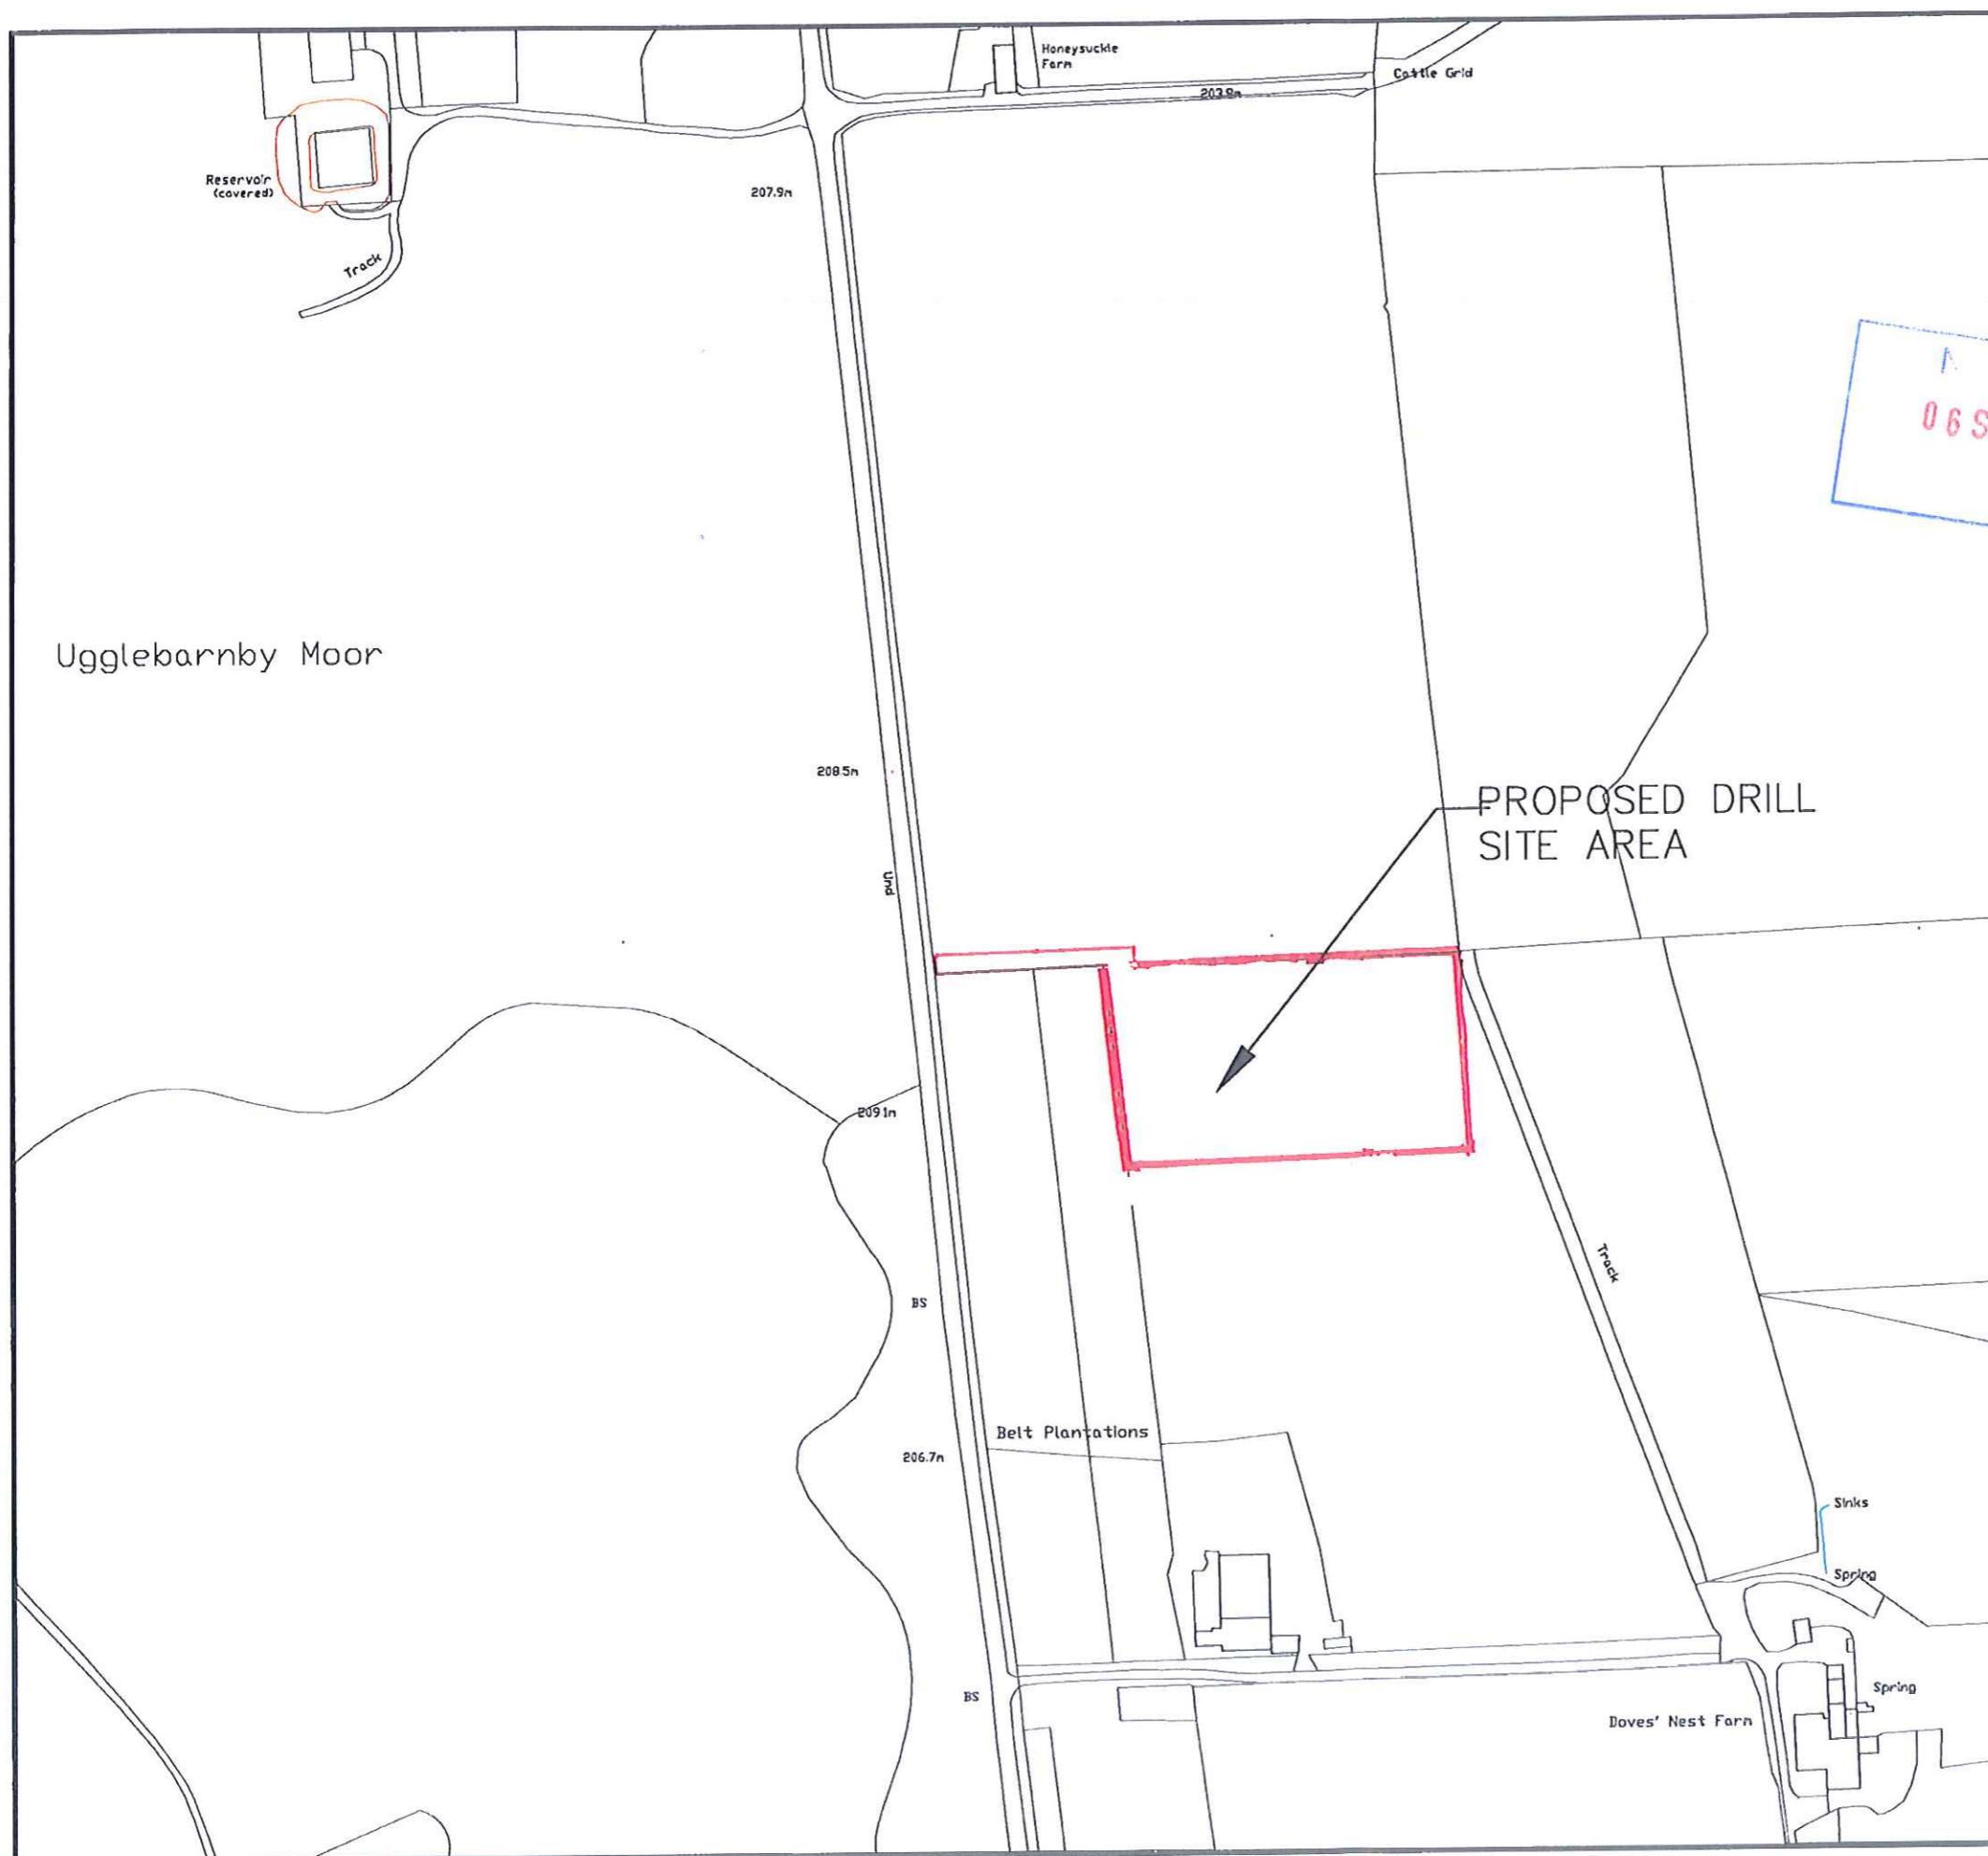

<p>NOTES</p> <p>Based on Ordnance Survey 1:2500 Land-Line map with the permission of the Controller of HMSO (C) Crown Copyright 2011. All rights reserved, licence number 0100031673.</p>		
<p>06 SEP 2012</p>		
<p>REVISIONS</p>		
<p>CLIENT</p> <p>YORKPOTASH A Sirius Minerals Project</p>		
<p>TITLE</p> <p>PROPOSED BOREHOLE SM11 LOCATION DOVE'S NEST SITE</p>		
<p>CONSULTANTS</p> <p>FWS CONSULTANTS LTD Geological</p> <p>Paul Evans Surveying Ltd Survey & CAD</p>		
<p>Date 06.09.12</p>	<p>Scale 1:2500 © A3</p>	<p>Plan No. DOVES NEST1 - A</p>