

NYM / 2013 / 0100011


X INDICATES AREA SITED WITHIN HOTEL GROUNDS.
SCALES ARE ATTACHED SEPARATELY.

AMENDED

Notes

Revised Red line.

Victoria Hotel
Station Road
Robin Hood's Bay
Whitby
YO22 4RL

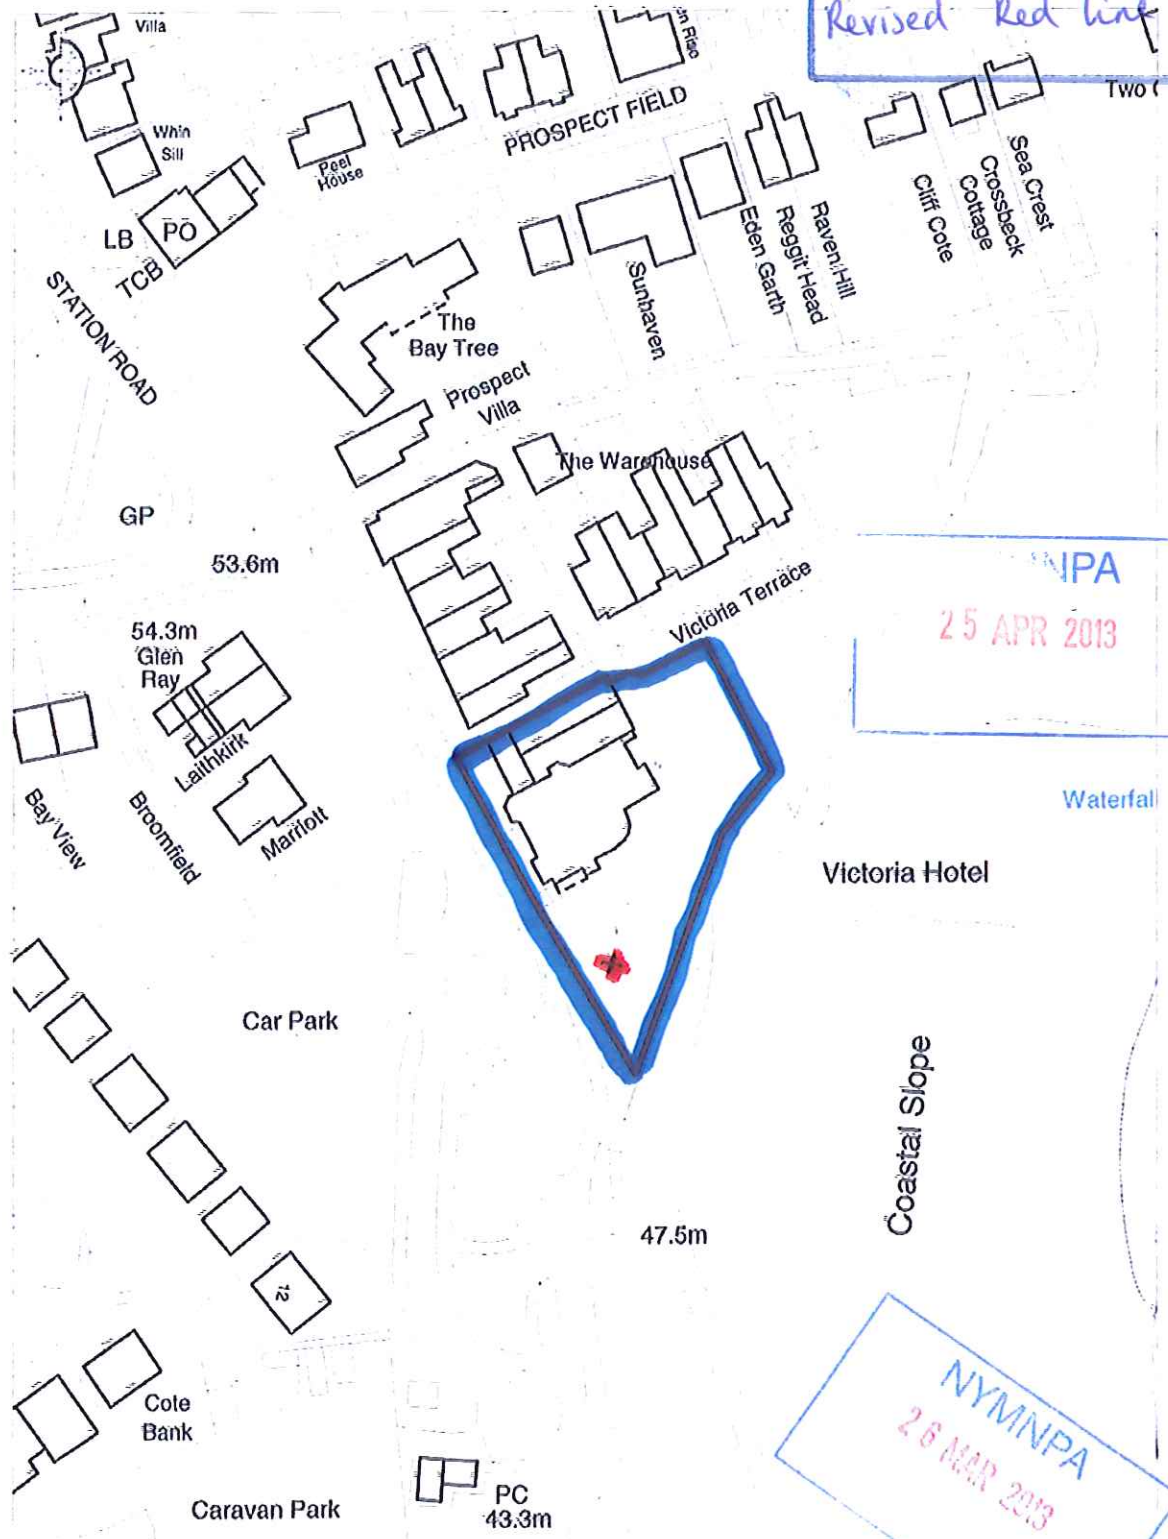

NPA
25 APR 2013

NYM/NPA
26 MAR 2013



© Promap Survey & Design 2013. All rights reserved.
Drawing number: 11005/010. Project Name: 110159