


TAKE OFF TILES
 PROVIDE FELT AND
 BATTENS AND RE TILE
 INSULATE

NEW
 WINDOW TO MATCH
 EXISTING KITCHEN
 WINDOW

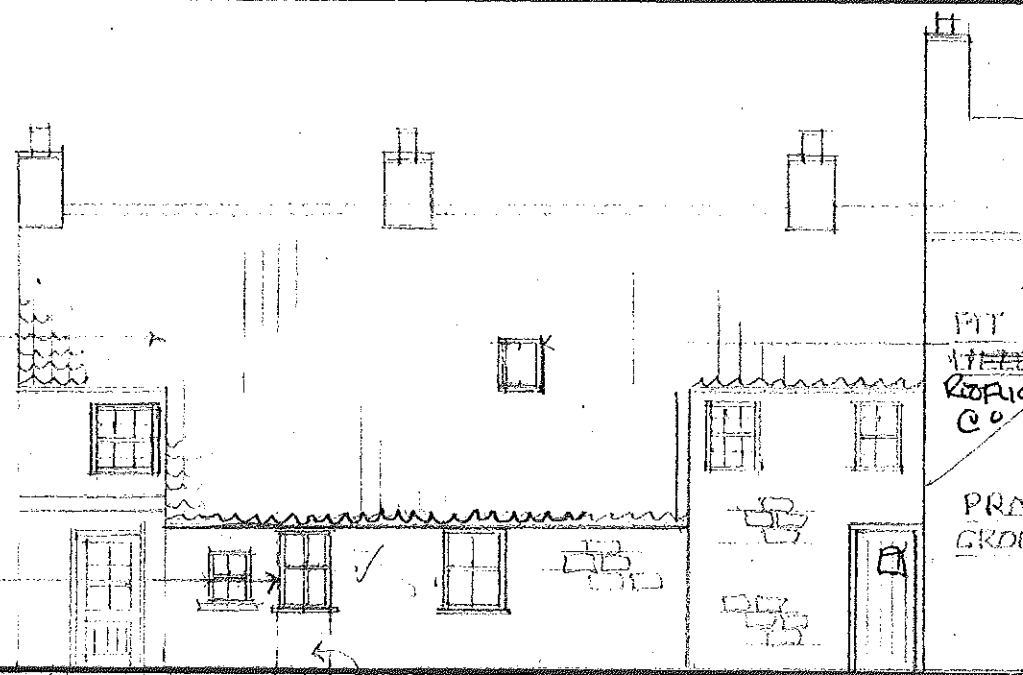


OLD DISPLAY
REAR ELEVATION

FIT 1 MP CONSERVATION
~~TYPE~~ ROOF LIGHT
~~CONCRETE~~ HOB CRI
 CO

PROVIDE DPC TO
 GROUND FLOOR WALLS

TAKE OFF TILES
 PROVIDE FELT AND BATTENS
 INSULATE
 RE TILE USING GREENWOOD
 PANTILES

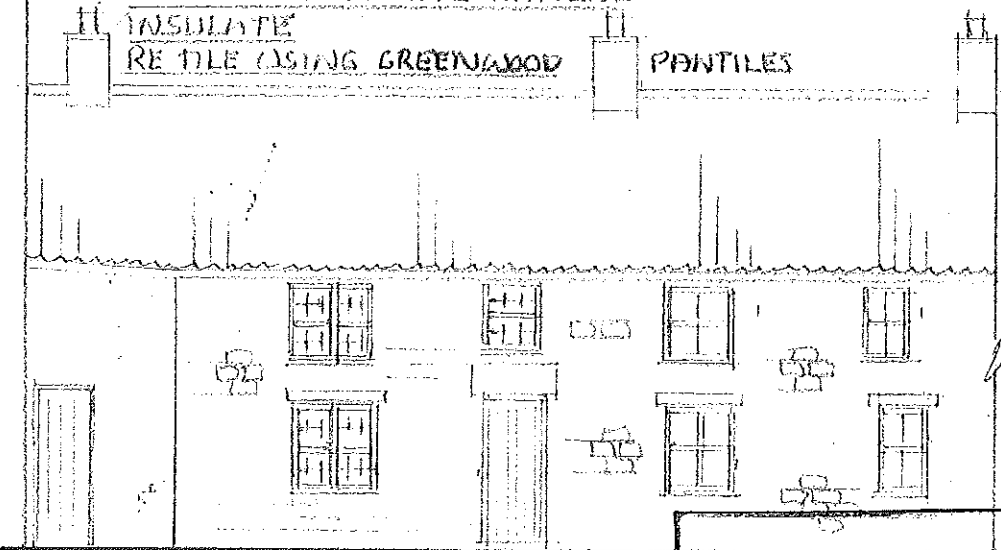


AMENDED


Notes

NEW CONCRETE FLOOR
 ON INSULATION AND
 1200g DISOLINE DPM

REMOVE WALLS

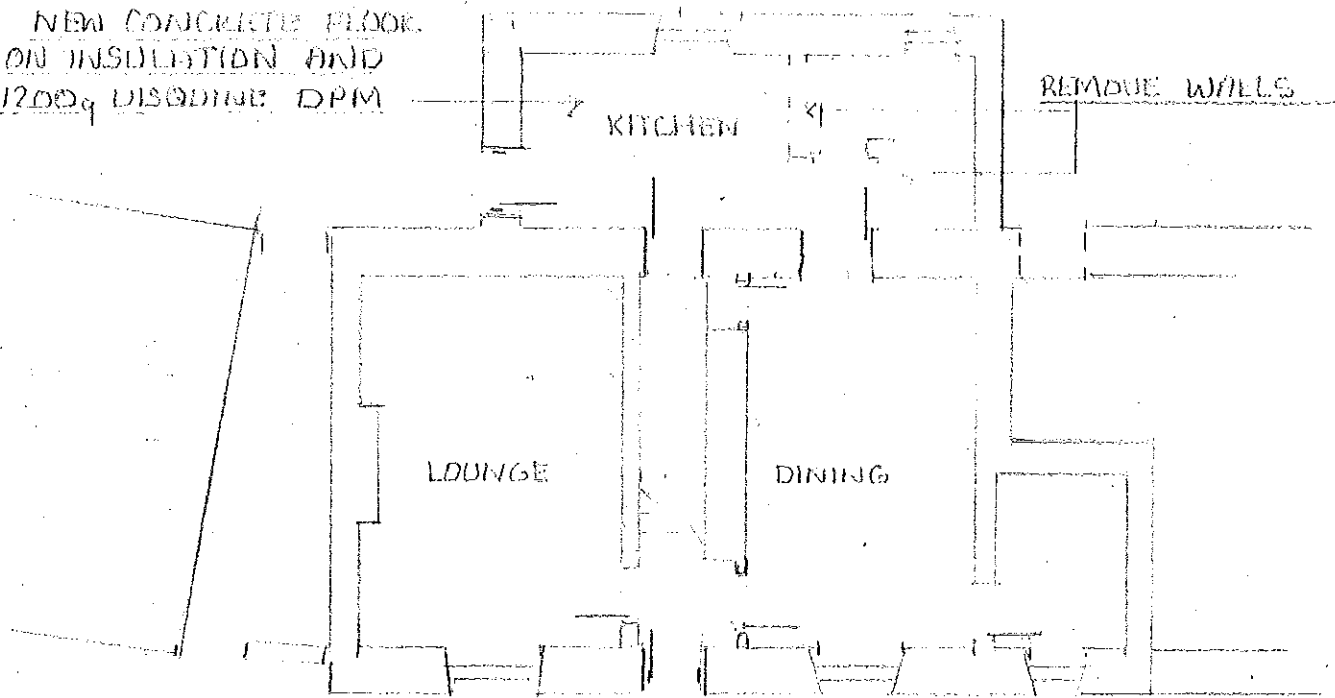

GROUND FLOOR

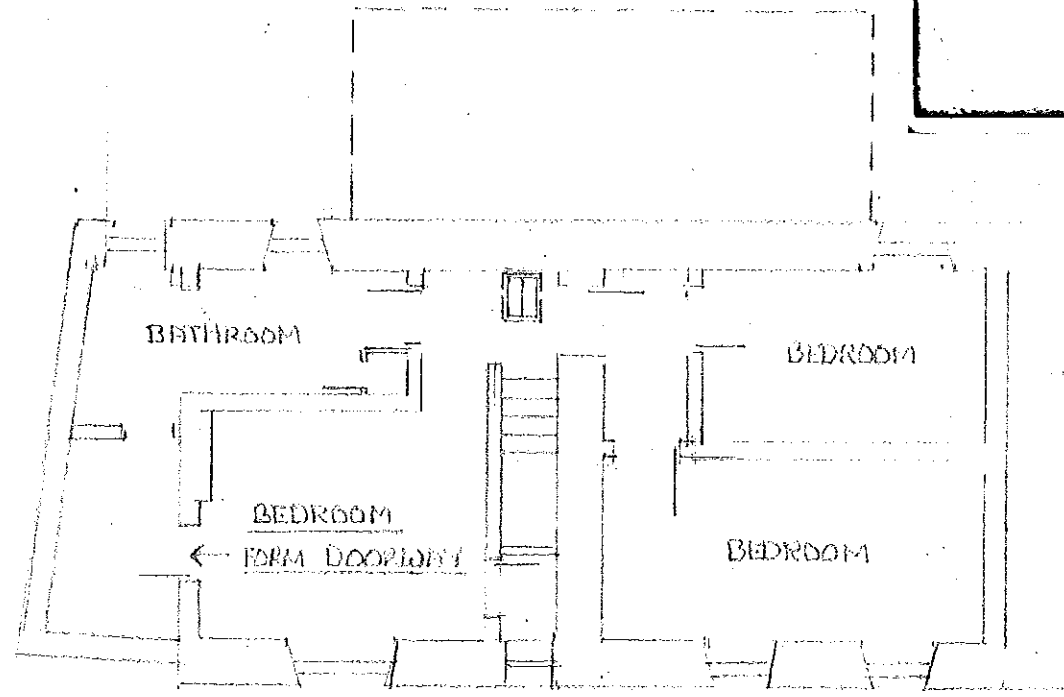

FIRST FLOOR

REVISED REAR WINDOW
 DETAILS DEC/13

PROPOSED ALTERATIONS TO
 THE FORGE EGTON
 FOR MR AND MRS GRAYSON
 SCALE 1:100
 LOCATION PLAN 1:1250
 PROPOSED PLANS AND ELEVATIONS
 TD/44/13