



DO NOT SCALE FROM THIS DRAWING.
ALL DIMENSIONS TO BE CHECKED ON SITE.
COPYRIGHT PROTECTED.

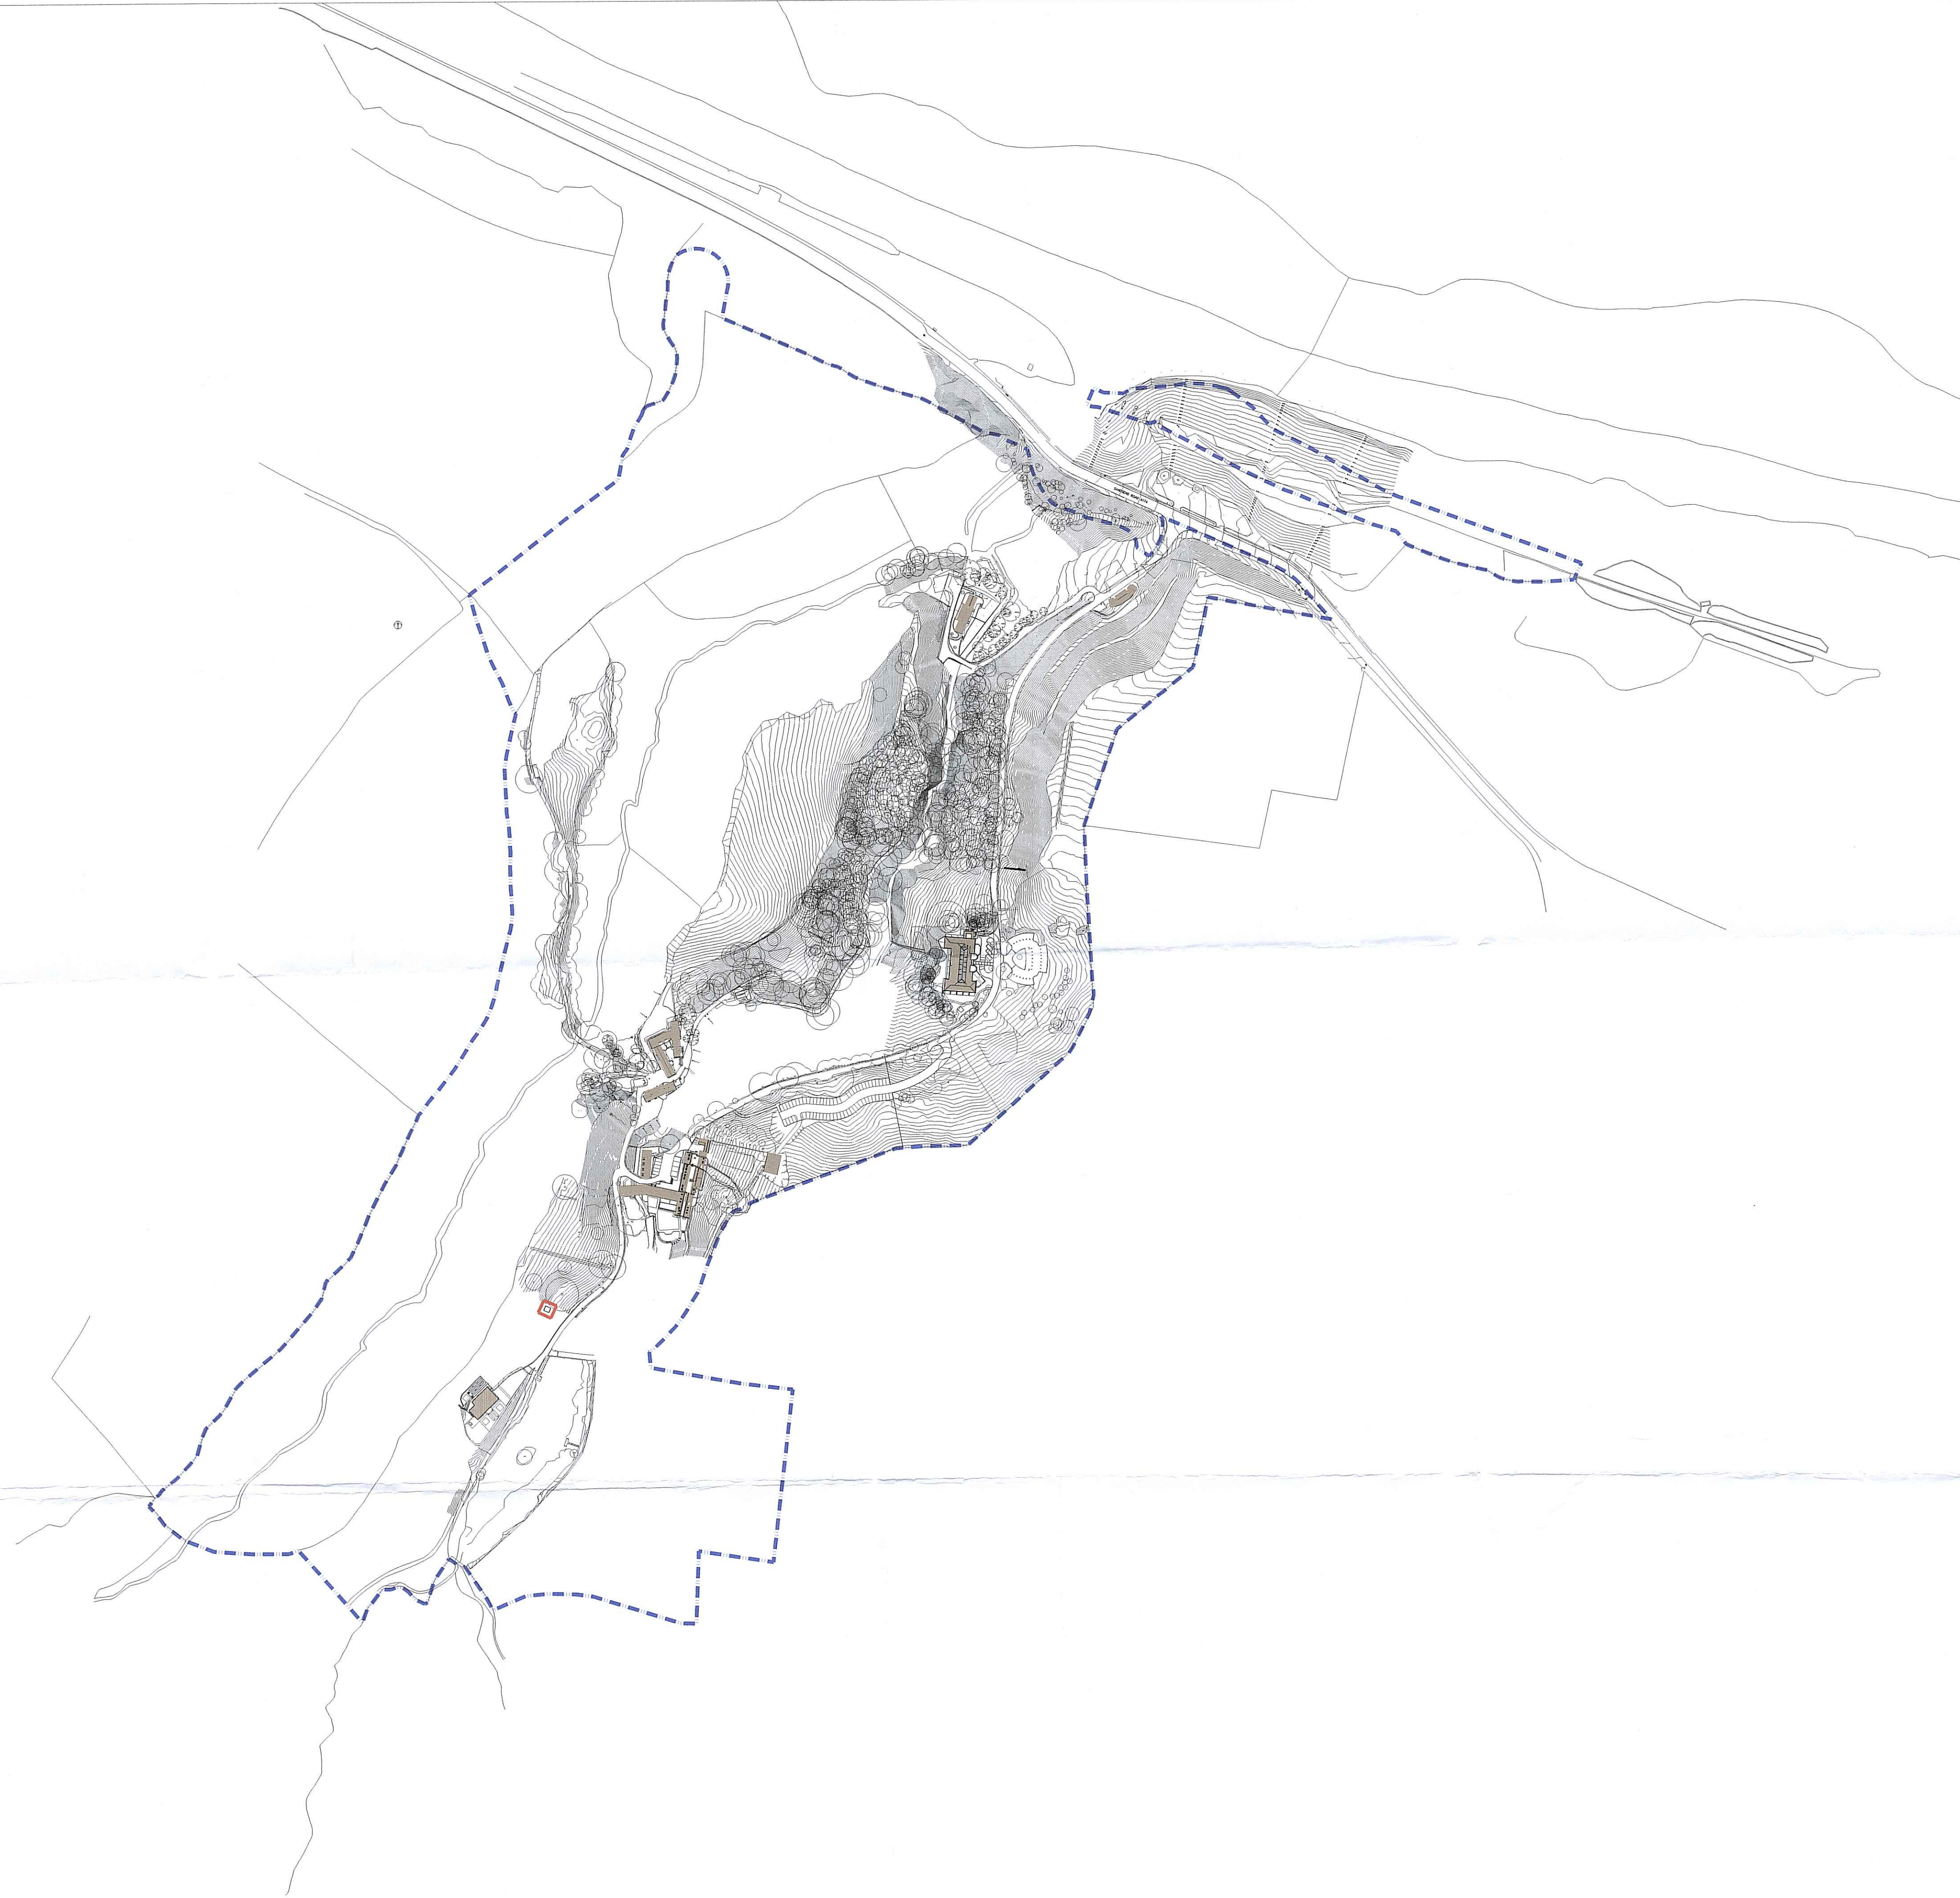

NYMMPA
18 MAR 2015


REV	DATE	DESCRIPTION	DRAWN	CHECKED
Skelwith Group 31 Bootham York YO30 7BT Tel:				
PROJECT				
Raitwaite Estate Alpaca Shed				
DRAWING				
Site Plan Existing				
CONSULTANT				
DRAWING No	SCALE	DATE	DRAWN	CHECKED
(02)100	1:2500@A1	30.09.14	RH	—
PROJECT No				REV
36026 ALPACA Shed				#

DO NOT SCALE FROM THIS DRAWING.
ALL DIMENSIONS TO BE CHECKED ON SITE.
COPYRIGHT PROTECTED.

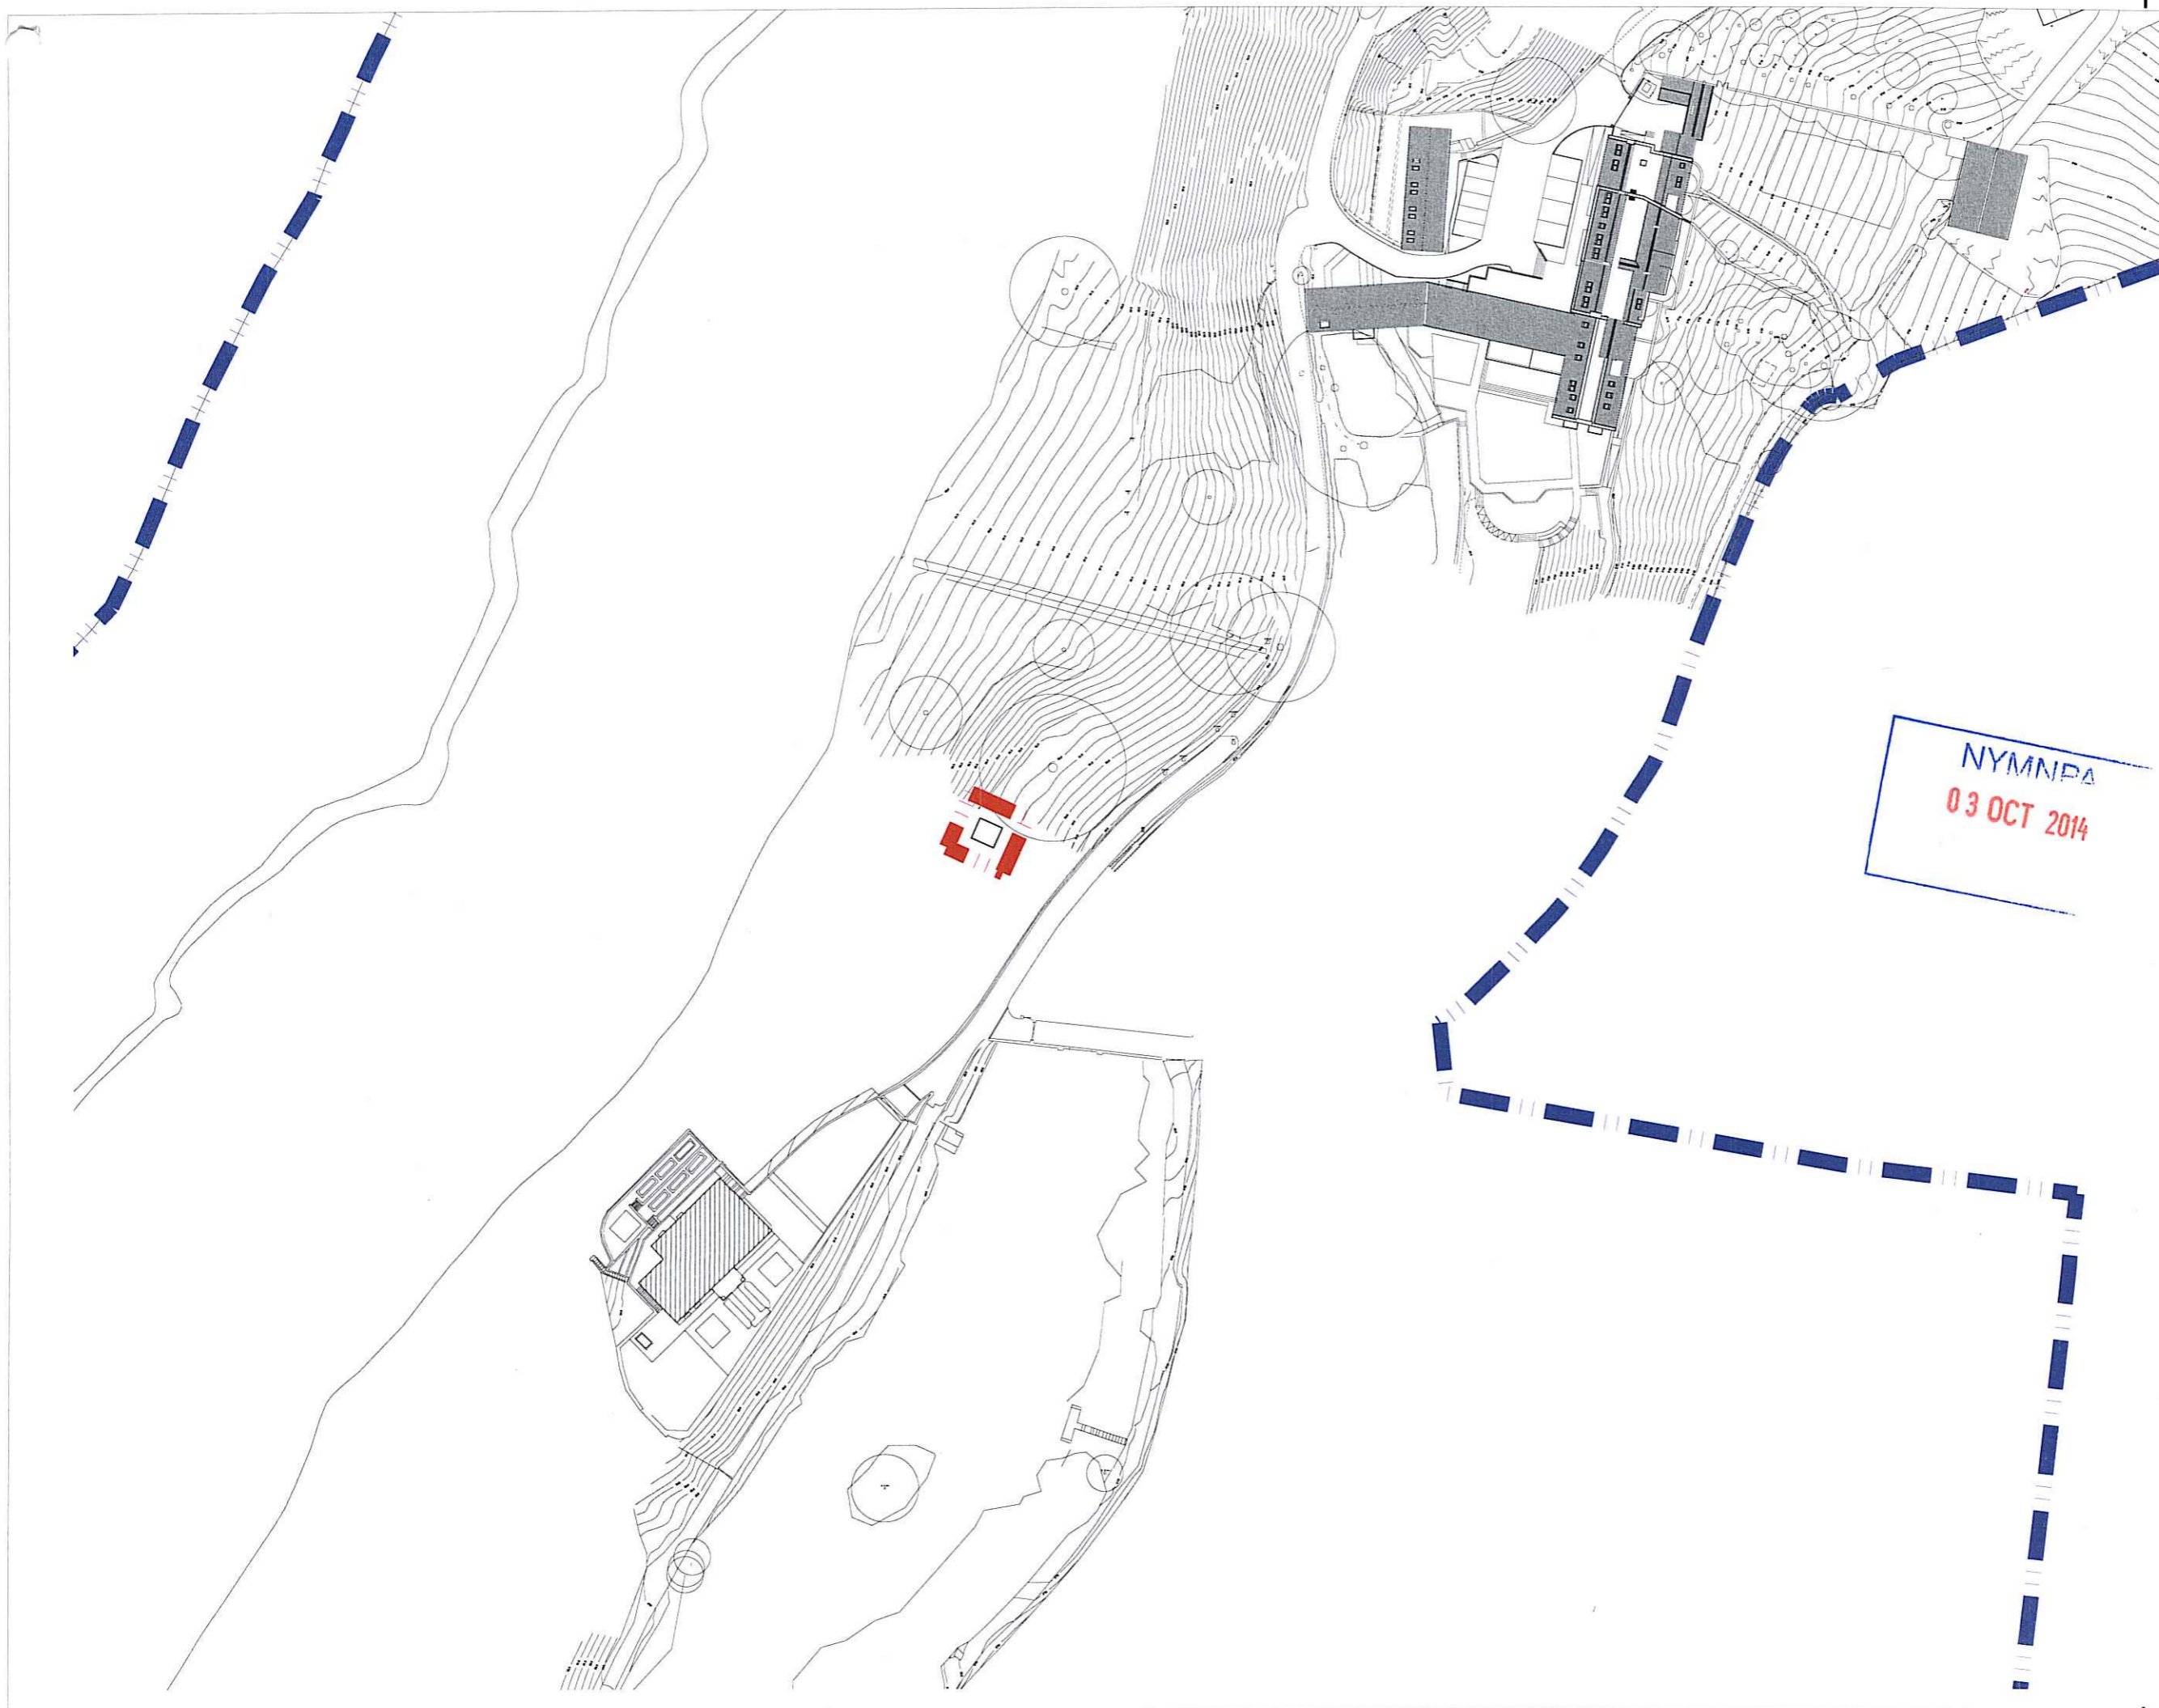

REV	DATE	DESCRIPTION	DRAWN	CHECKED
Skelwith Group 31 Bootham York YO30 7BT				
Tel:				
PROJECT				
Raitwaite Estate Alpaca Shed				
DRAWING				
Site Plan Existing				
CONSULTANT				
DRAWING No	SCALE	DATE	DRAWN	CHECKED
(02)101	1:1000@A3	30.09.14	RH	-
PROJECT No				REV
36026 ALPACA Shed				#

NYMNP
 03 OCT 2014

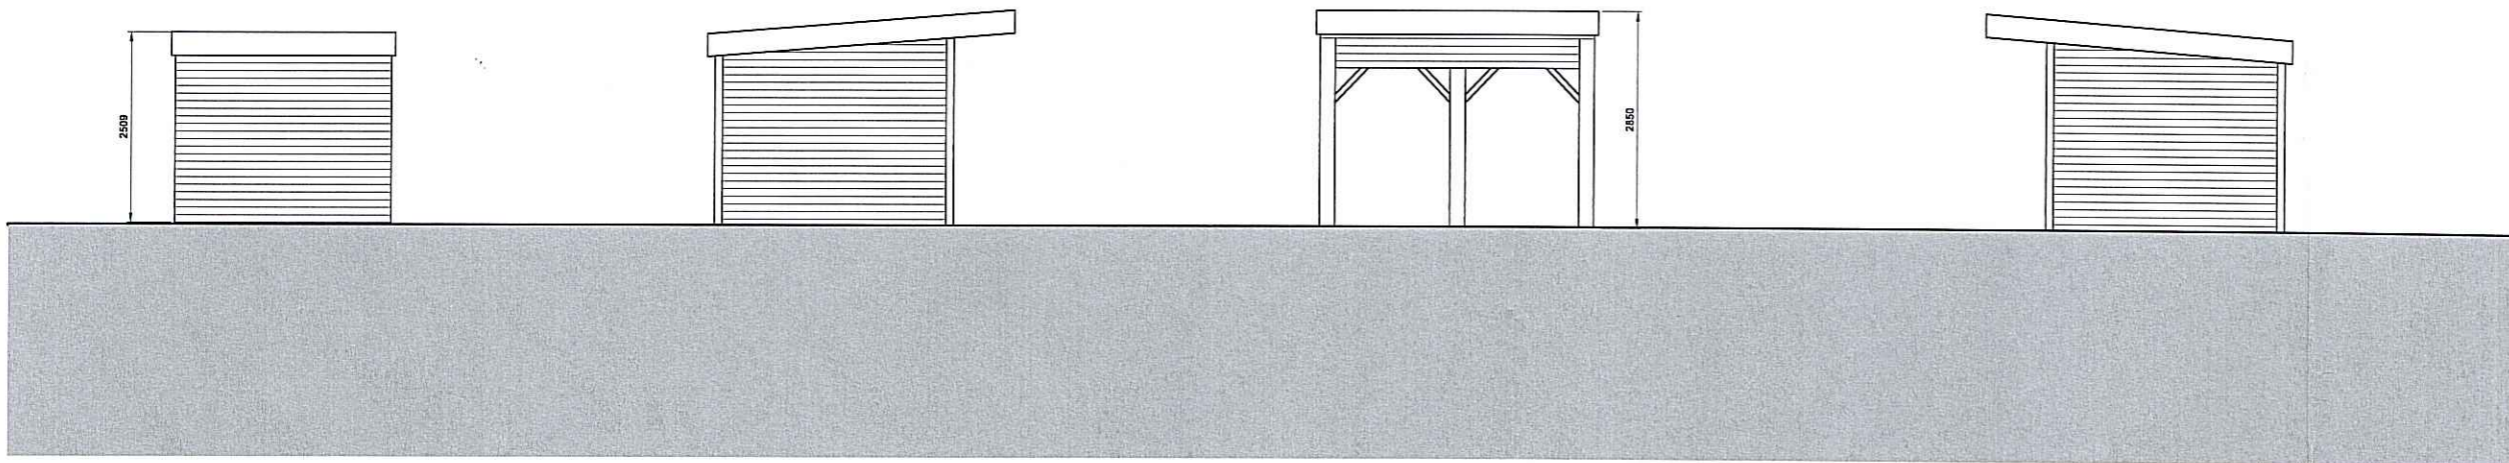


Rear Elevation


Side Elevation

Front Elevation

Side Elevation

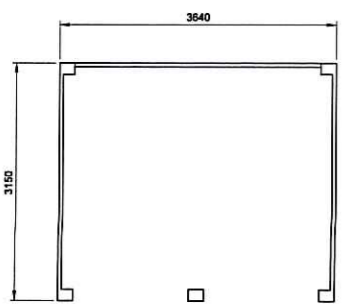


Floor Plan

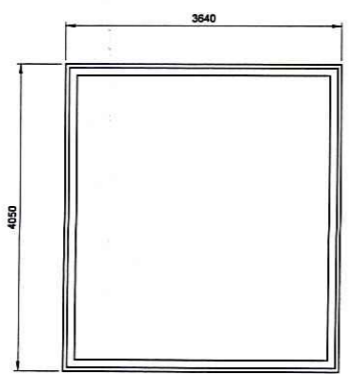

Roof Plan



As built

REV	DATE	DESCRIPTION	DRAWN	CHECKED
		 Skelwith Group 31 Bootham York YO30 7BT Tel:		
PROJECT			Raithwaite Estate Alpaca Shed	
DRAWING		Elevations and Plan Proposed		
CONSULTANT				
Drawing No	SCALE	DATE	DRAWN	CHECKED
(02)001	1:50@A3	30.09.14	RH	--
PROJECT No				REV
36026 ALPACA Shed				#