

Wendy Strangeway

From: Simpson, David
Sent: 14 July 2015 12:00
To: Wendy Strangeway
Subject: RE: NYM/2015/0381/NEW
Attachments: Ellerbeck South Bridge photos.docx; ELLERBECK Tender Ellerbeck South TENDER 04.06.2015.pdf

Dear Wendy

I have been informed by Historic England that Ellerbeck South Bridge is a grade II listed structure which is an oversight in our records and we will update them.

We are proposing to do repair works to Ellerbeck South Bridge at the same time as the works on Ellerbeck North Bridge and follow this morning telephone conversation with Beth Davies could we include the drawing for Ellerbeck South Bridge (see attached). Ellerbeck South Bridge is mentioned in the Heritage Statement /Design and Assess Statement for Ellerbeck North Bridge.

The red line on drawing B0545100/004/EB does cover both bridges. I also attached a few photos of Ellerbeck South Bridge.

If you require any further information please do not hesitate to contact me.

Kind regards

David



David Simpson | Jacobs | Engineer/Supervisor |
| Morgan House Mount View Standard Way Northallerton DL6 2YD |

AMENDED

Notes

From: Wendy Strangeway
Sent: 18 June 2015 09:34
To: Simpson, David
Subject: NYM/2015/0381/NEW

Dear Mr Simpson

Application for Listed Building consent for installation of masonry stitching anchors, proposed masonry repairs, cleaning and repointing, rebuilding of sections of bridge, replacement water spouts, installation of 2 no. gabion mattress and rebuilding of 2 no. brick gullies at Ellerbeck North Bridge, A169, Goathland

Thank you for your recent planning application concerning the above matter. I have completed a preliminary check of the documentation and plans which you have submitted and regret to inform you that the details do not meet the requirements of the Town and Country (Development Management Procedure) Order 2015. Before I can process your application further I will require the following:-

1. Please provide two copies of a Design and Access Statement. The design aspect should cover the issues of the building's context, amount of development, layout, scale and appearance. The access aspect should justify the position and form of access chosen. For small domestic developments this can simply relate to the building itself, but for larger developments this needs to take account of the wider public road network. Finally, if your site involves public access, your statement should state how

you have taken account of the Disability Discrimination Act. The attached guidance note sets out in detail what should be covered in each section.

- * If you are submitting the above requested documentation via the post two copies are required, however the Authority is happy to receive a single copy electronically.

I regret that I will not be able to progress your application until I am in receipt of the above. Please do not hesitate to contact me if there is any problem concerning the supply of the above information.

Yours sincerely



Mrs Wendy Strangeway
Planning Administration Officer

North York Moors National Park Authority
The Old Vicarage
Bondgate
Helmsley
YO62 5BP



CONFIDENTIALITY: The contents of this message are the views of the author, not necessarily the views of the North York Moors National Park Authority. This is a private message intended for the named addressee(s) only. Its contents may be confidential.

If you have received this message in error please reply to say so and then delete the message. Any use, copying, disclosure or distribution by anyone other than the addressee is forbidden.

www.northyorkmoors.org.uk

This email has been scanned for email related threats and delivered safely by Mimecast.
For more information please visit <http://www.mimecast.com>

NOTICE - This communication may contain confidential and privileged information that is for the sole use of the intended recipient. Any viewing, copying or distribution of, or reliance on this message by unintended recipients is strictly prohibited. If you have received this message in error, please notify us immediately by replying to the message and deleting it from your computer.

Ellerbeck South Bridge



NYM/NPA
14 JUL 2015



AMENDED

DED

Notes

NYMNP

14 JUL 2015



31/03/2015



31/03/2015

AMENDED



AMENDED

AMENDED

NYMIPA
14 JUL 2015

















AMENDED

Notes

AMENDED

31/03/2015

Drawing number / Rev
B0545100/002/EB/A

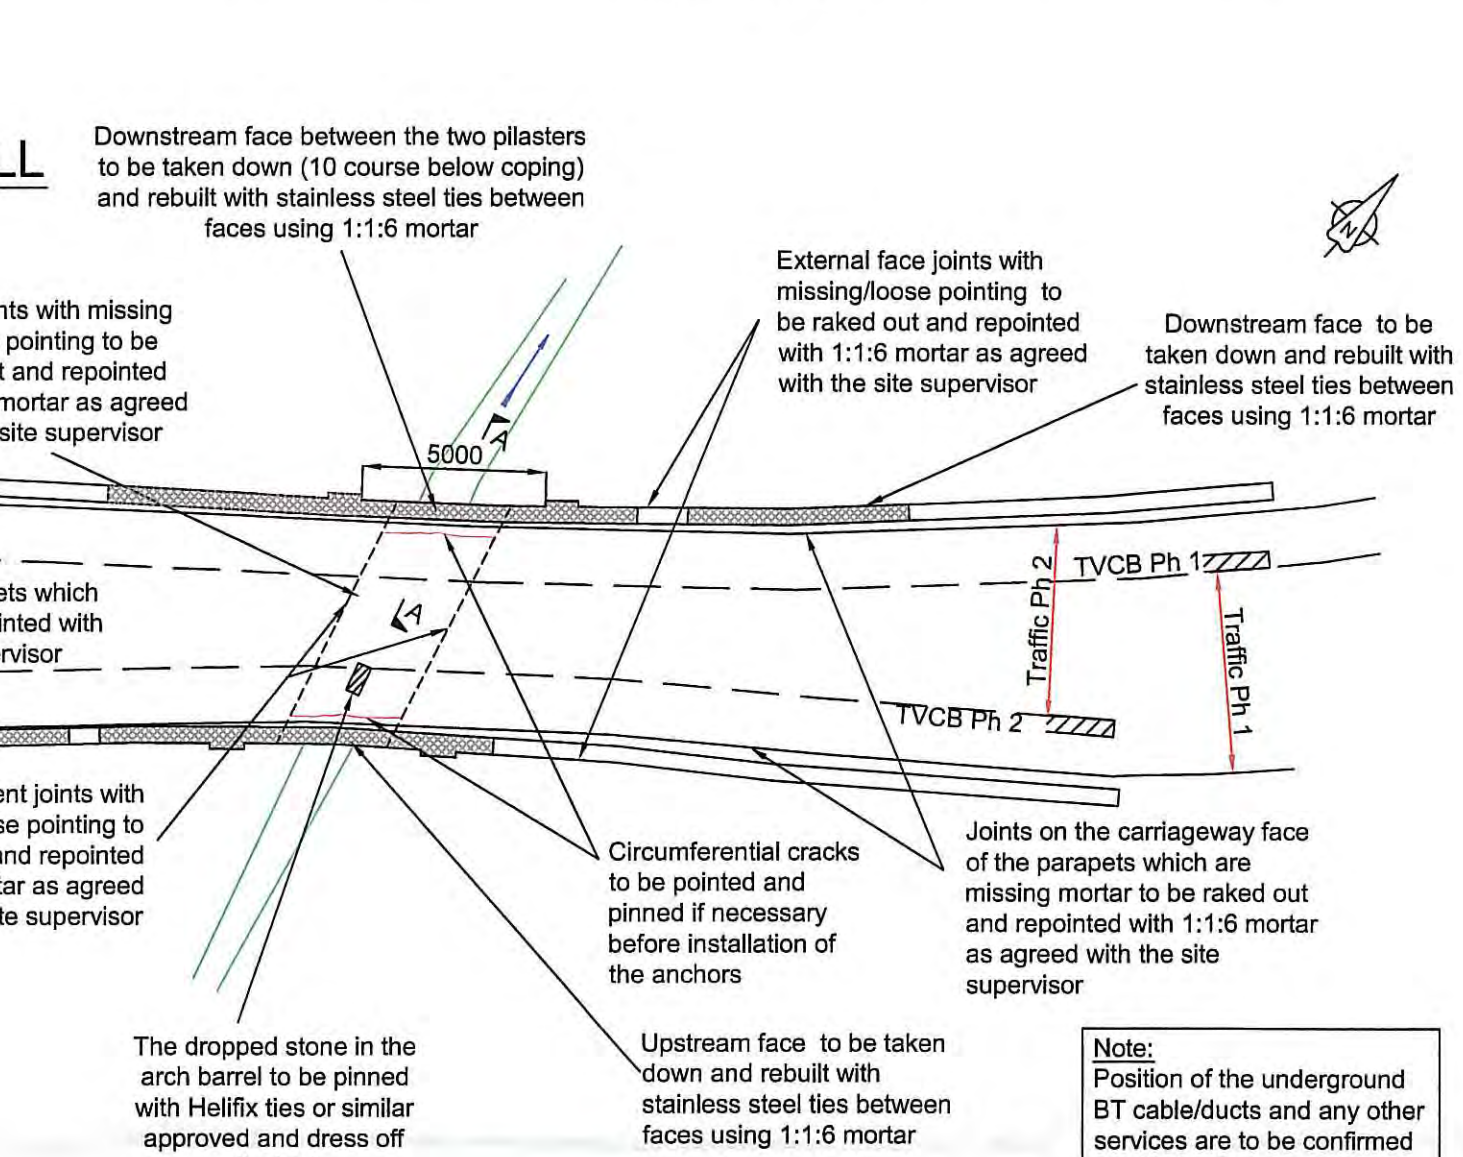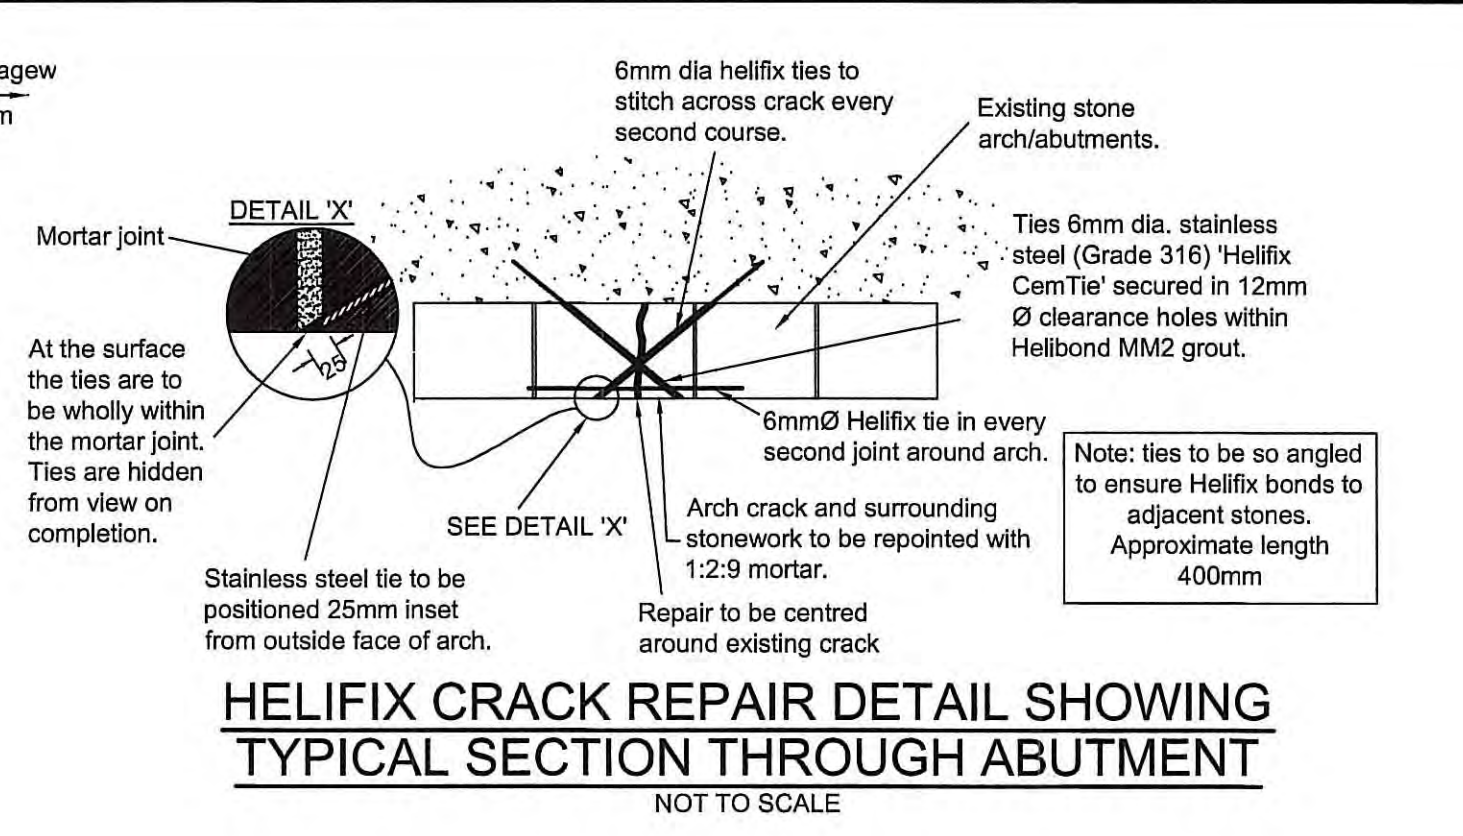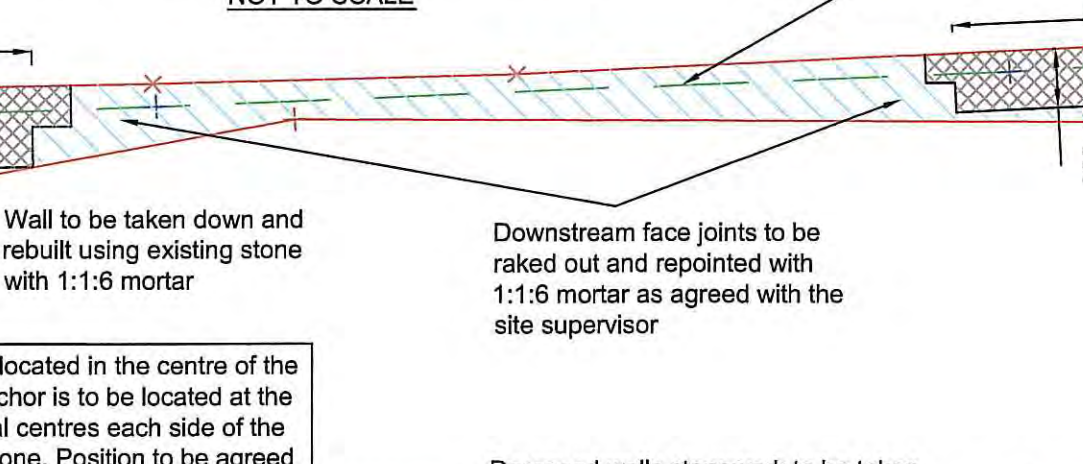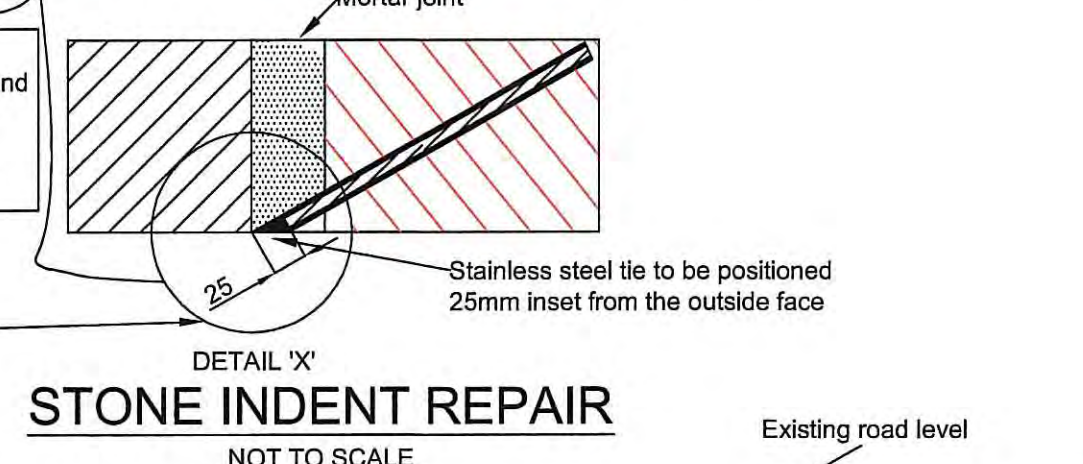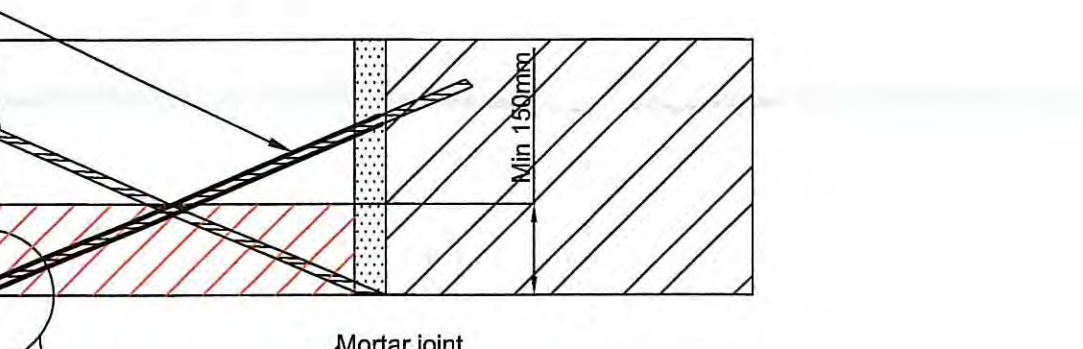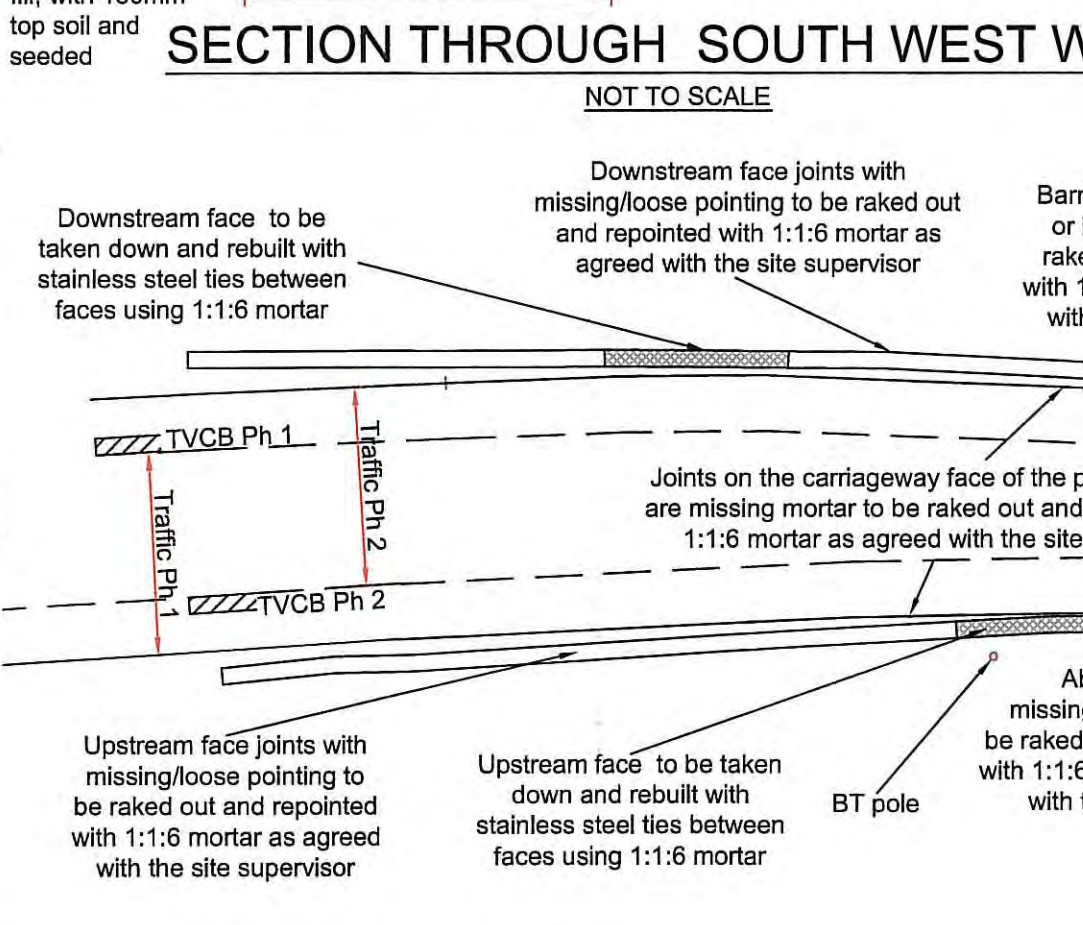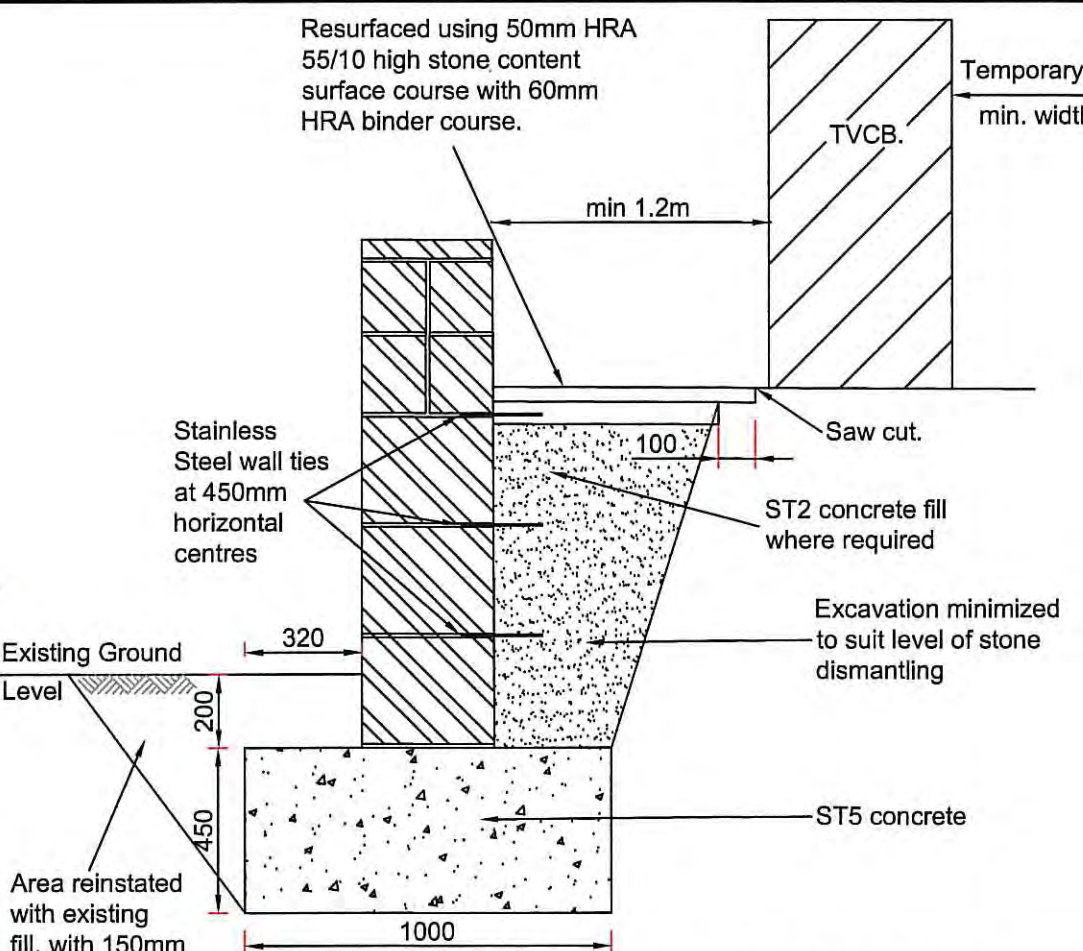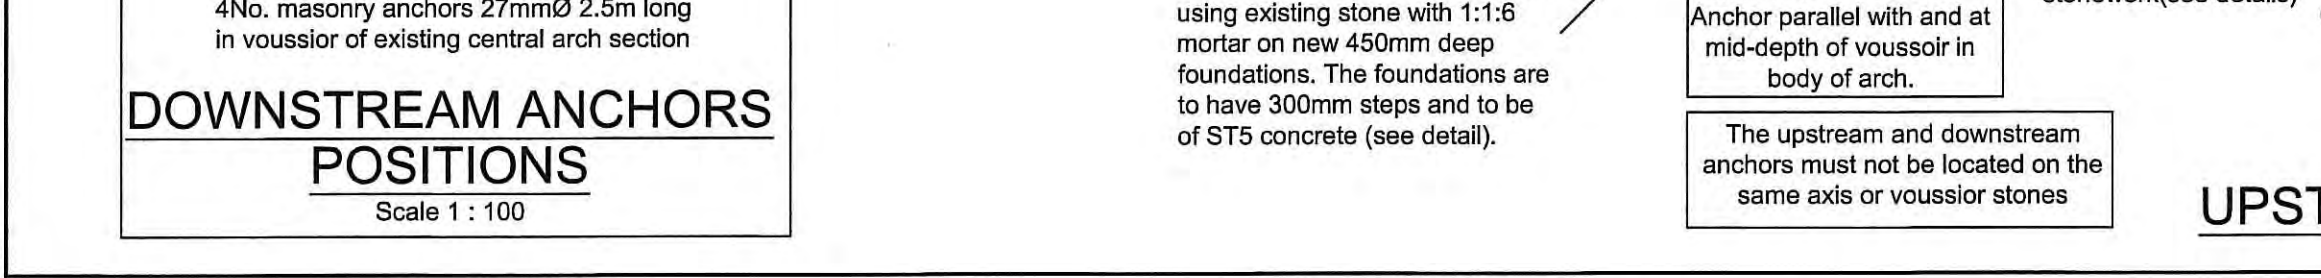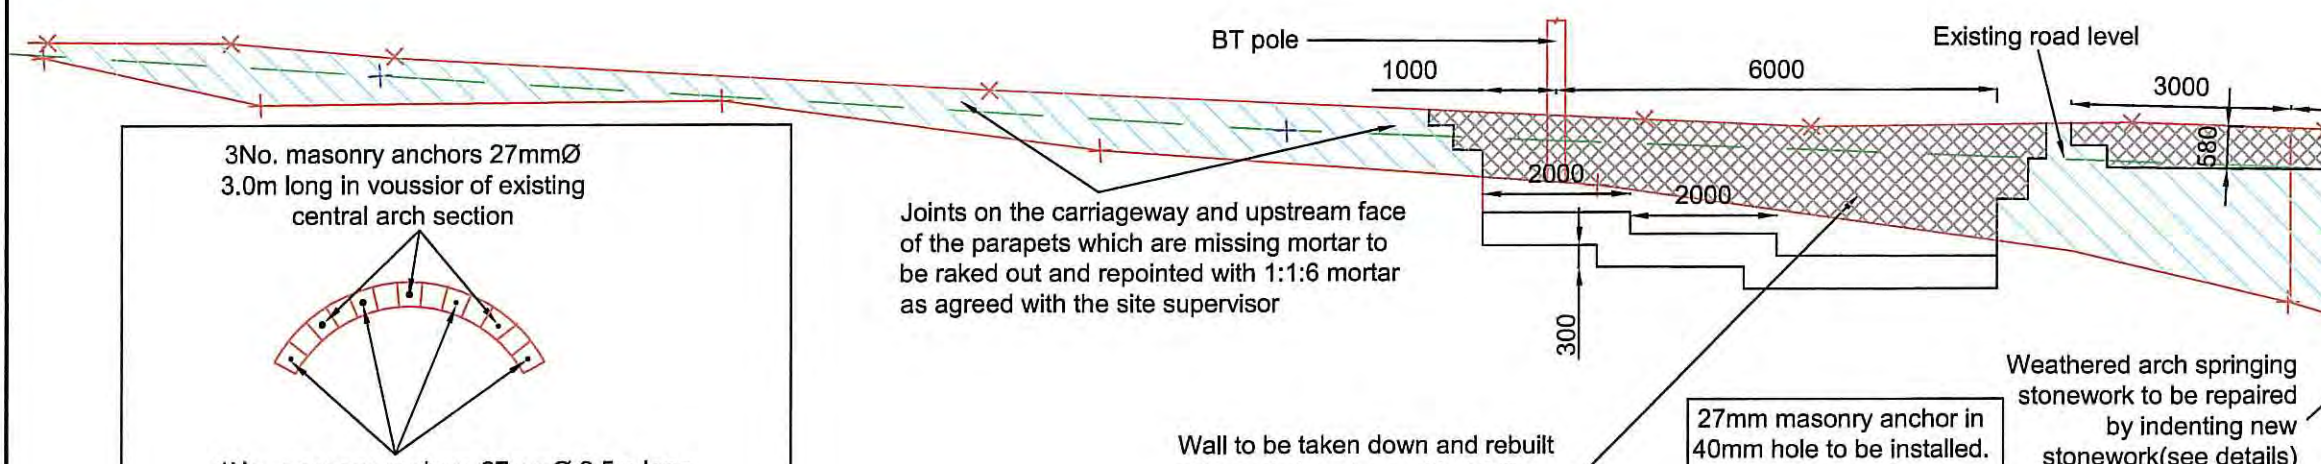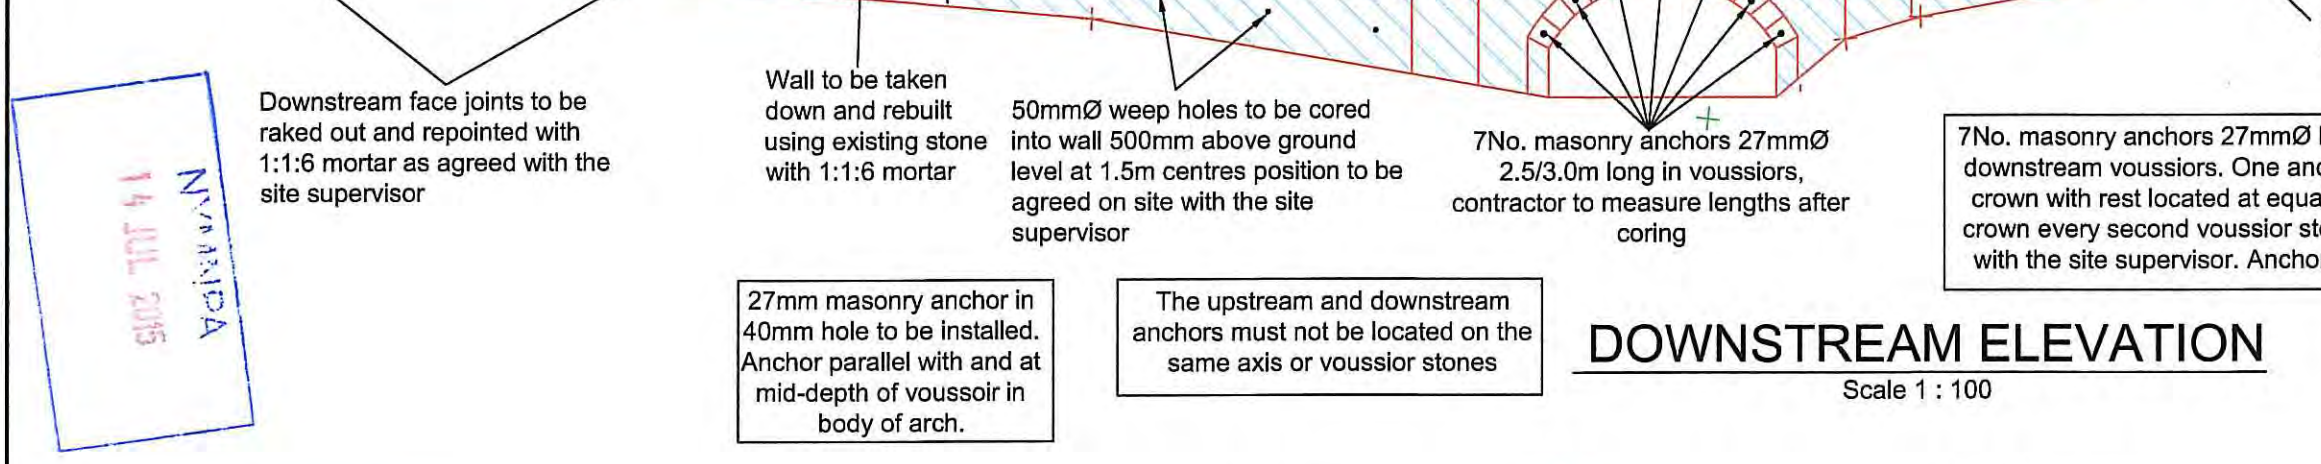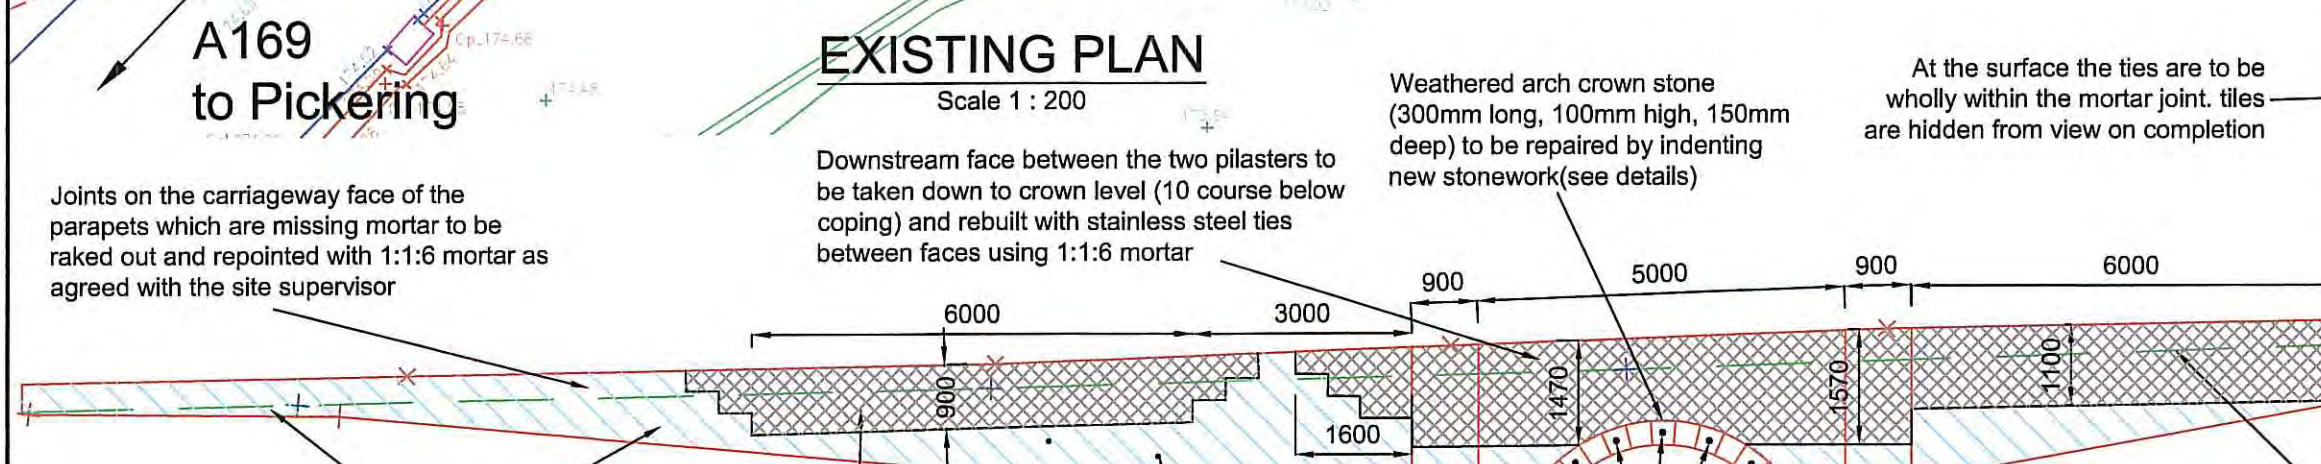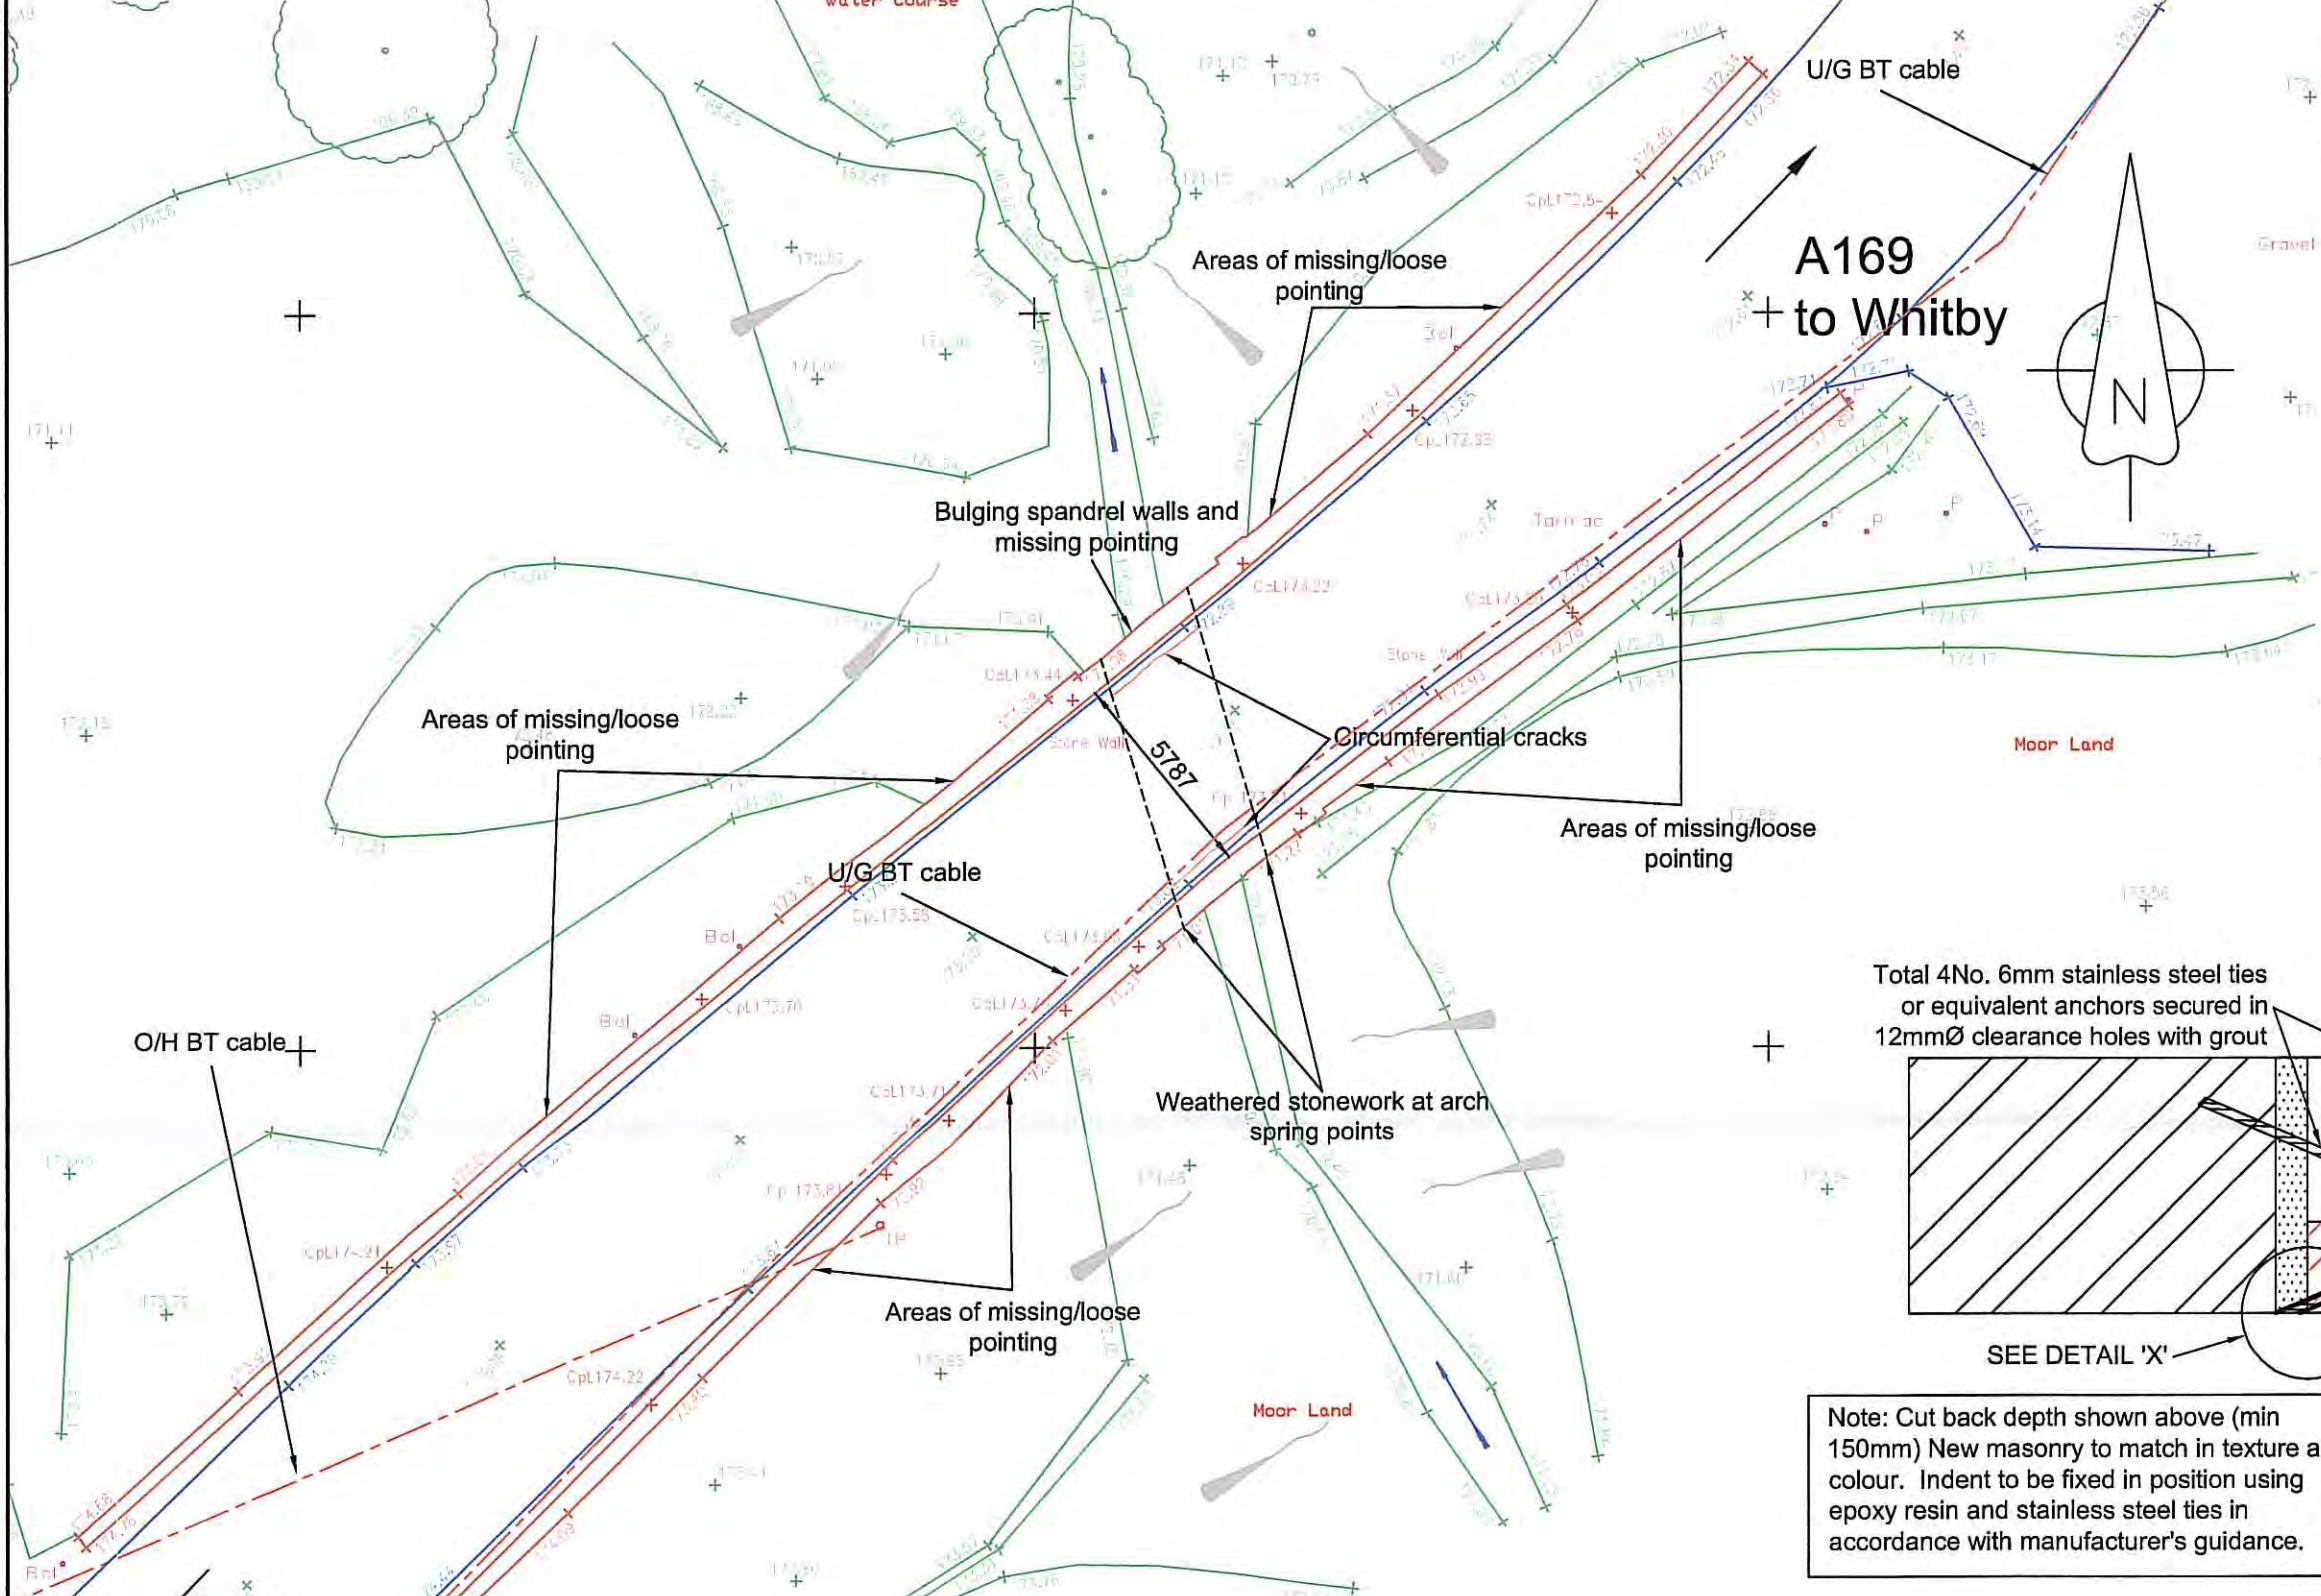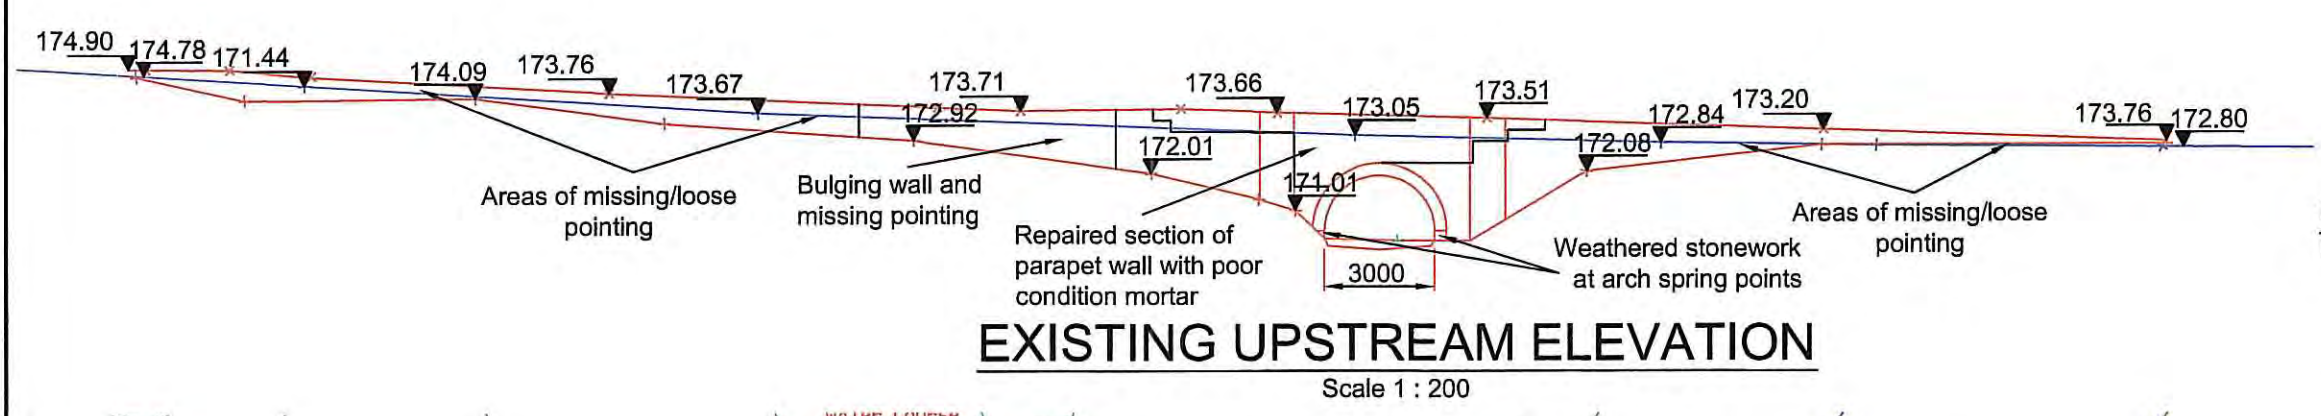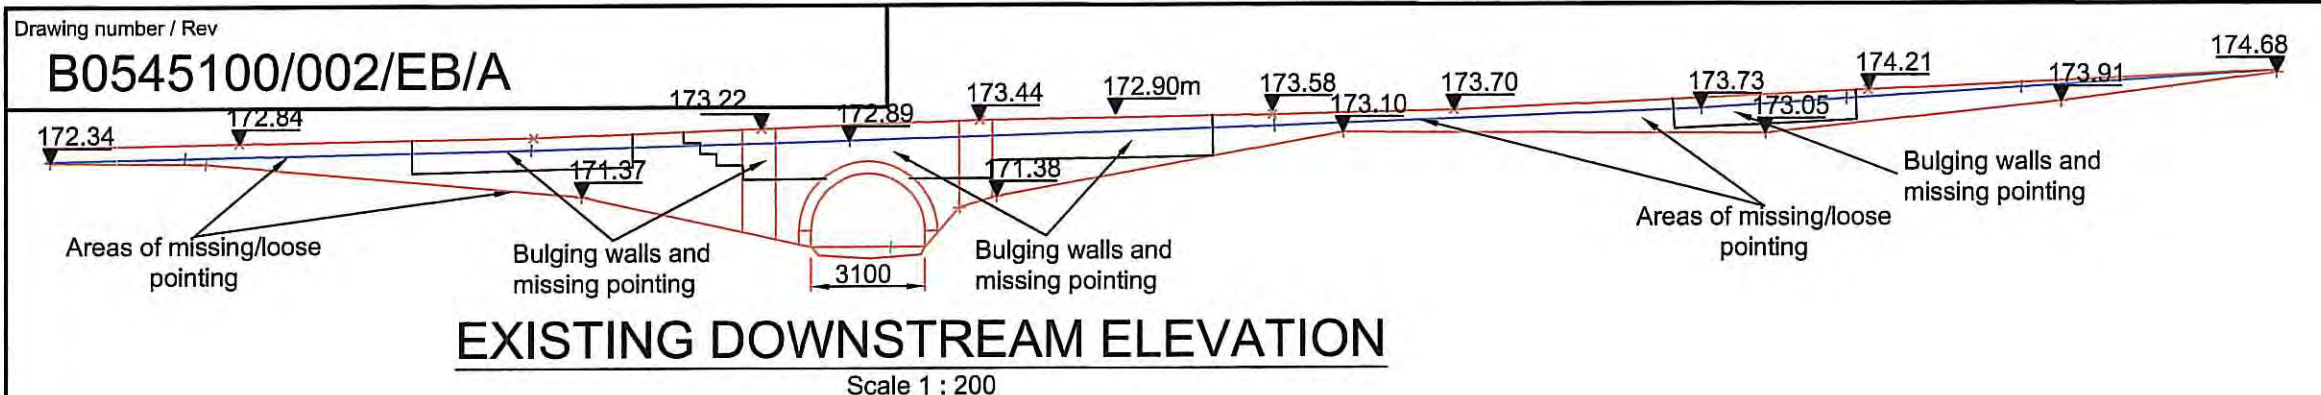

- NOTES:**
- All levels are in metres.
 - This drawing is to be read in conjunction with the AIP.
 - All dimensions are in millimetres.
 - The extent of masonry to be dismantled, repaired and rebuilt is to be agreed with the Supervisor prior to the commencement of the works. Ellerbeck North bridge is grade II listed and the works must be carried out to a high quality.
 - All loose and friable materials in joints to be repaired are to be raked out and joint faces cleaned by high pressure water jet. Joints to be pointed shall be raked out to a depth not less than the joint width nor 20mm. Mortar for pointing shall be a 1:1.6 (cement : lime : sharp sand) mix, except the arch barrel which should be pointed with a 1:2.9 (cement : lime : sharp sand) mix. The colour of sand in the mortar mixes shall be chosen to give a colour of mortar mix to match the existing and a textured finish is to be achieved on all pointing with a stiff brush once the mortar has started to harden. On the voussior stonework the pointing to be recessed by 2mm. For Ellerbeck North Bridge approval of the mortar by North York Moors NPA will be required.
 - The contractor is reminded that all temporary works withing the watercourse will require NYCC Flood Risk approval prior to commencement of the works.
 - Mortar for bedding stonework shall be 1:1.6 (cement : lime : sharp sand) mix.
 - No debris is to be allowed to enter the watercourse at any time.
 - The road is to remain open to vehicular and pedestrian traffic at all times and the works will be carried out with single-way working controlled by signals. Pedestrian access through the works will have to be provided throughout and it is suggested that this could be achieved by utilising a temporary access scaffold to both the upstream and downstream sides of the bridge or by refuges within the line TVCB's
 - A level survey of the existing surfacing is to be carried out by the Contractor and agreed with the Supervisor prior to commencement of the Works.
 - The location of all services is indicative, the exact location is to be confirmed by the contractor prior to any excavation or works.
 - Any stone that is required to complete the works will match the existing. For Ellerbeck North Bridge approval of the stone by North York Moors NPA will be required.
 - The extent of the repair is as shown on the drawing. Any replacement stone shall match the existing stones for size, colour, texture, strength, type and surface finish in accordance with the Specification.
 - Masonry fixings and ties to be stainless steel.
 - All accesses are to remain clear unless the Contractor has sought permission from the relevant landowners.
 - All dimensions must be checked on site by the contractor before works start and the site supervisor must be informed of any errors.
 - If bats are found, work is to stop immediately and NYCC Ecologist will instruct.
 - Fen Bog nature reserve (Yorkshire Wildlife Trust) and Newtondale SSSI are located west of the bridges. The bridges are located within the North York Moors National Park
 - H & S Risks
 - Working in, near and above water
 - Working at heights
 - Traffic (Vehicular and Pedestrians)
 - Lifting operations
 - Using cementitious materials (Concrete)
 - Using hot materials (Asphalt and road markings)

North Yorkshire County Council
 highways
 NORTH YORKSHIRE

JACOBS
 Northallerton Office, Morgan House, Mount View, Northallerton, North Yorkshire, DL6 2YD

Client
 Partnering with -
 North Yorkshire County Council

Project
 Ellerbeck Bridges
 Maintenance
 (Structure No's. 55 & 56)

Drawing title
**General Arrangement
 Ellerbeck South**

Drawing status		TENDER	
Scale	@ A1	DO NOT SCALE	
Jacobs No.	B0545100		
Client no.			

Drawing number
B0545100/002/EB

Rev
A

This drawing is not to be used in whole or part other than for the intended purpose and project as defined on this drawing. Refer to the contract for full terms and conditions.

AMENDED
 Notes

\N\AL\FLOZ\Admin\B0545100 New Schemes (pre-Project No)\Ellerbeck - Drawings\TENDER\ELLERBECK Tender rev 1.dwg - 09/07/2015 14:22:35 - Ellerbeck South - simpson