


KEY TO PLAN

Red Line:	Existing low voltage overhead line to upgrade
Yellow Line:	Existing high voltage overhead line
Green Line:	Proposed underground cable

NYMNP
30 JAN 2014

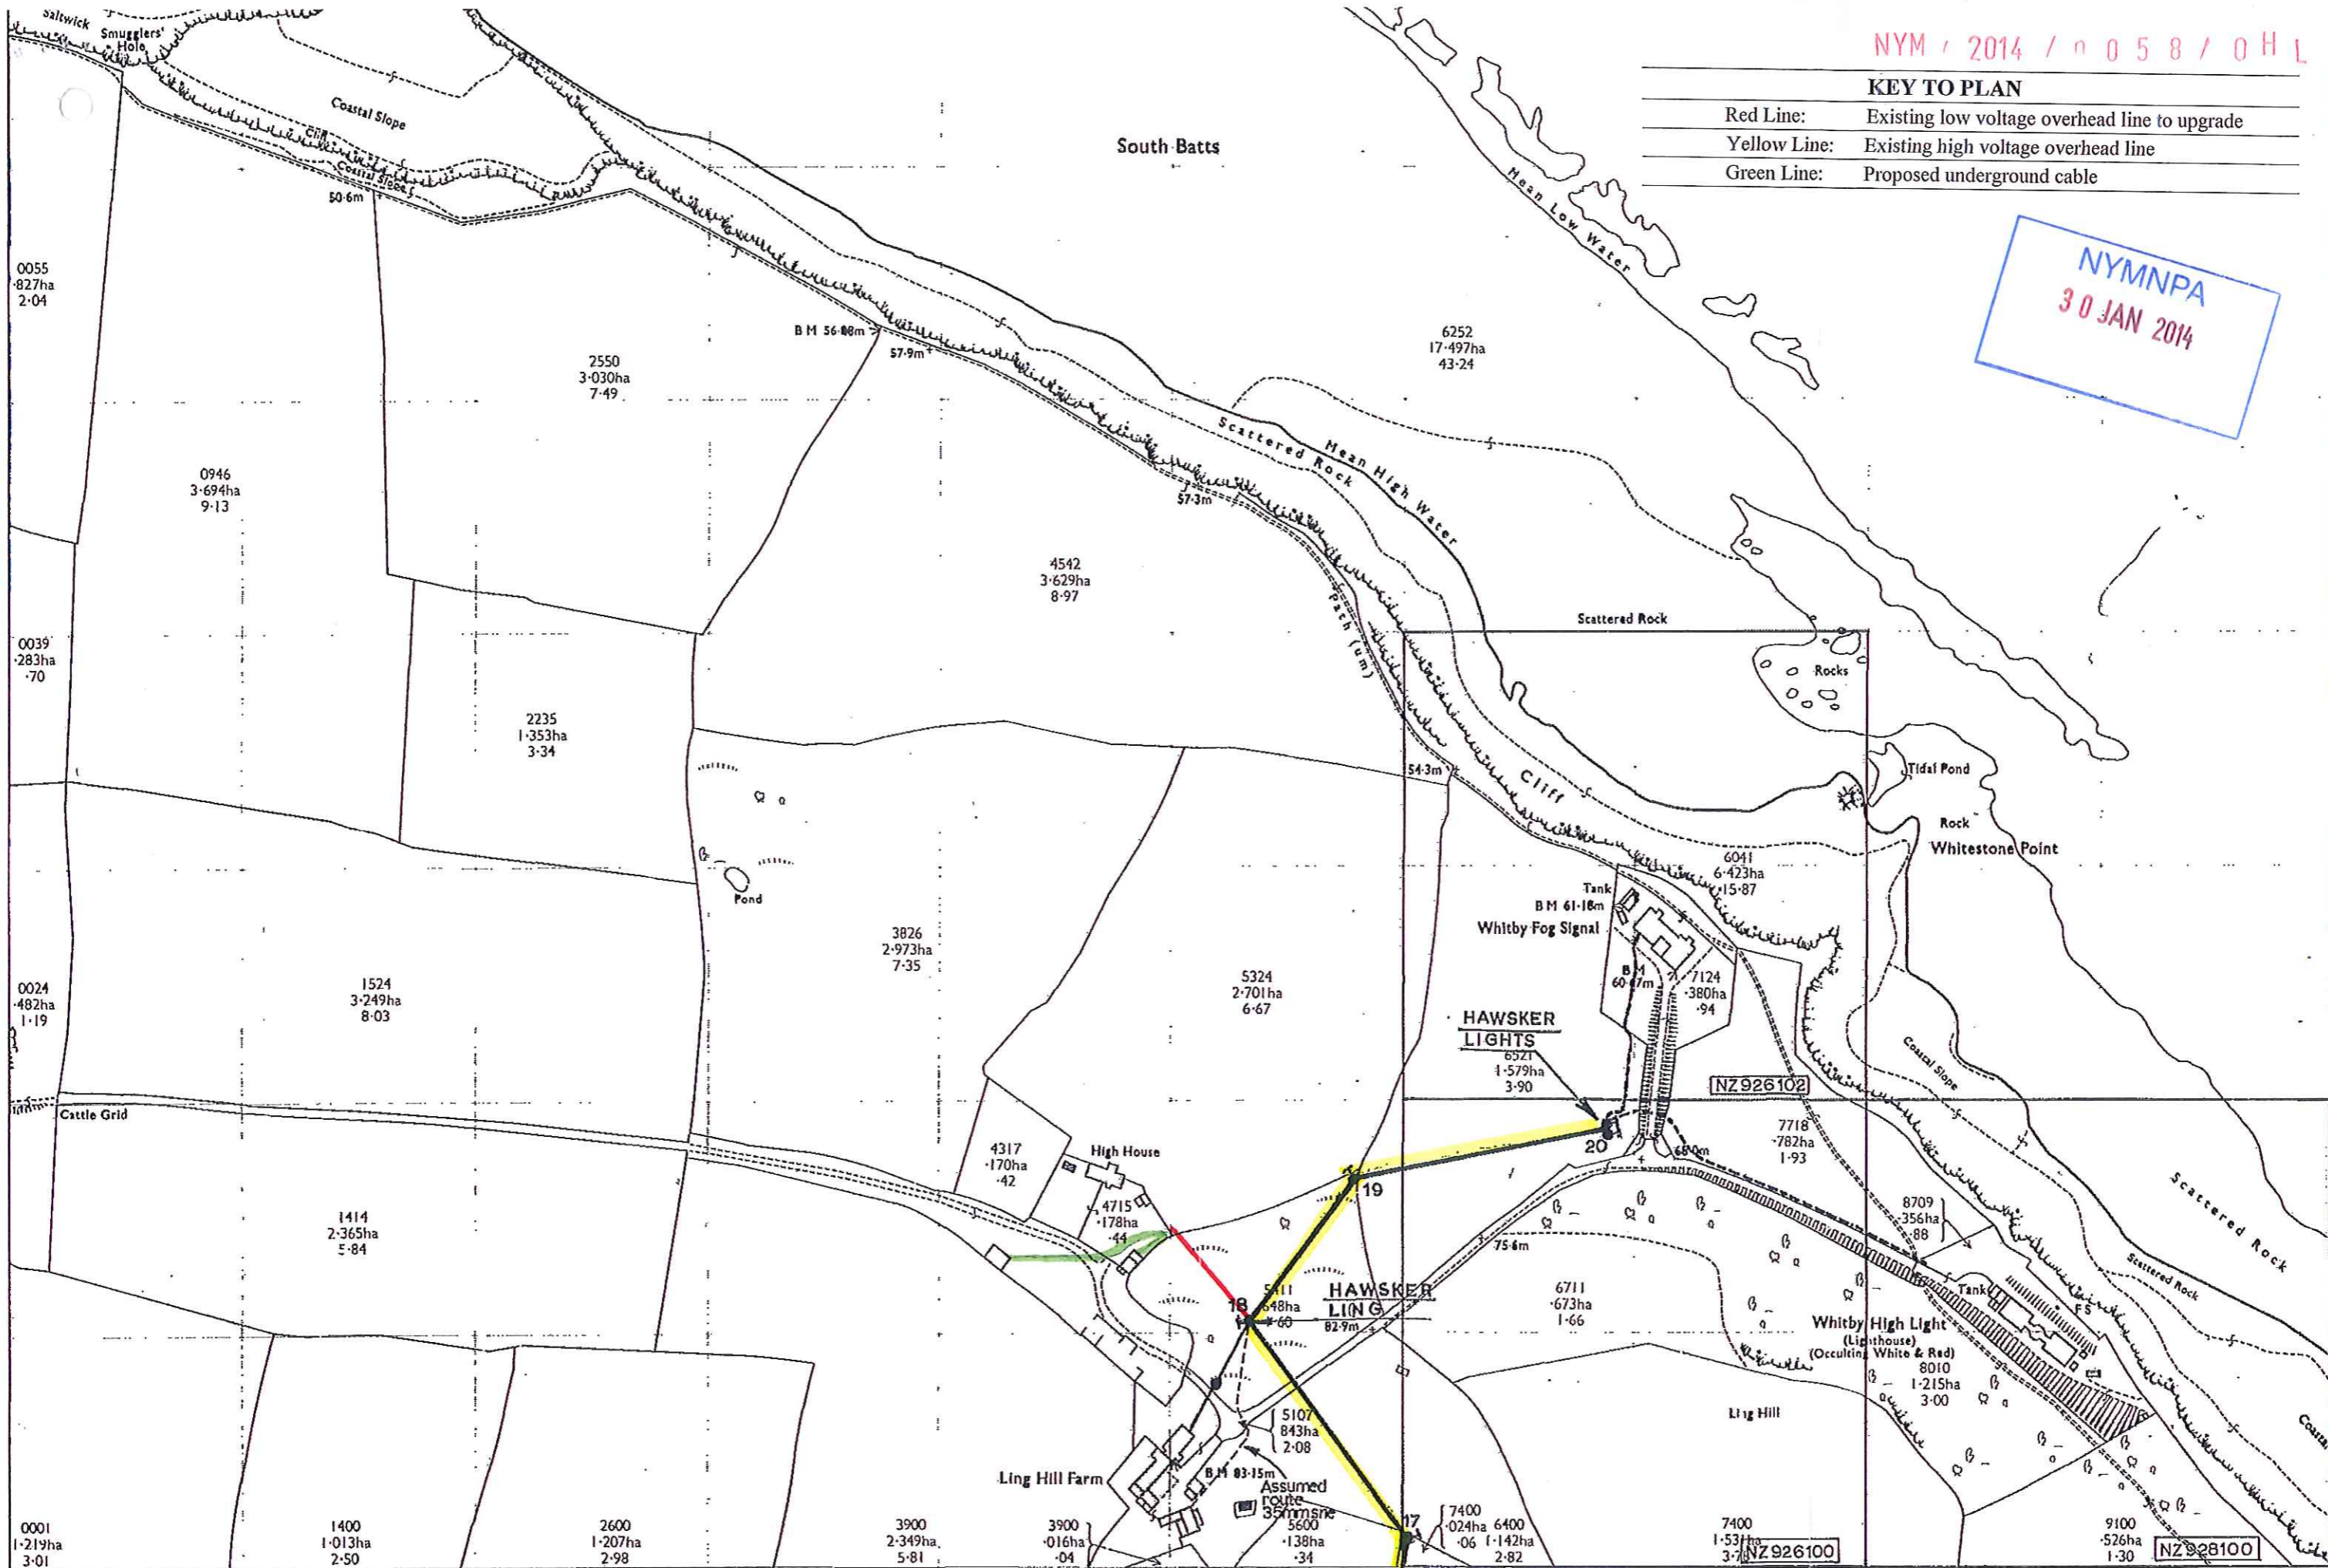

Scale: 1:2500
Map: NZ9210.TIF
Date: 29 Jan 2014



Dig 1. Use Plans
2. Use Cable Locator

Based upon or Reproduced from the Ordnance Survey Map with the sanction of HM Stationery Office. CROWN COPYRIGHT RESERVED. Unauthorised reproduction infringes Crown Copyright Northern Powergrid Holdings Company, Lloyds Court, 78, Grey Street, Newcastle Upon Tyne, NE1 6AE

ELECTRIC CABLES AND/OR OVERHEAD LINE INFORMATION SHOWN ON THE RECORD PLANS ARE TO BE USED IN ACCORDANCE WITH THE HEALTH & SAFETY EXECUTIVE'S BOOKLET HS(G)47, "AVOIDING DANGER FROM UNDERGROUND SERVICES", AND GUIDANCE NOTE GS 6, "AVOIDANCE OF DANGER FROM OVERHEAD ELECTRIC LINES". RECORD PLANS DO NOT ALWAYS SHOW OUT OF COMMISSION CABLES OR SERVICE CABLES FROM NORTHERN POWERGRID'S MAINS TO ADJOINING OR CROSS ROAD PROPERTIES. PLANS DO NOT SHOW LOCAL AUTHORITY OWNED PUBLIC LIGHTING OR SIGN CABLES. THE INFORMATION IS PROVIDED AS A SERVICE BY NORTHERN POWERGRID AND DOES NOT IMPART ANY LEGAL OBLIGATION ON THEIR PART. PERSONS USING IT ARE REMINDED OF THEIR RESPONSIBILITY TO EXECUTE WORKS SAFELY TO AVOID DAMAGING NORTHERN POWERGRID'S APPARATUS. FURTHER ADVICE OR ASSISTANCE IS AVAILABLE FROM THE RECORDS INFORMATION CENTRE ON 0870 1600910 IN AN EMERGENCY OR OUTSIDE NORMAL HOURS CONTACT OUR CUSTOMER INFORMATION CENTRE ON 0845 0702703